
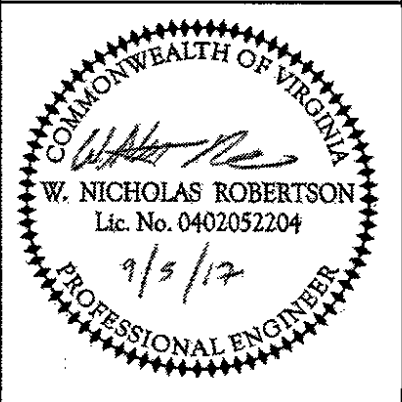


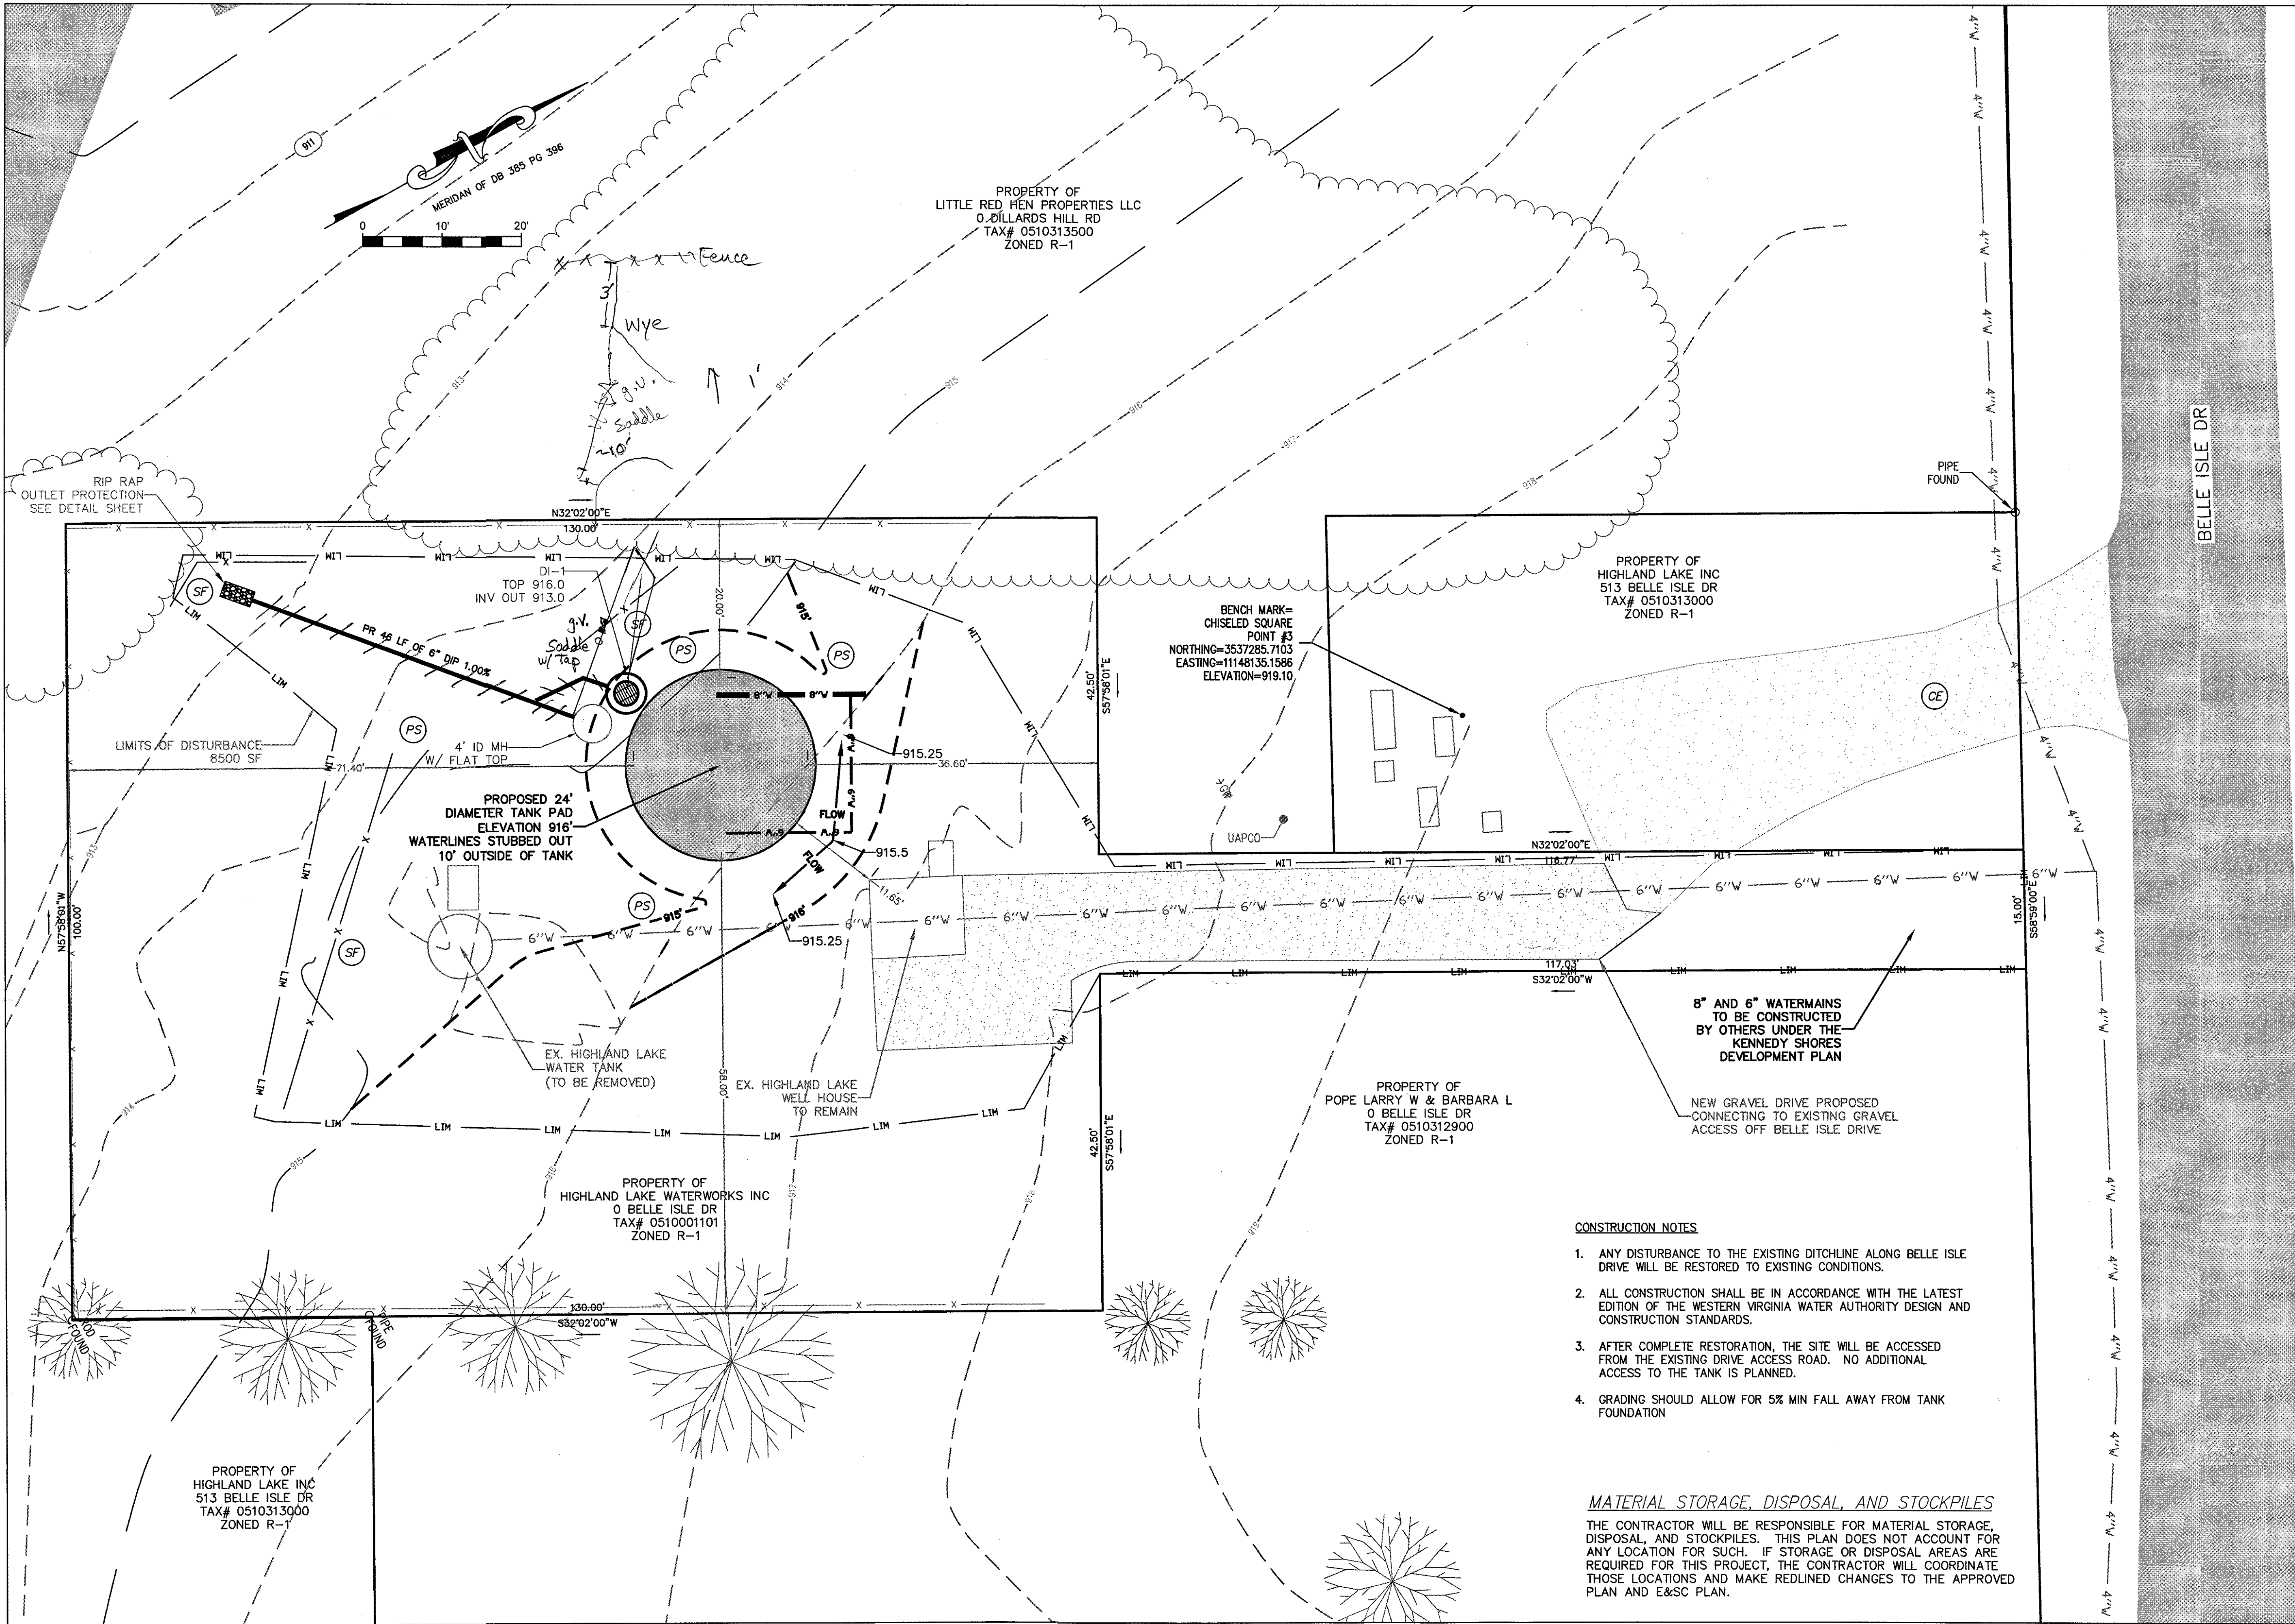

DILLARDS HILL WATER
STORAGE TANK
(200,000 GALLONS)
GRADING & DIMENSIONAL
PLAN

Rev	Description	Date	By

Designed: AAS
Drawn: AAS
Checked: WNR
Approved:
Date: 9/5/17
Project: