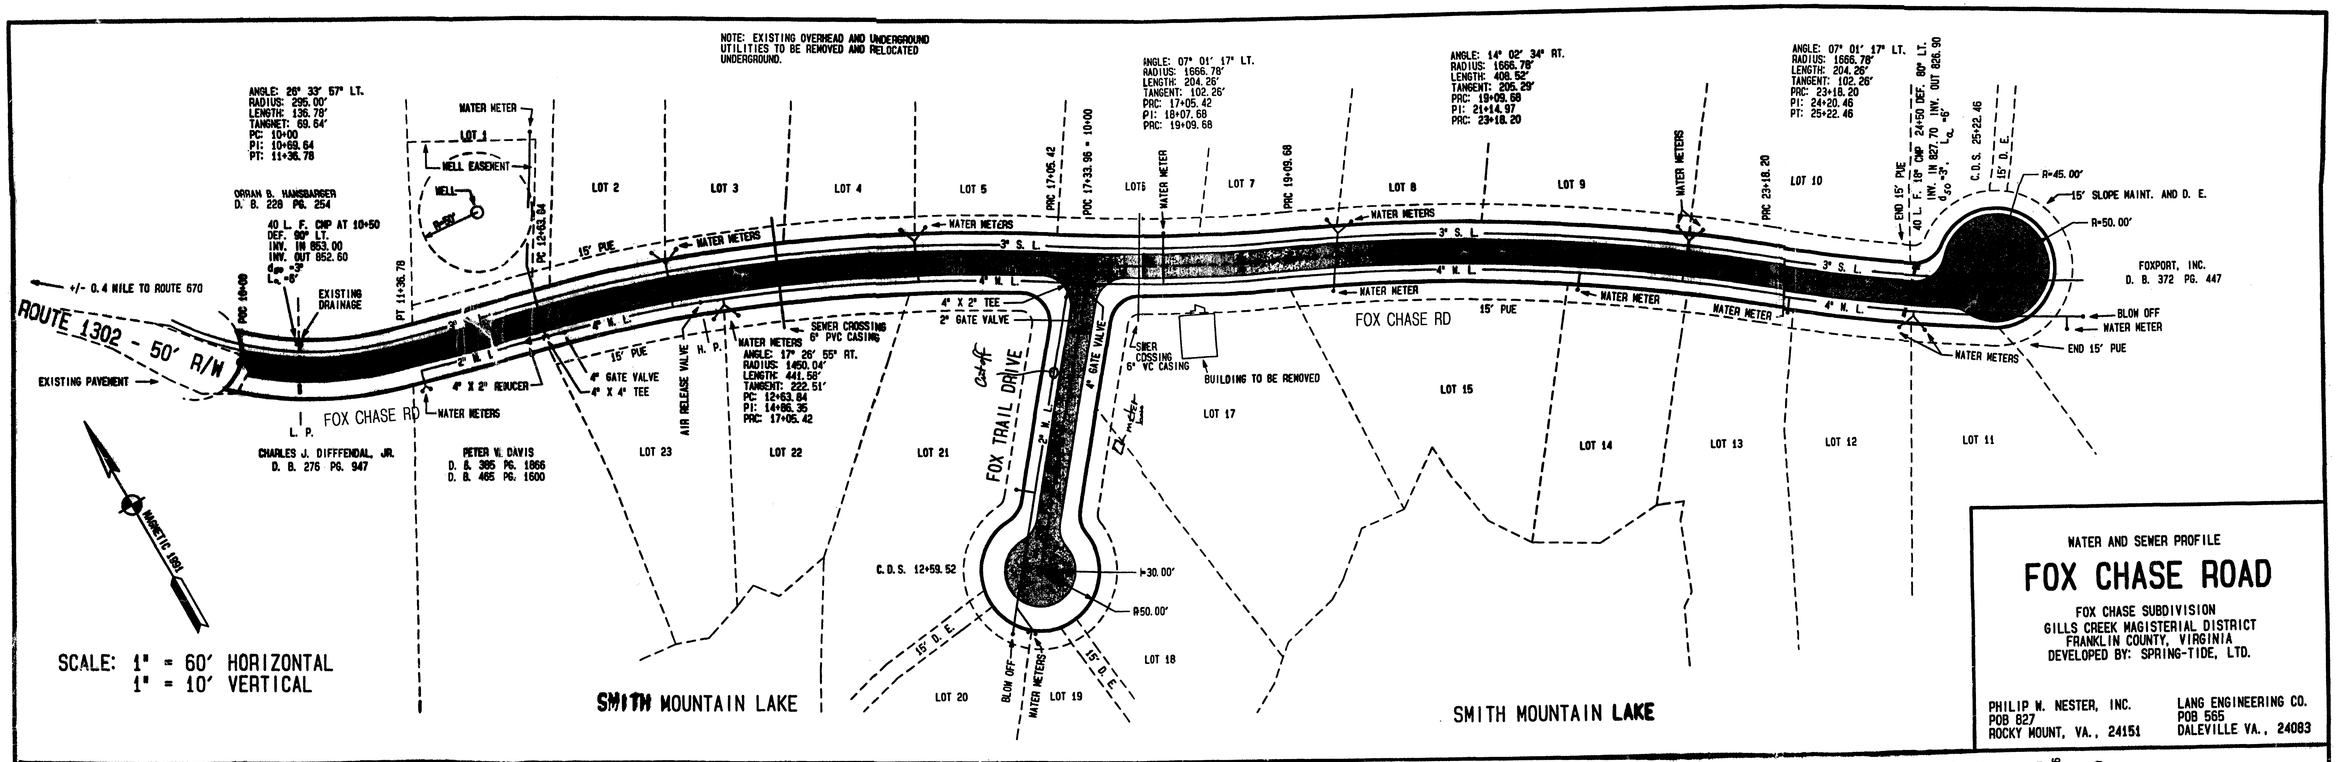

SCALE: 1" = 60' HORIZONTAL
1" = 10' VERTICAL

WATER AND SEWER PROFILE

FOX CHASE ROAD

FOX CHASE SUBDIVISION
GILLS CREEK MAGISTERIAL DISTRICT
FRANKLIN COUNTY, VIRGINIA
DEVELOPED BY: SPRING-TIDE, LTD.

PHILIP W. NESTER, INC.
POB 827
ROCKY MOUNT, VA., 24151

LANG ENGINEERING CO.
POB 565
DALEVILLE VA., 24083

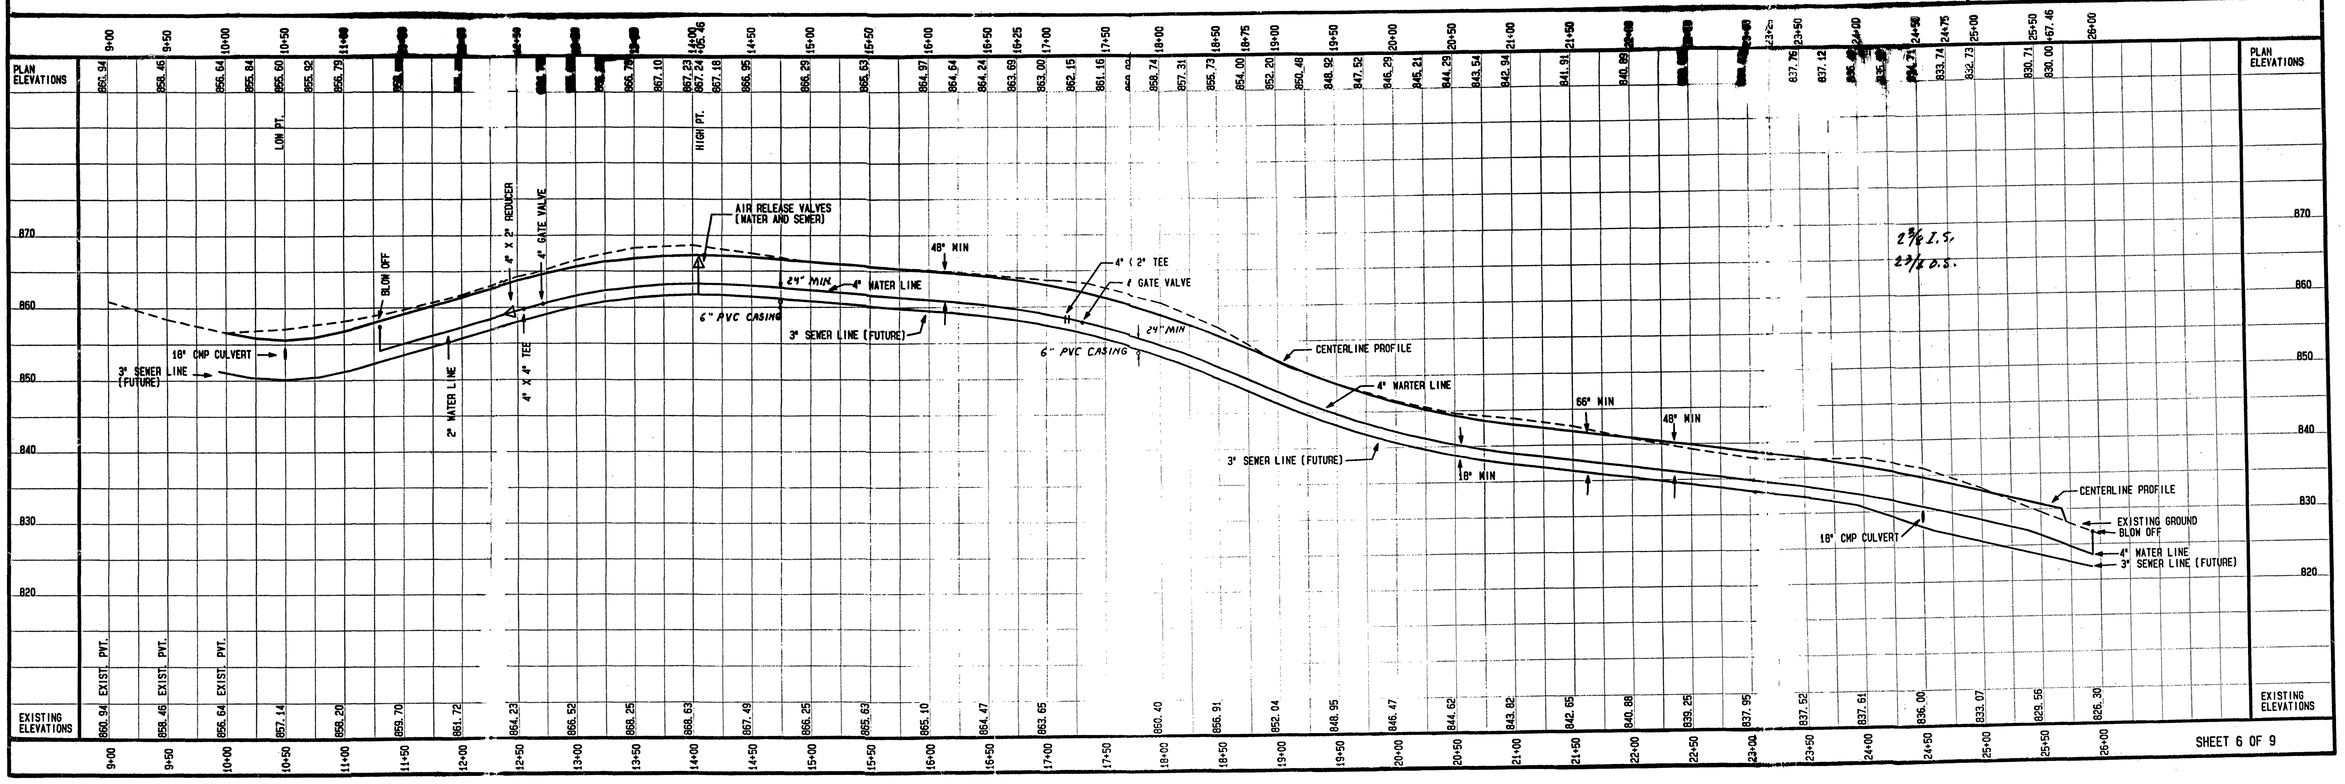

SHEET 6 OF 9