



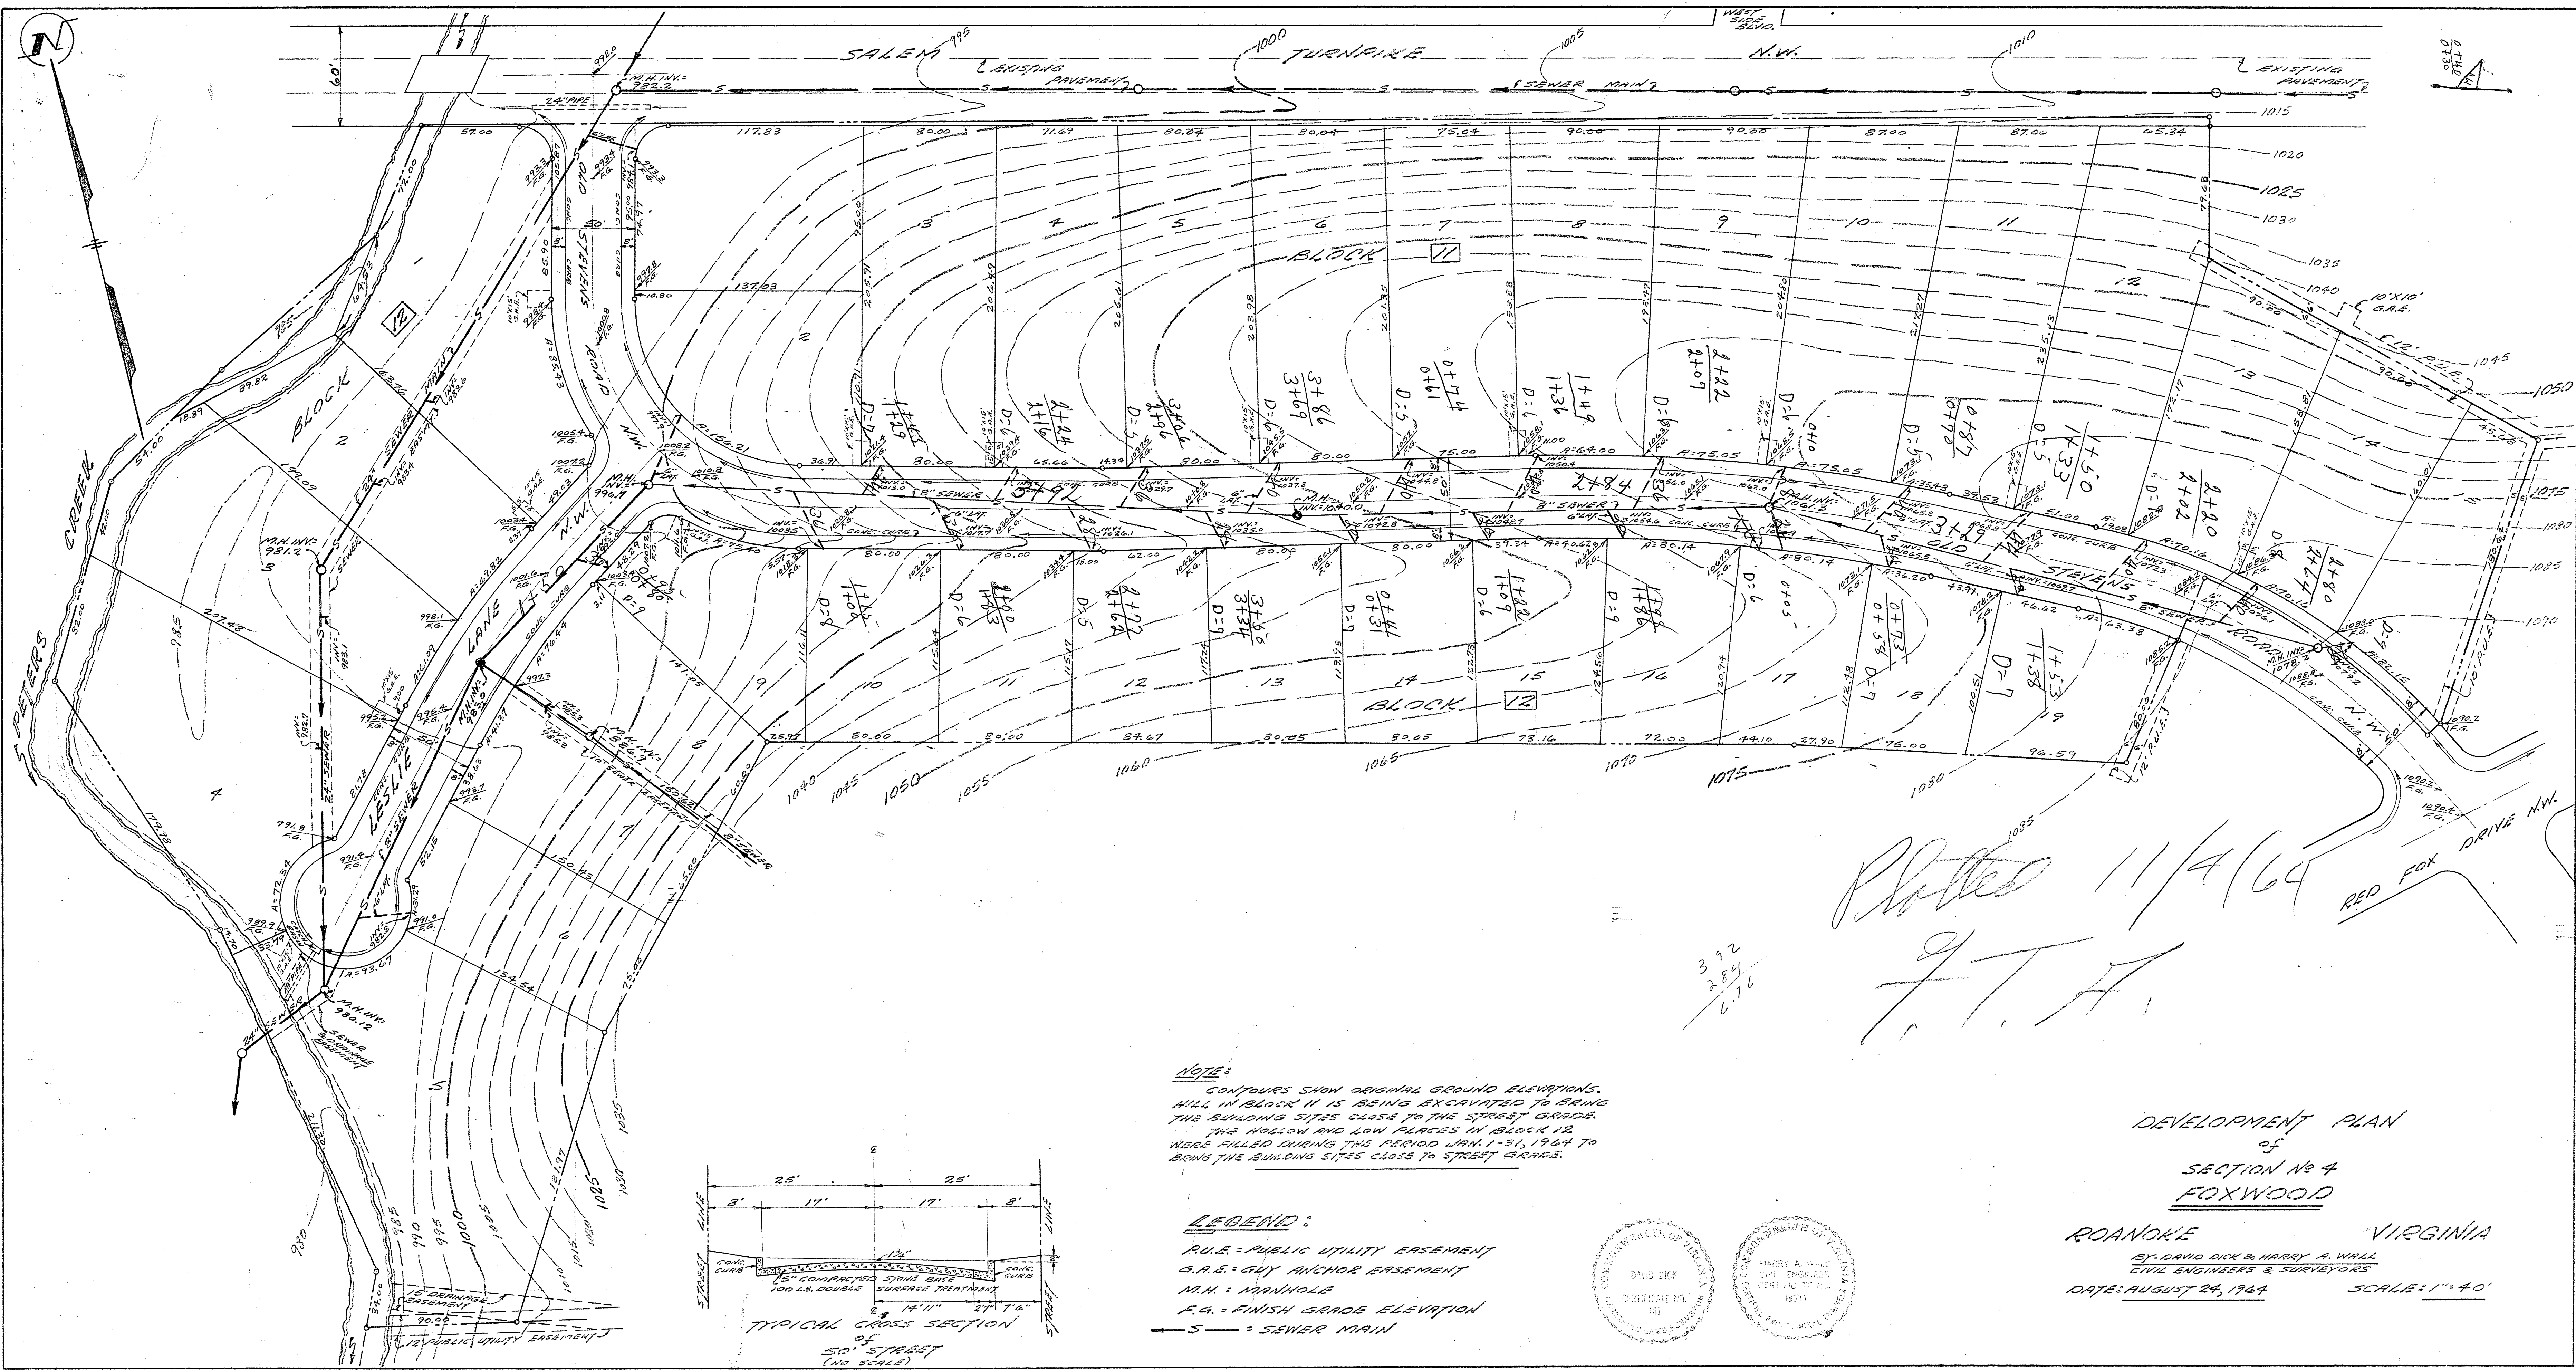

NOTE:
CONTOURS SHOW ORIGINAL GROUND ELEVATIONS.
HILL IN BLOCK 11 IS BEING EXCAVATED TO BRING
THE BUILDING SITES CLOSE TO THE STREET GRADE.
THE HOLLOW AND LOW PLACES IN BLOCK 12
WERE FILLED DURING THE PERIOD JAN. 1-31, 1964 TO
BRING THE BUILDING SITES CLOSE TO STREET GRADE.

- LEGEND:
P.U.E. = PUBLIC UTILITY EASEMENT
G.A.E. = GUY ANCHOR EASEMENT
M.H. = MANHOLE
F.G. = FINISH GRADE ELEVATION
S = SEWER MAIN

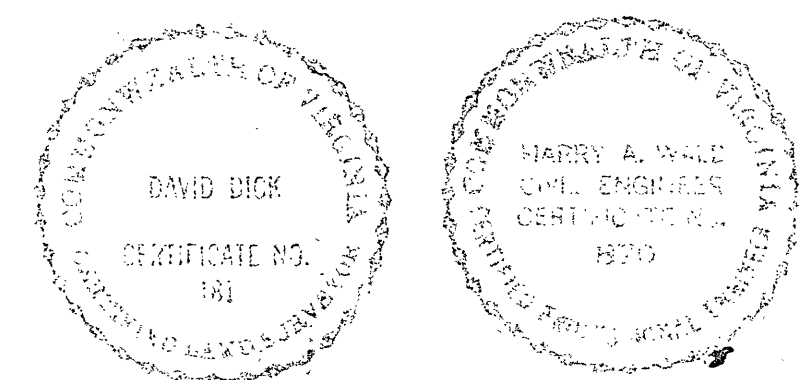

DEVELOPMENT PLAN
of
SECTION No. 4
FOXWOOD
ROANOKE VIRGINIA
BY DAVID DICK & HARRY A. WALL
CIVIL ENGINEERS & SURVEYORS
DATE: AUGUST 24, 1964 SCALE: 1" = 40'