


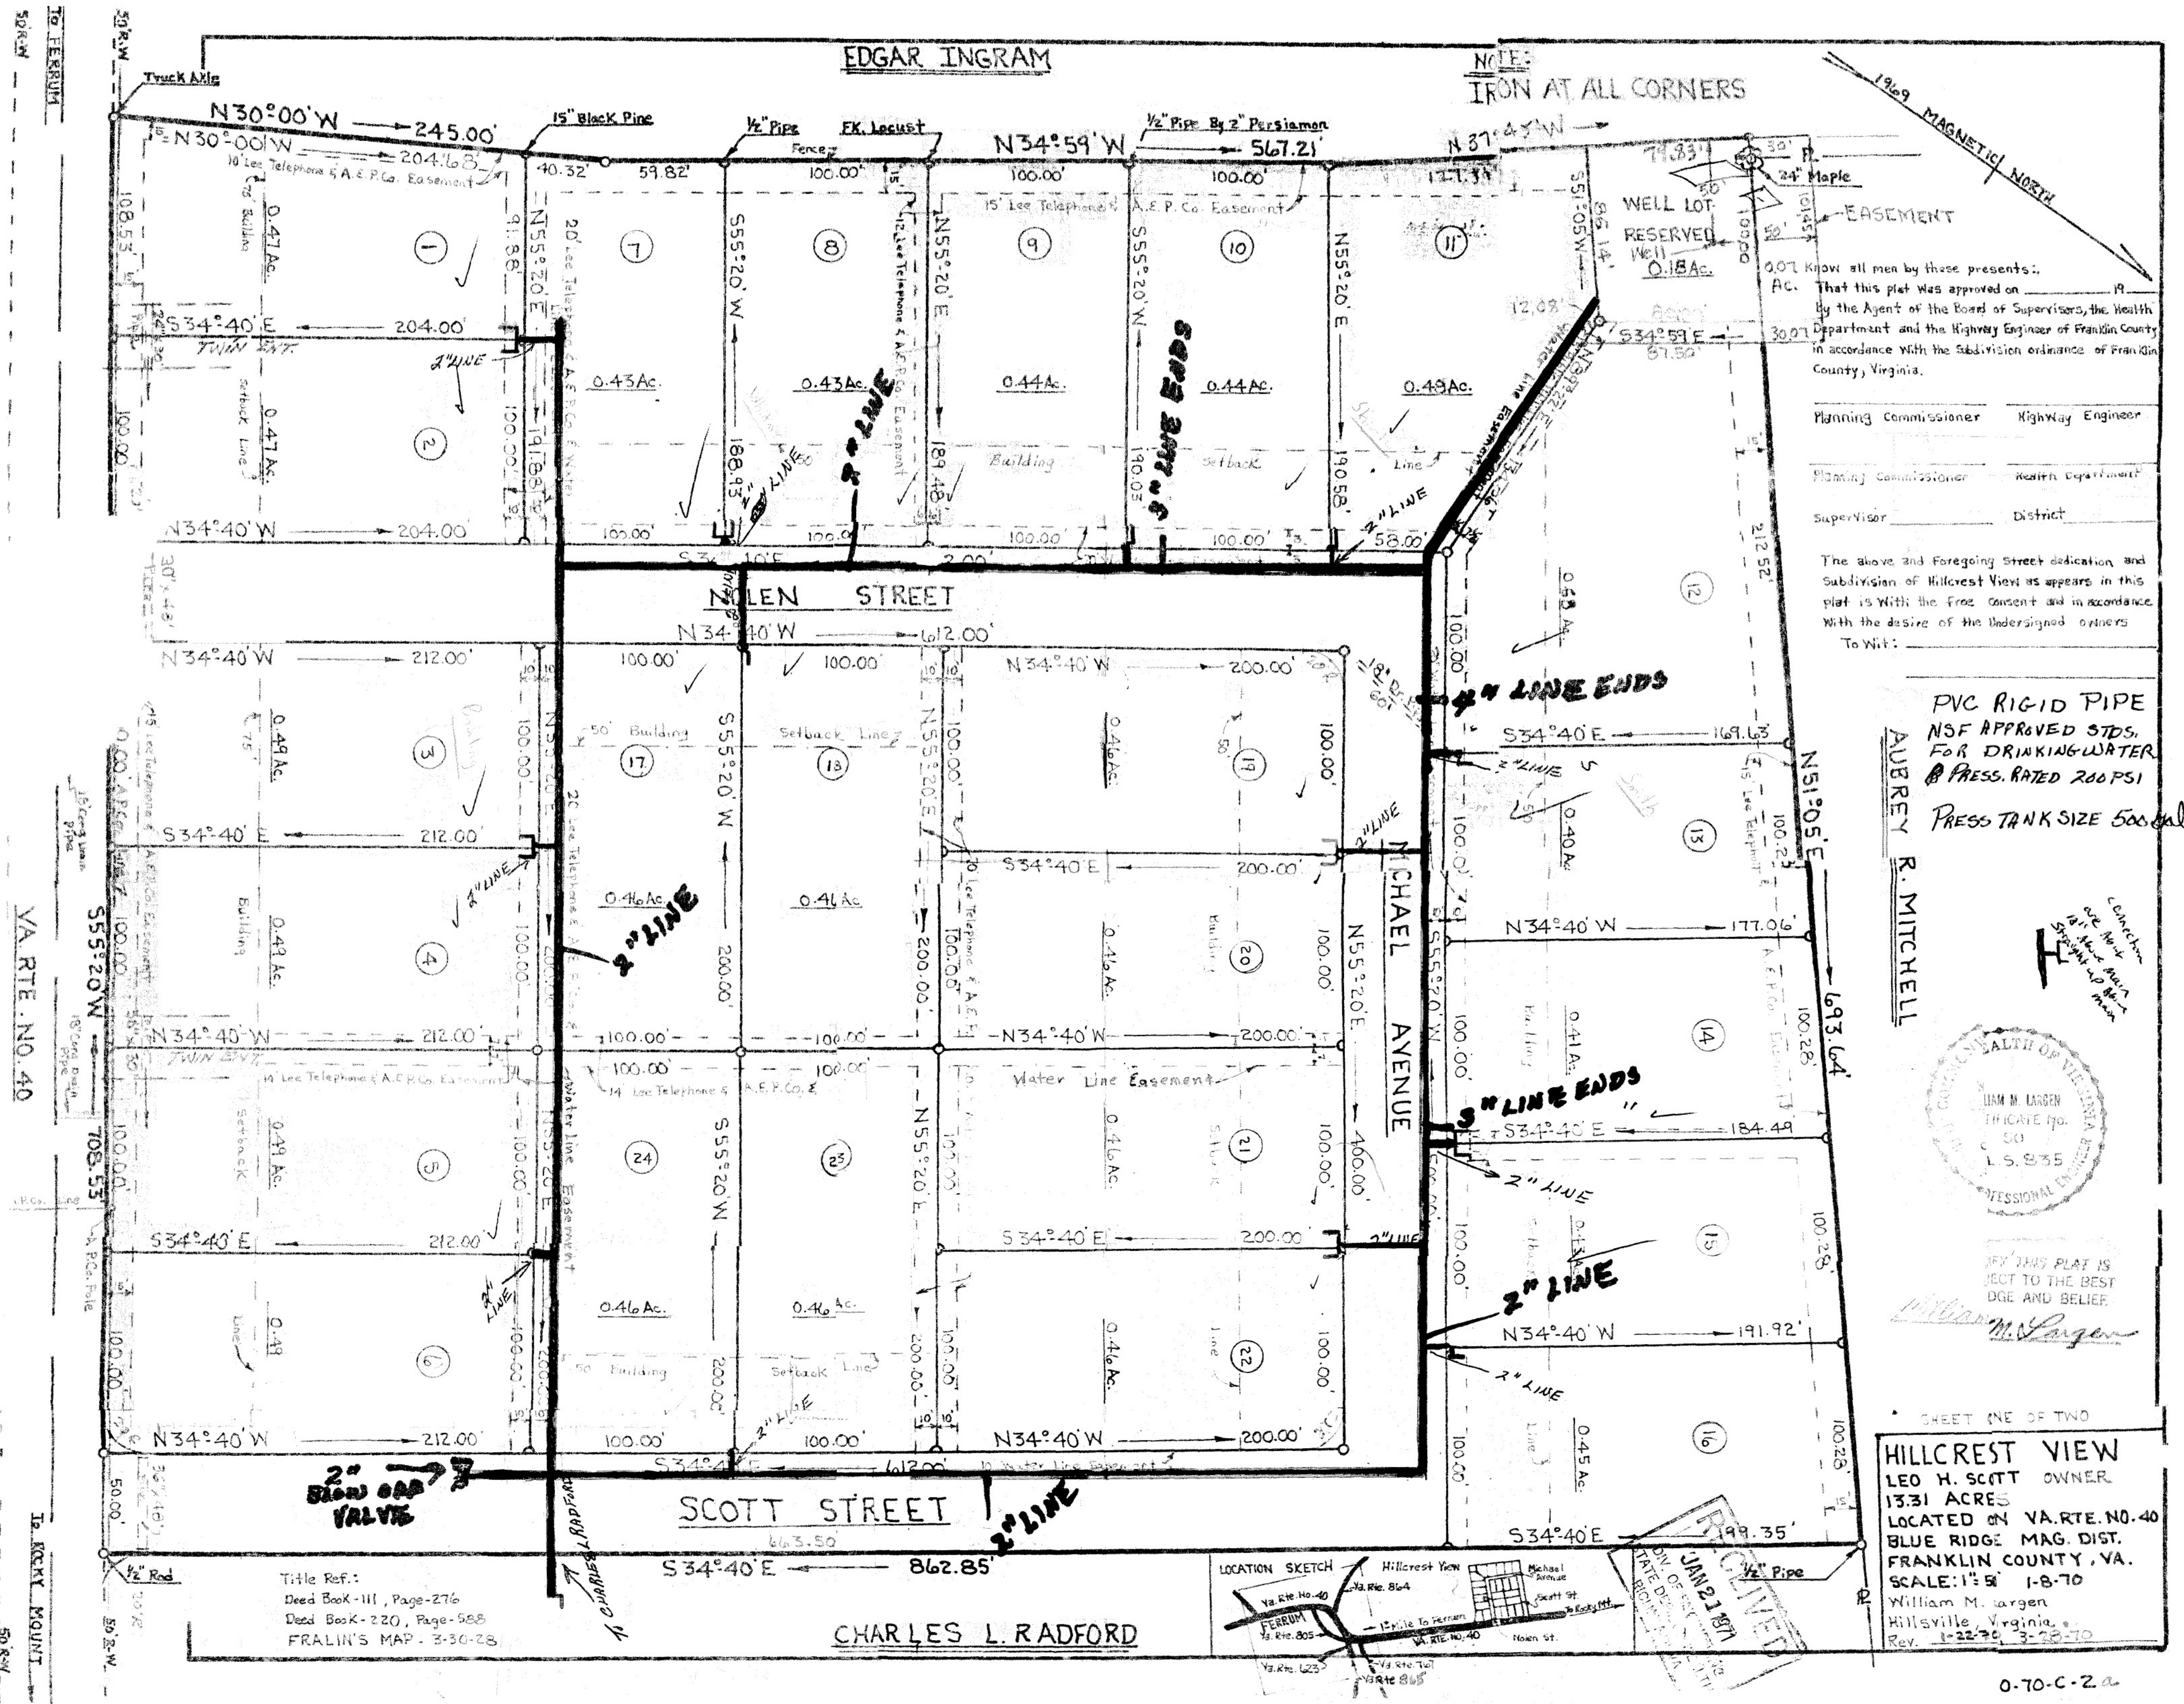

0-70-C-2a