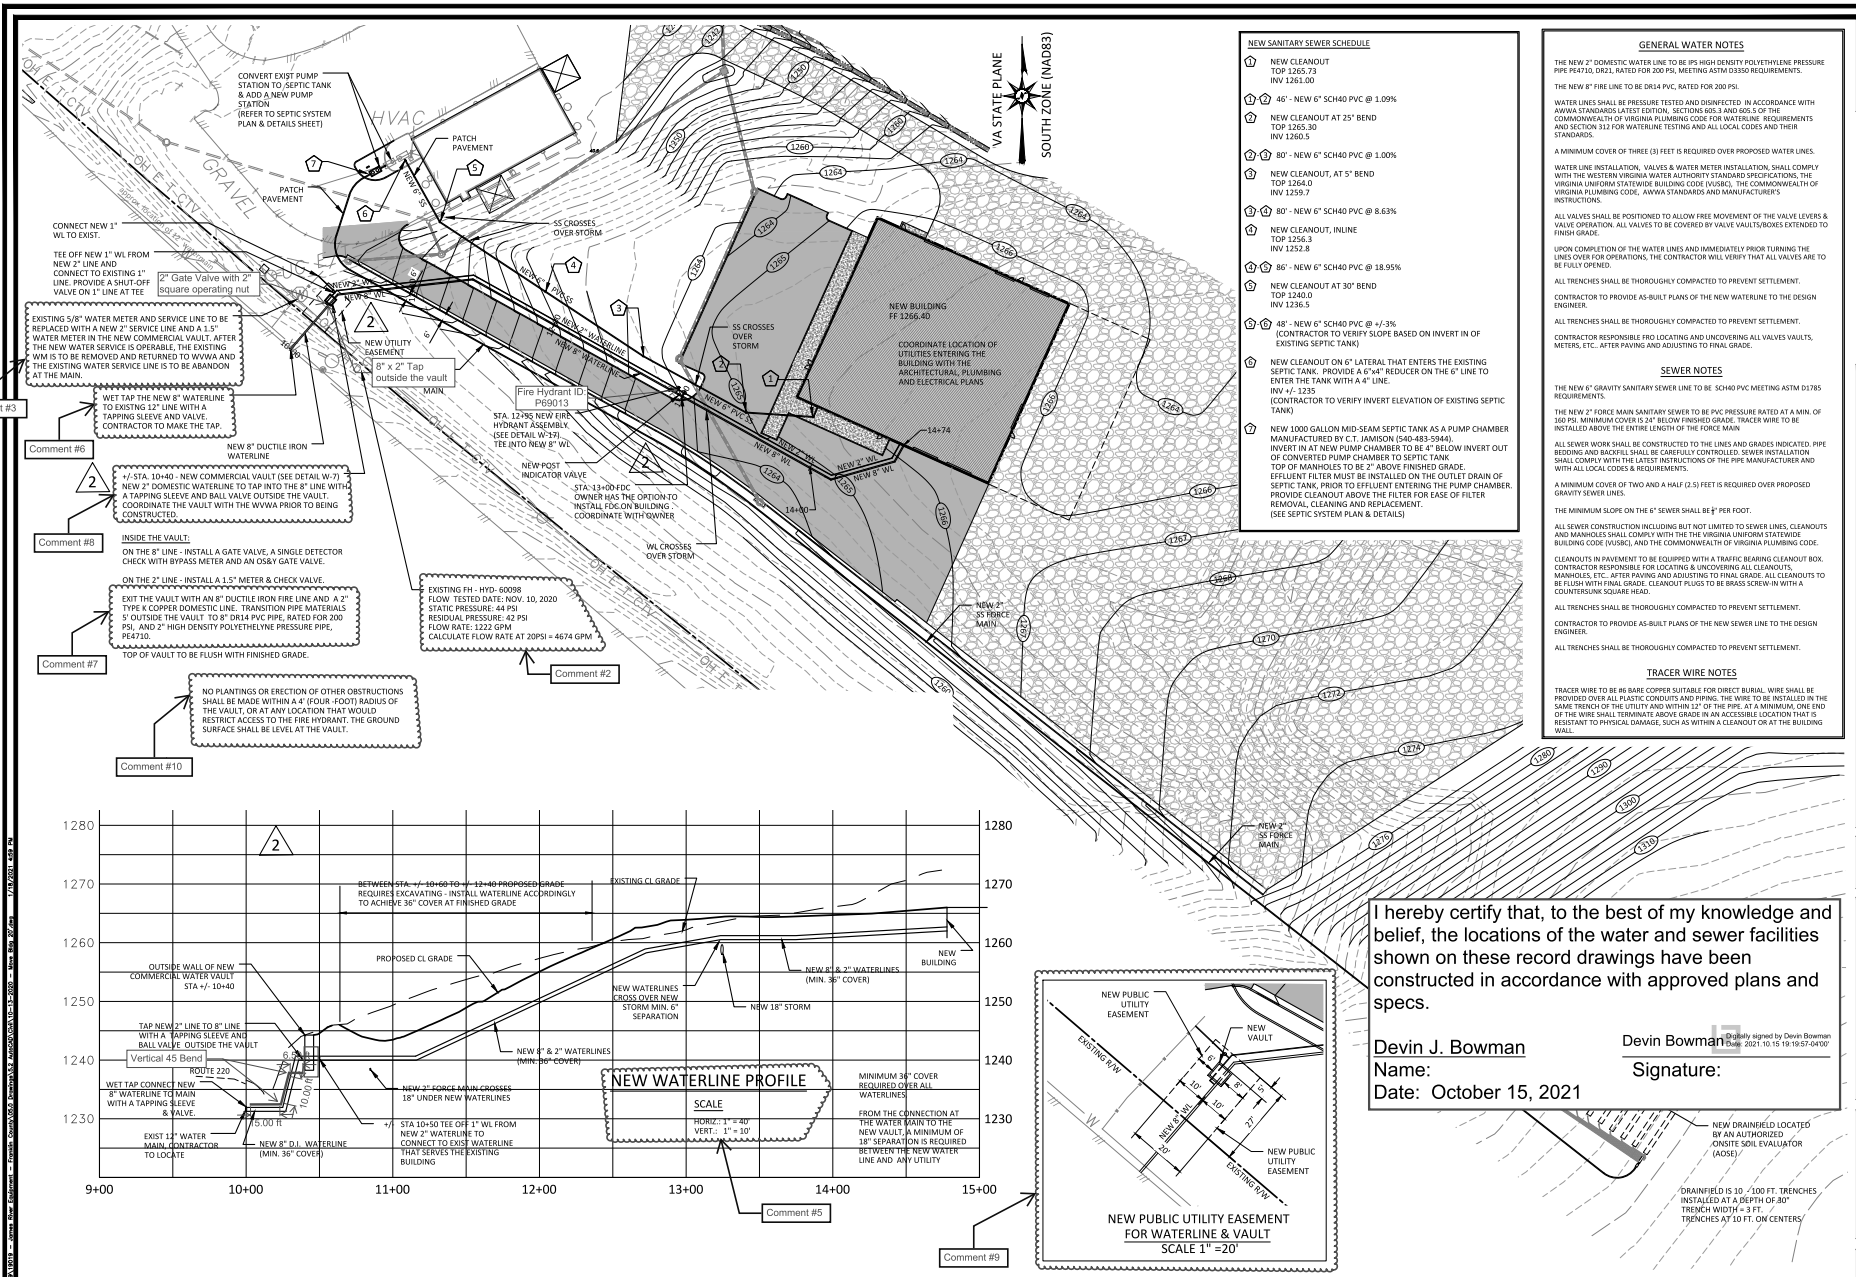

I hereby certify that, to the best of my knowledge and belief, the locations of the water and sewer facilities shown on these record drawings have been constructed in accordance with approved plans and specs.

Devin J. Bowman
Name:
Date: October 15, 2021

Devin Bowman
Digitally signed by Devin Bowman
Date: 2021.10.15 19:19:57-04'00'
Signature:

COMMONWEALTH OF VIRGINIA
06/26/2020
MARK JOHN AYLES
Lic. No. 034160

DATE: June 26, 2020
REVISIONS
1 Oct. 15, 2020
2 Dec. 29, 2020
3
4
5

HUGHES ASSOCIATES
ARCHITECTS & ENGINEERS
656 ELM AVENUE SW | ROANOKE, VIRGINIA 24016
540.342.4002
www.HughesAE.com

NEW FACILITY
JAMES RIVER EQUIPMENT
74 TAYLORS ROAD BOONES MILL, VA

DRAWN BY: xxx
CHECKED BY: xxx

SITE UTILITY PLAN

COMMISSION No. 19019
SHEET C-11

© COPYRIGHT 2020 HUGHES ASSOCIATES ARCHITECTS & ENGINEERS A PROFESSIONAL CORPORATION