

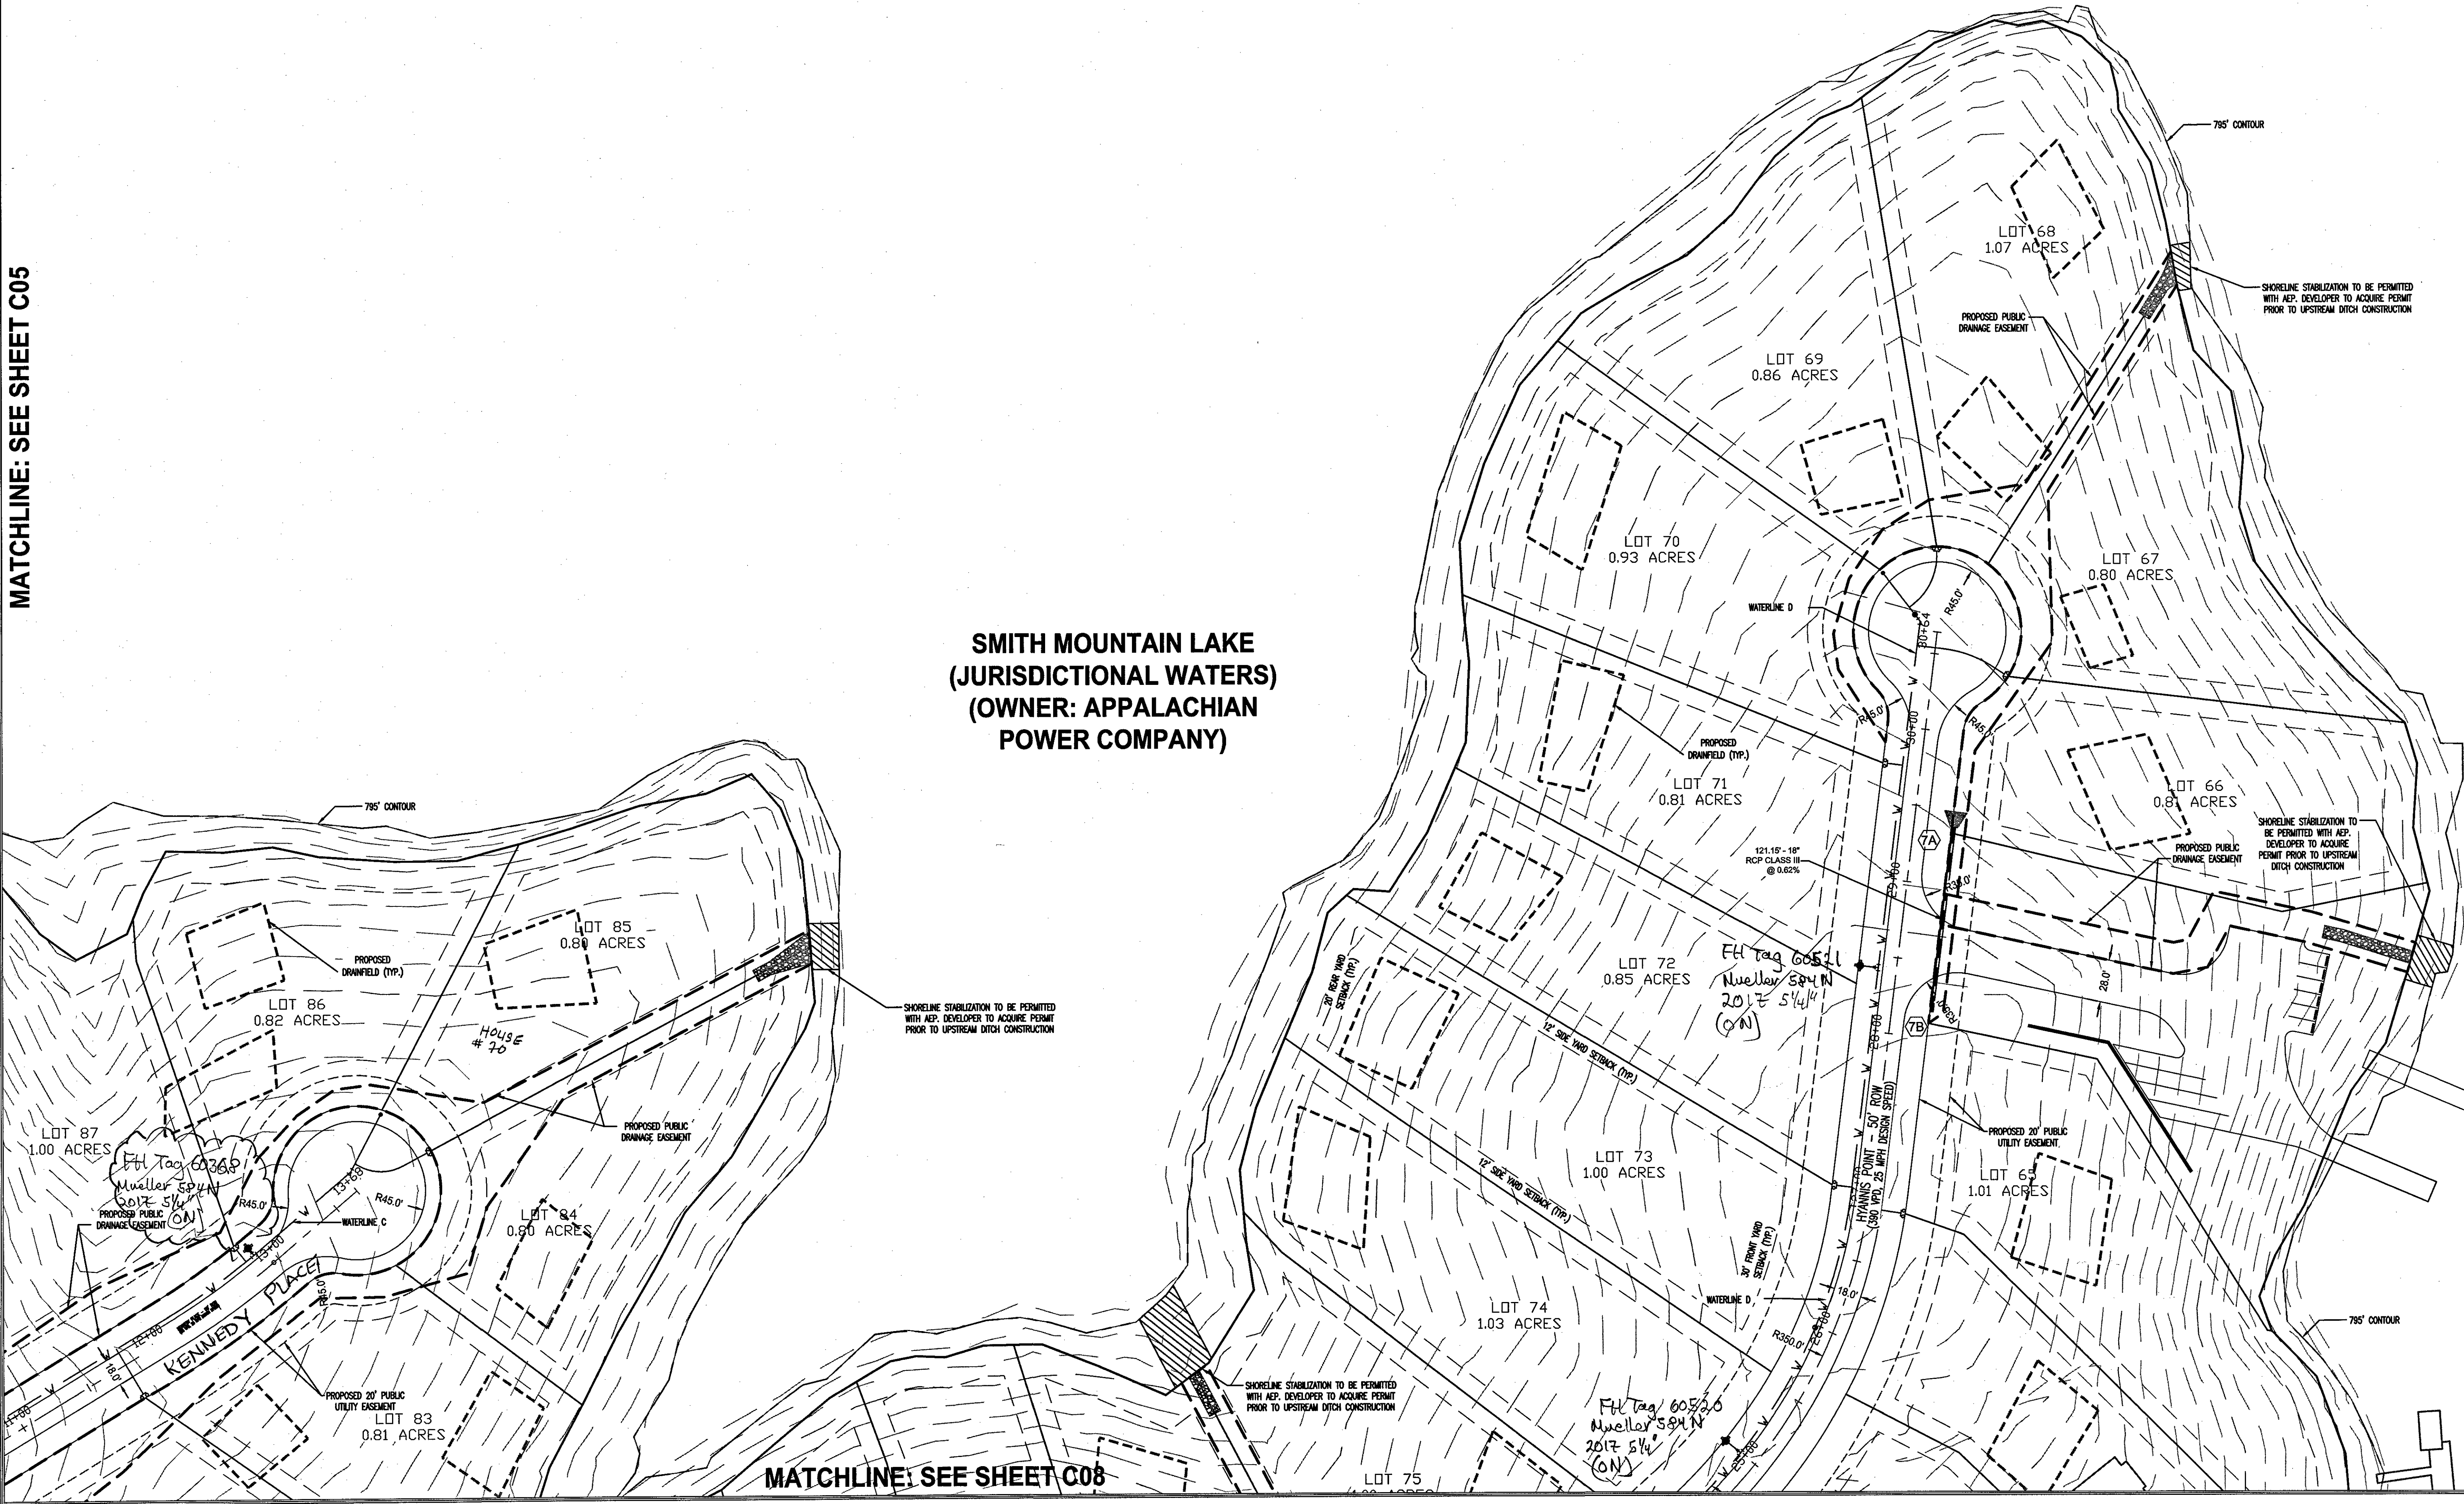


MATCHLINE: SEE SHEET C05

Part: S:\2016 Projects\16-0047 Kennedy Shores\16-0047 - Utility & Elements.dwg  
Date: 1/6/2017 10:00 AM  
User: JMM

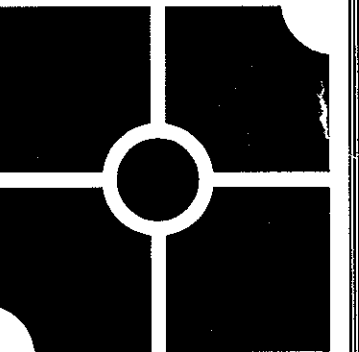

MATCHLINE: SEE SHEET C06

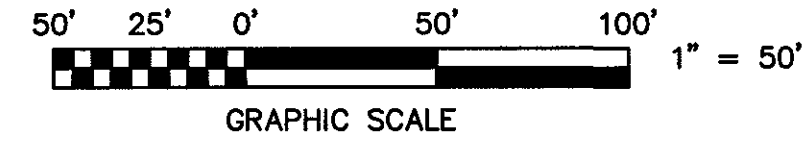


**parker**  
DESIGN GROUP

2122 Carolina Ave. SW  
Roanoke, VA 24014  
Ph: 540-387-1153  
Fax: 540-389-5767

1915-B W. Cary Street  
Richmond, VA 23220  
Phone: 804-358-2947  
Fax: 804-359-9645

www.parkerdg.com

These documents are the property of Parker Design Group (PDG) and may not be reproduced or used without the express permission of PDG. Any reuse of these documents without authorization of PDG will be at the sole risk of the individual or entity utilizing said documents.

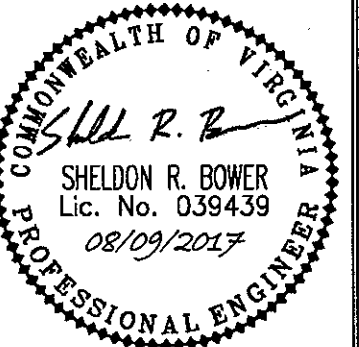

# KENNEDY SHORES SUBDIVISION DEVELOPMENT PLAN

Tax # 0510001500  
Franklin County, Virginia

| REVISIONS:                    |
|-------------------------------|
| 2/10/2017 - 1ST SUB COMMENTS  |
| 3/21/2017 - 2ND SUB COMMENTS  |
| 4/14/2017 - 3RD SUB COMMENTS  |
| 8/23/2017 - FIELD REVISION #1 |
| 7/6/2017 - FIELD REVISION #2  |
| 8/4/2017 - FIELD REVISION #3  |
| 8/9/2017 - FIELD REVISION #4  |

DESIGNED BY: JMM/SRB  
DRAWN BY: JMM/JLK  
CHECKED BY: SRB

DATE:  
6 JANUARY, 2017

SHEET TITLE:  
LAYOUT PLAN

SCALE:  
1" = 50'

SHEET NO.

**C07**