FH Tag No. 60352
American Darling Valve
Model B84B-5 5¼"
2015
Static = 46 psi

6" Screw Box
Valve has NT plug.
11'
4½" from EOP
26'4" from left side of driveway

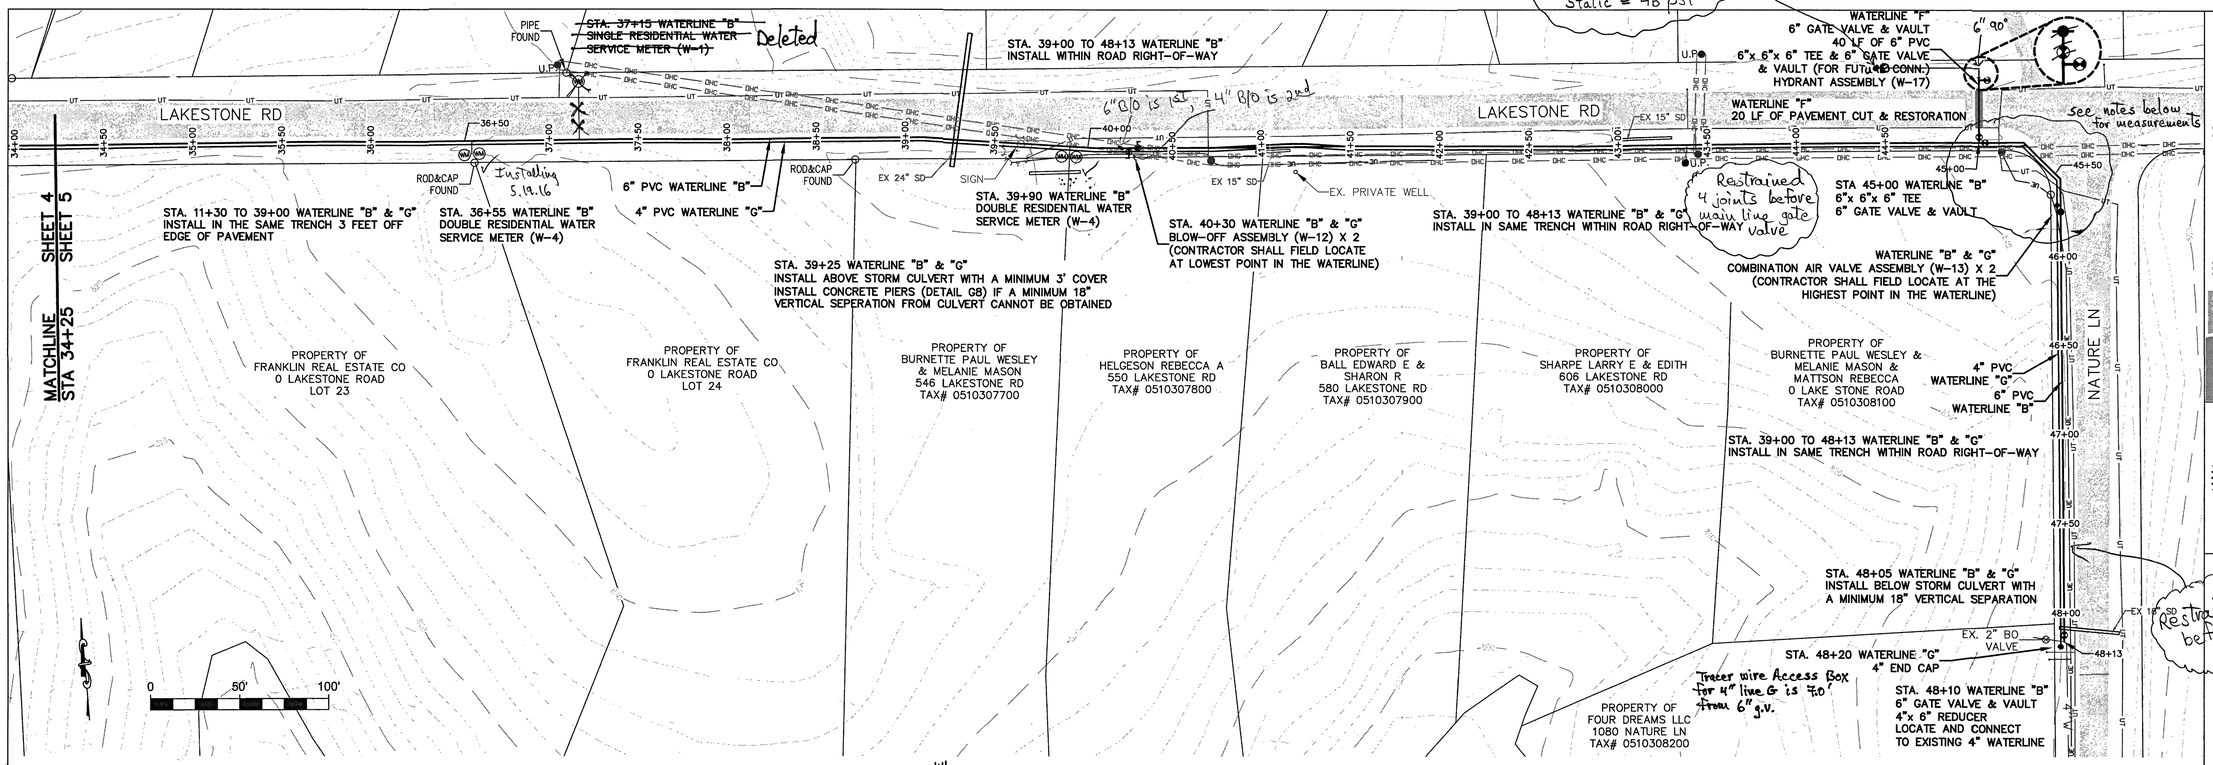

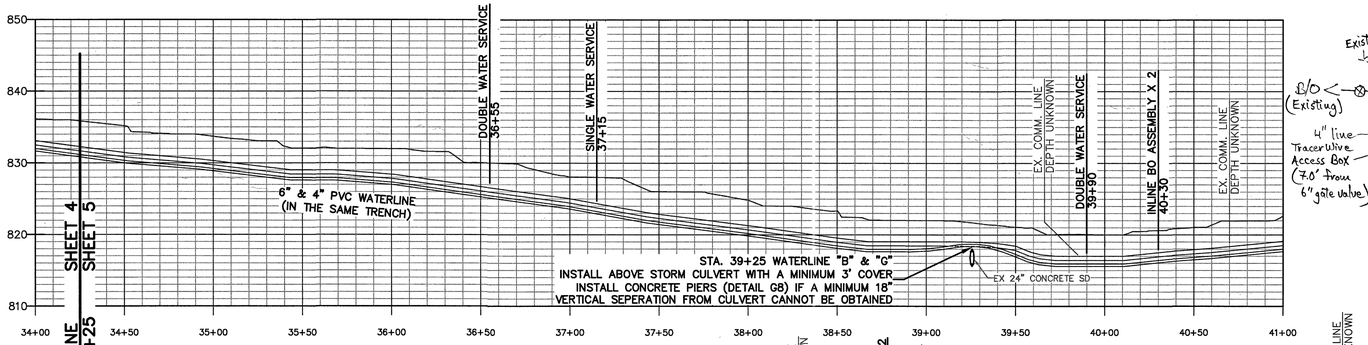

WATERLINE "B" & "G"
SCALE
VERTICAL: 1" = 10'
HORIZONTAL: 1" = 40'

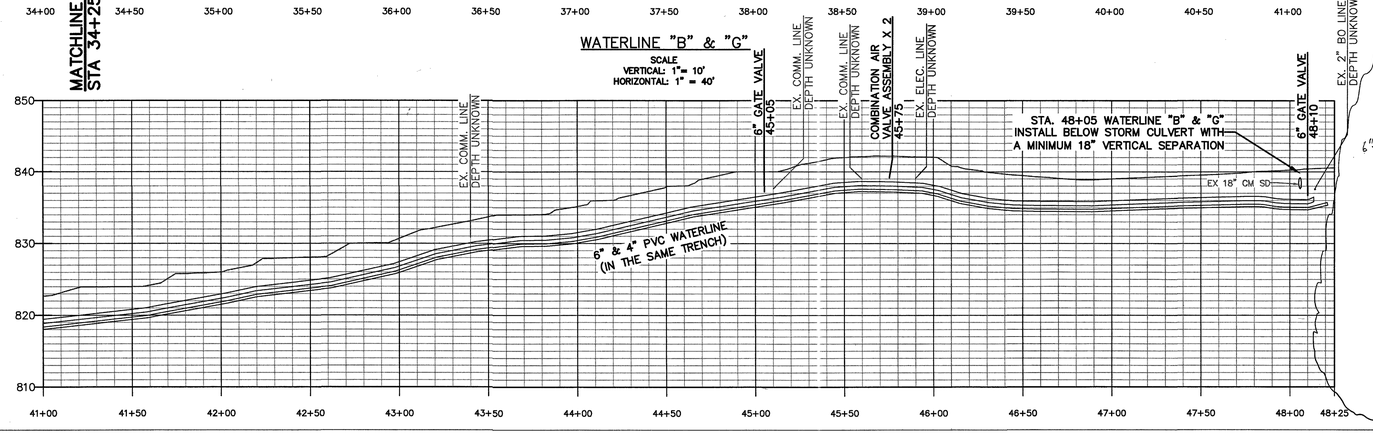

WATER INSTALLATION NOTE
4" WATERLINE "G" TO BE INSTALLED 6" BELOW 6" WATERLINE "B" TO AVOID HYDRANT & SERVICE CONNECTION CONFLICTS

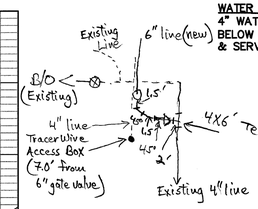

Notes for Lakestone Rd./Nature Lane

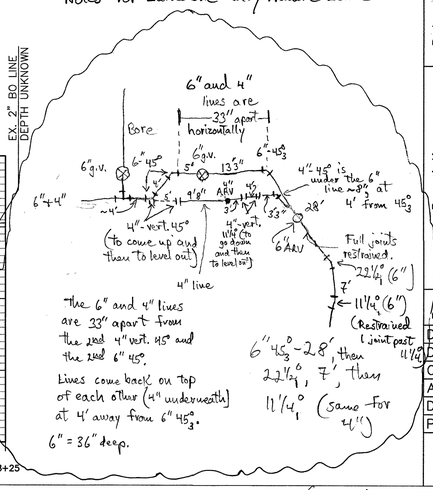

WESTERN VIRGINIA WATER AUTHORITY
ENGINEERING SERVICES
601 S JEFFERSON ST, SUITE 300
ROANOKE, VA 24011
540-853-5641 or 540-853-5770

COMMONWEALTH OF VIRGINIA
DAVID M. VOGELSONG
Lic. No. 023274
PROFESSIONAL ENGINEER

LAKESTONE ROAD WATER EXTENSION

PLAN & PROFILE

Rev	Description	Date	By
1	4" WELL LINE CHANGE ORDER	3-30-16	DRJ

Designed: DMV
Drawn: DRJ
Checked:
Approved:
Date:
Project:

5
Sheet 5 of 7

Nature Lane: Tracer wire problem 160' from end-of-line 6" valve toward Lakestone. (white X)

As-Builts

K. Winslow