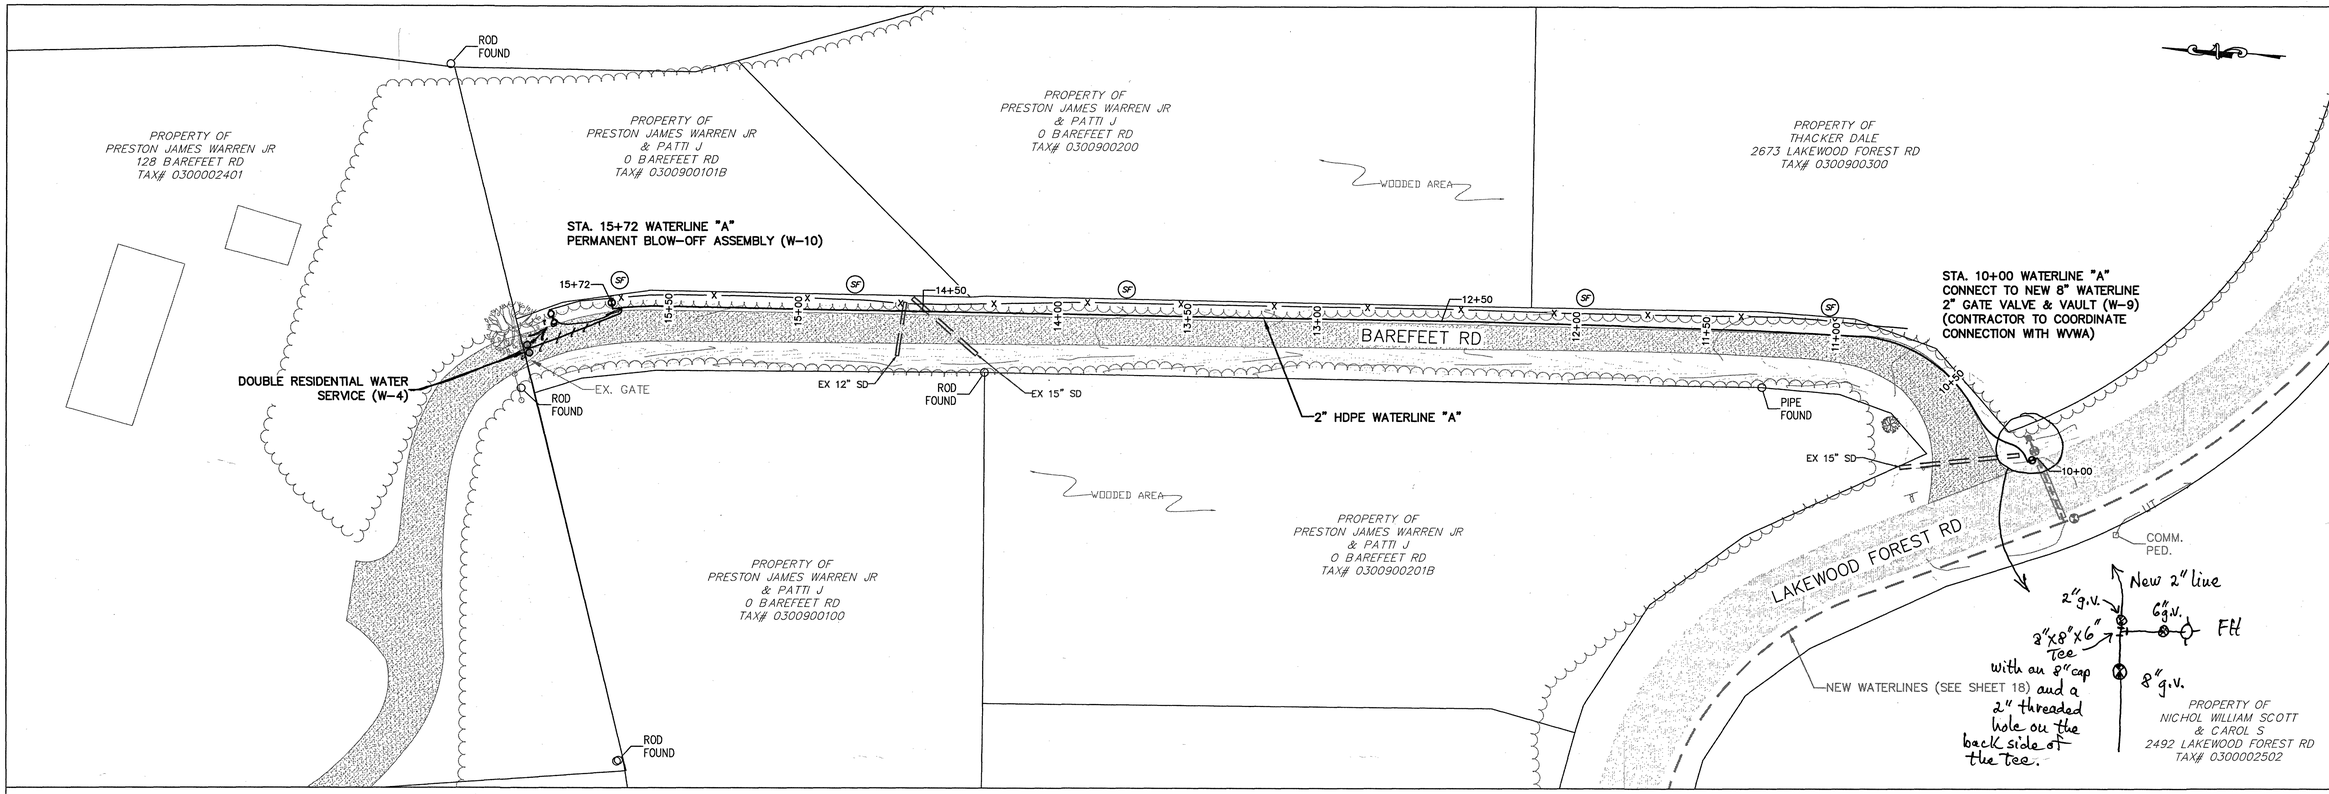

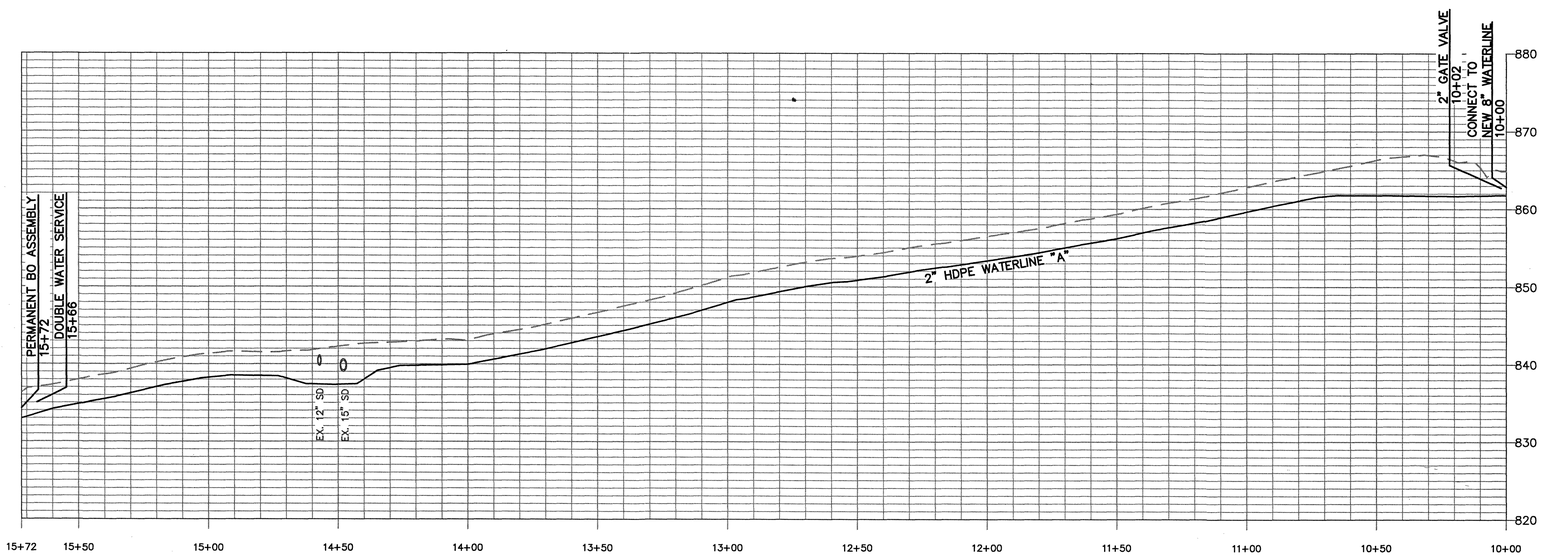

WATERLINE "A"

SCALE
VERTICAL: 1" = 10'
HORIZONTAL: 1" = 30'

GENERAL NOTES:
1. PROPERTY LINES SHOWN ON THIS PAGE WERE SET BASED ON RECORDS AND FIELD SURVEY DATA.
2. ANY FIELD CHANGES THAT AFFECT A DESIGN STANDARD SHALL BE APPROVED BY THIS PLAN SETS ENGINEER OF RECORD.

WESTERN VIRGINIA WATER AUTHORITY
ENGINEERING SERVICES
601 S JEFFERSON ST, SUITE 300
ROANOKE, VA 24011
540-853-5700

LAKEWOOD & WEATHERWOOD INTERCONNECTION

PLAN & PROFILE
Barefeet Rd. Addition

Rev	Description	Date	By

Designed: NSS, AJC
Drawn: NSS, AJC
Checked: NSS, DRJ
Approved: IAS
Date: JAN 2020
Project: CUST. EXT.

18A
Sheet 18A of 32

As-Built K. Winslow 10.16.20