



2974 Lakewood Forest Rd.

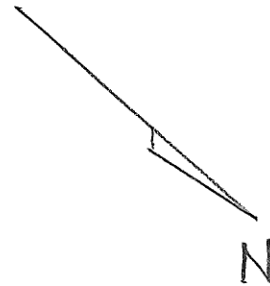


Lakewood Forest Rd.

2975 Lakewood Forest Rd
T# 0310600100

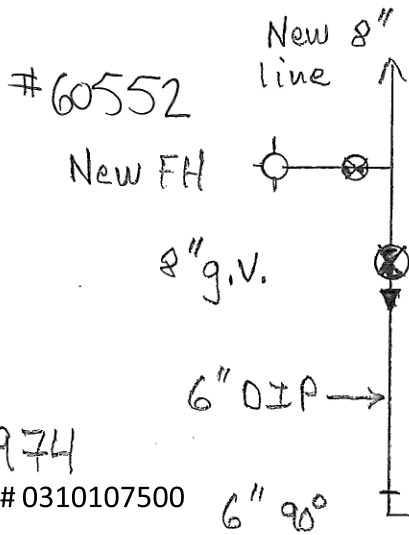

2974
T# 0310107500

New 6" DIP

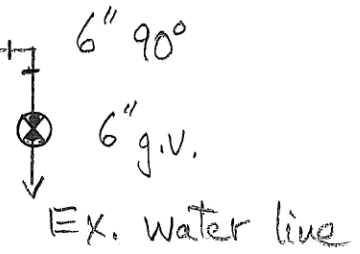

Left
Property Line

3000 Lakewood Forest Rd
T# 0310107600

8" g.v. Manhole is ~30' from the left property line
6" 90° bend is ~18' from the left property line.