



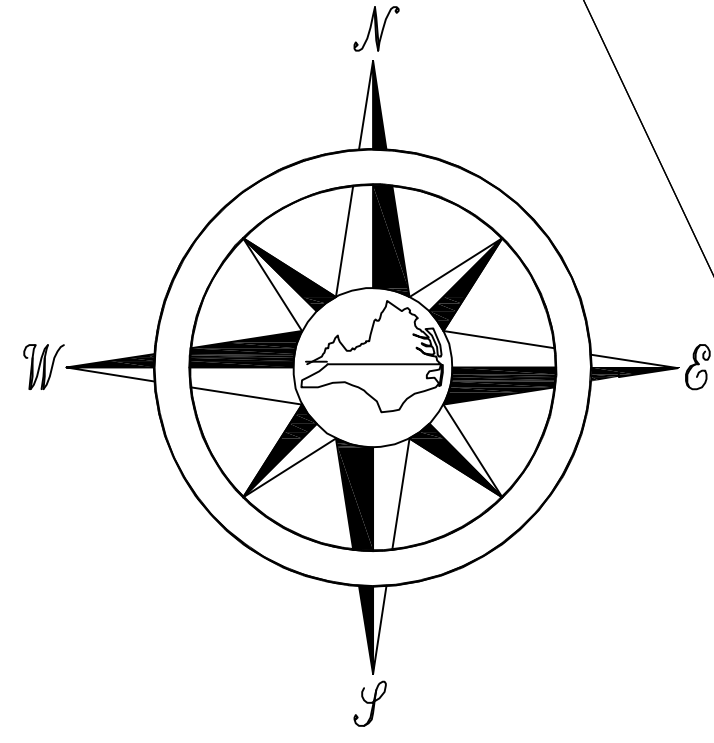


- LEGEND
- VALVE
 - ⊕ HYDRANT
 - AIR RELEASE VALVE (A.R.V.)
 - ⚓ SERVICE LINE W/ METER
 - SNAKE PIT (S.P.)

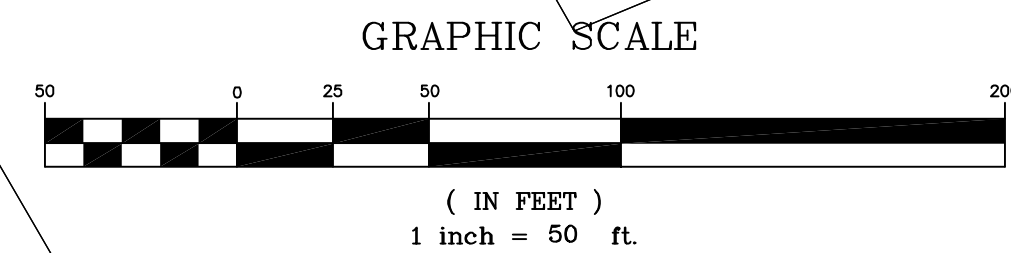

REVISIONS	
NO.	DESCRIPTION

DATE 9/7/20	
----------------	-------------

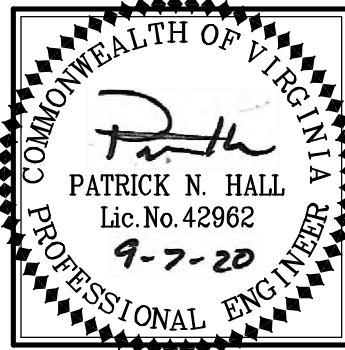

AS-BUILT SURVEY

LAKWOOD FOREST & WEATHERWOOD INTERCONNECTION