


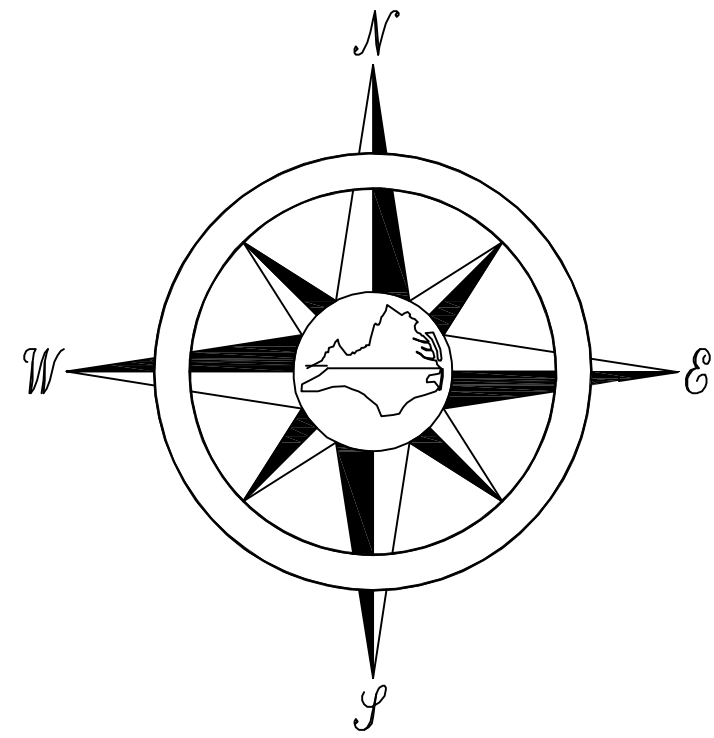


EX LAKEWOOD
FOREST WELL #1

EX LAKEWOOD
FOREST WELL #1

APPROX LOCATION OF
ABANDONED WATERLINE


- LEGEND
- VALVE
 - HYDRANT
 - AIR/RELEASE VALVE (A.R.V.)
 - ↑ SERVICE LINE W/ METER
 - SNAKE PIT (S.P.)

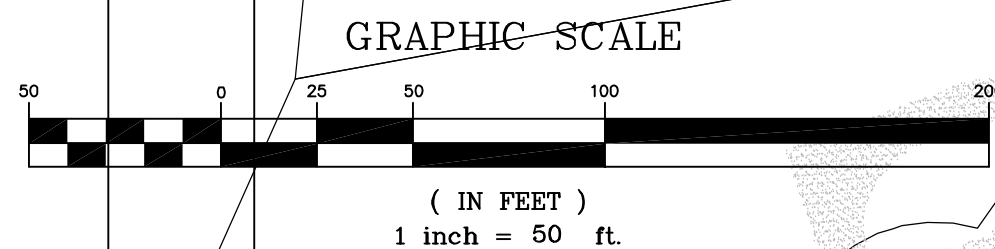

BENCHMARK Surveying & Design, PLC
5017 ARARAT HIGHWAY, ARARAT, VIRGINIA 24053
PATRICK N. HALL L.S. #2667

REVISIONS
NO. DATE DESCRIPTION

DATE
9/07/20

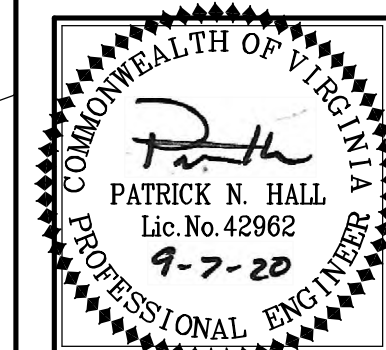

AS-BUILT SURVEY

LAKEWOOD FOREST & WEATHERWOOD INTERCONNECTION

C12
SHEET 12 of 13