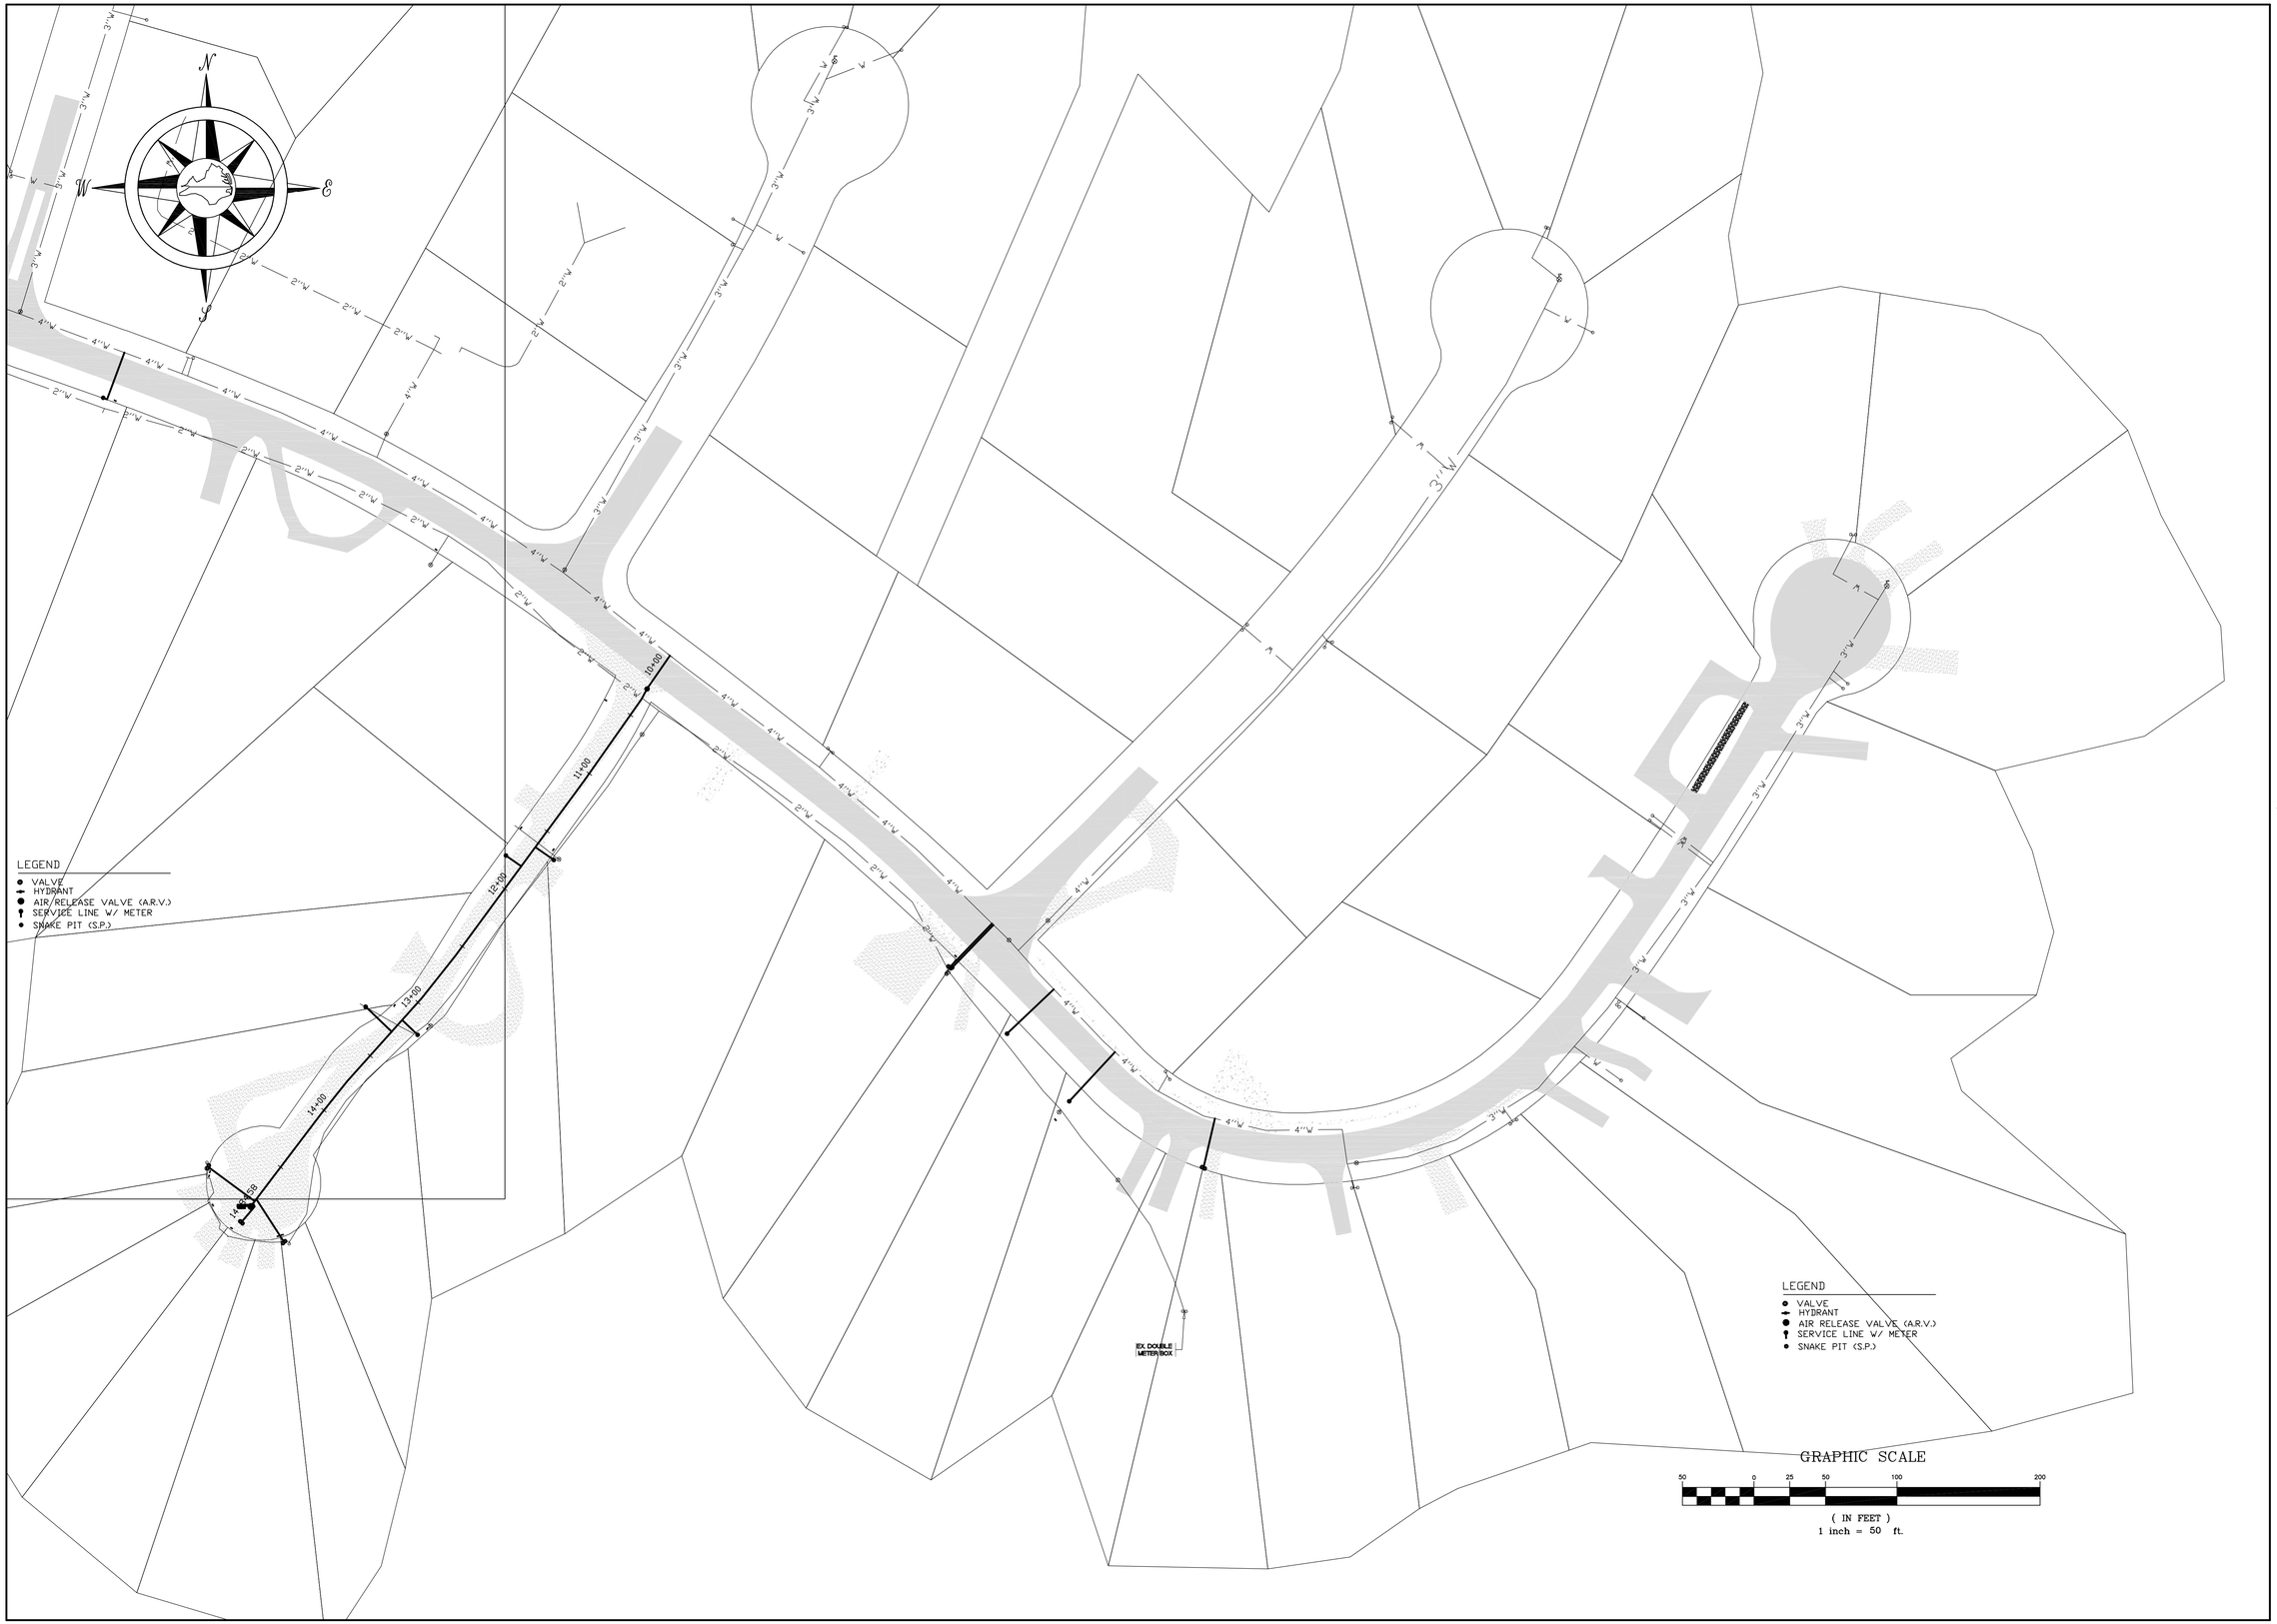

BENCHMARK Surveying & Design, PLC
5017 ARARAT HIGHWAY, ARARAT, VIRGINIA 24053
PATRICK N. HALL L.S. #2667
Ph. (276) 251-5119

REVISIONS		
NO.	DATE	DESCRIPTION

DATE
9/7/20

COMMONWEALTH OF VIRGINIA
PATRICK N. HALL
Lic.No.42962
9-7-20
PROFESSIONAL ENGINEER

AS-BUILT SURVEY

LAKEWOOD FOREST & WEATHERWOOD INTERCONNECTION

C13

SHEET 13 of 13