



19285-comp-04-rp01.dwg


MATCHLINE SHEET No. 5
MATCHLINE SHEET No. 4

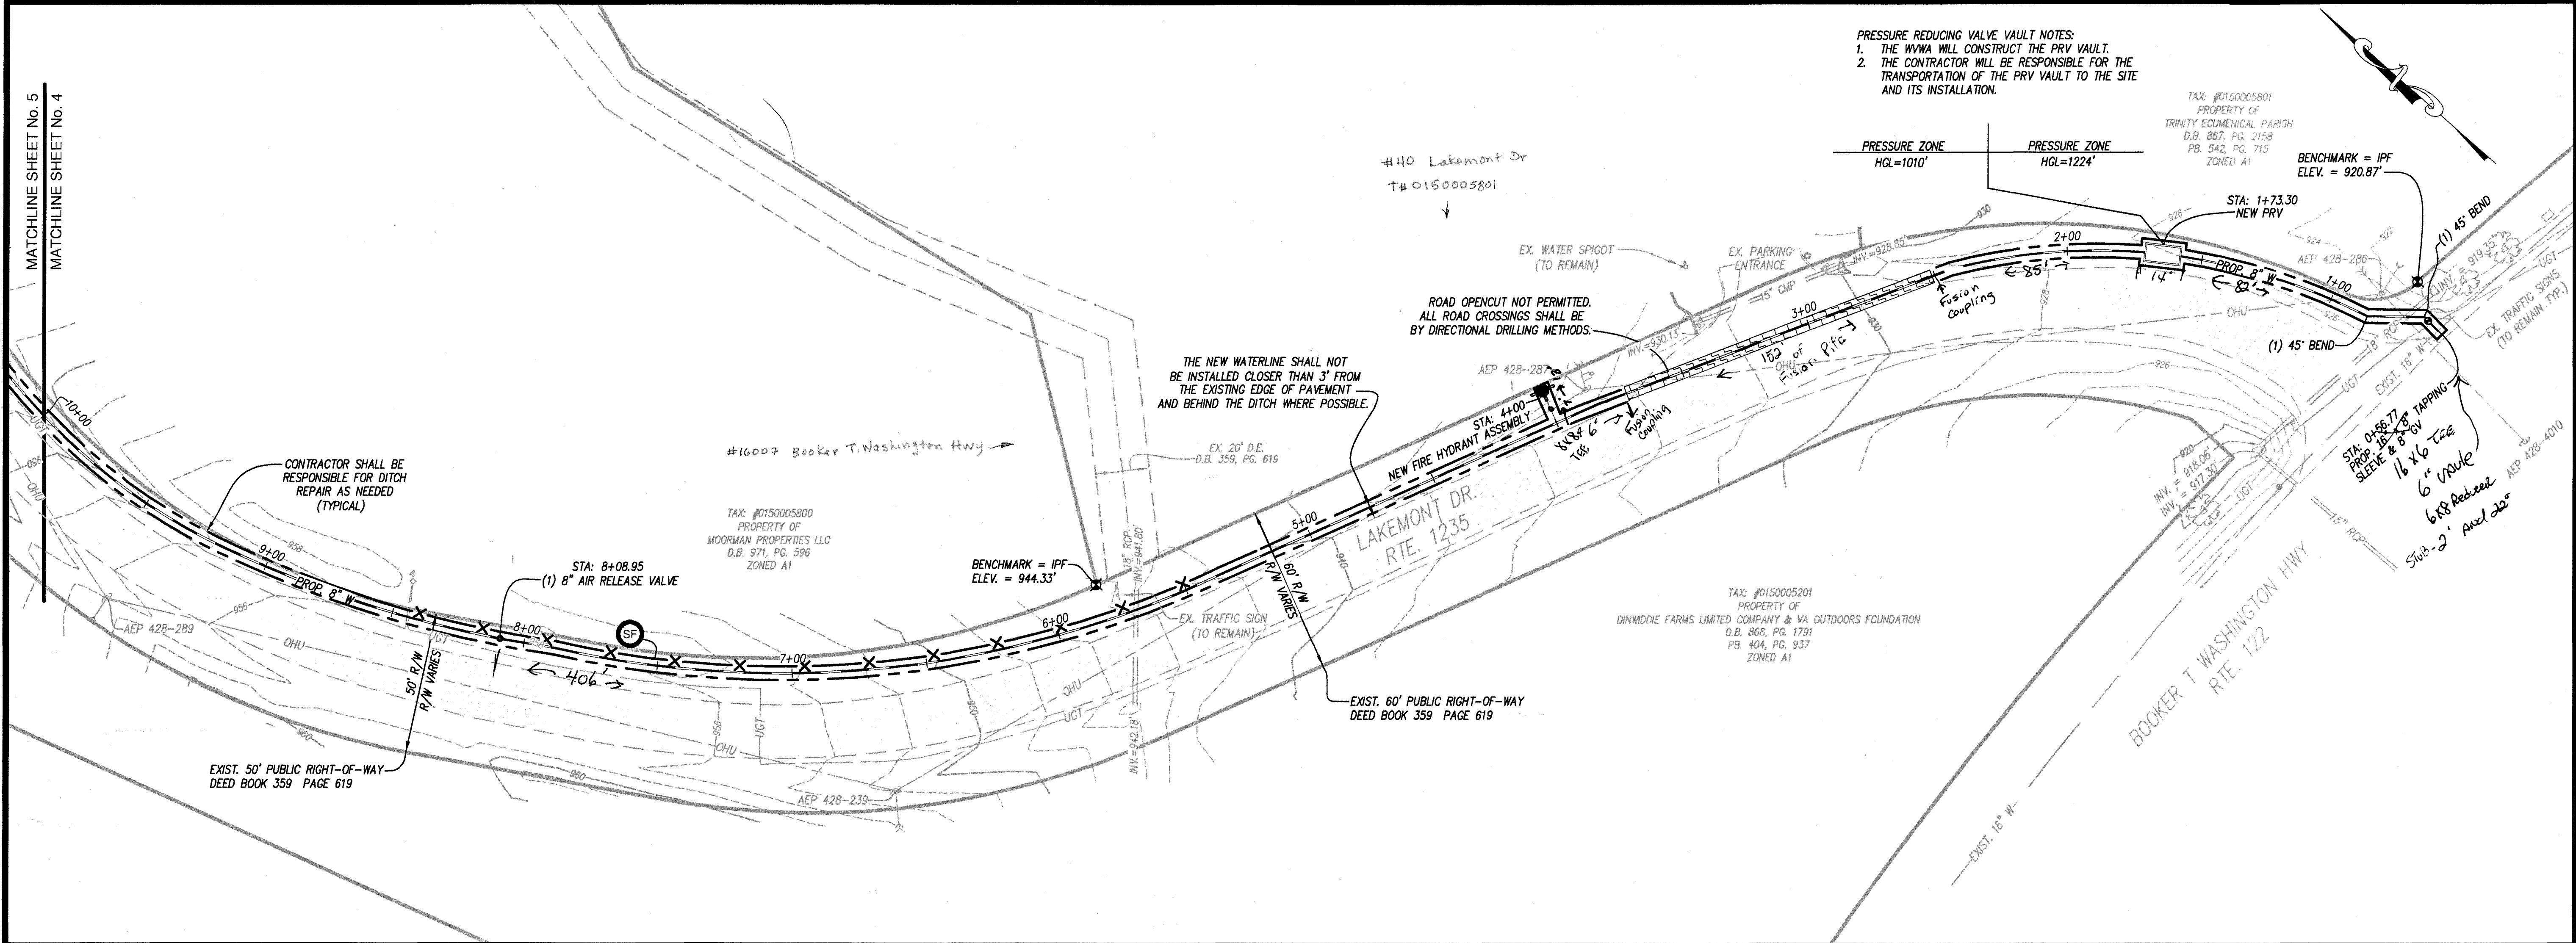

SHEET 5

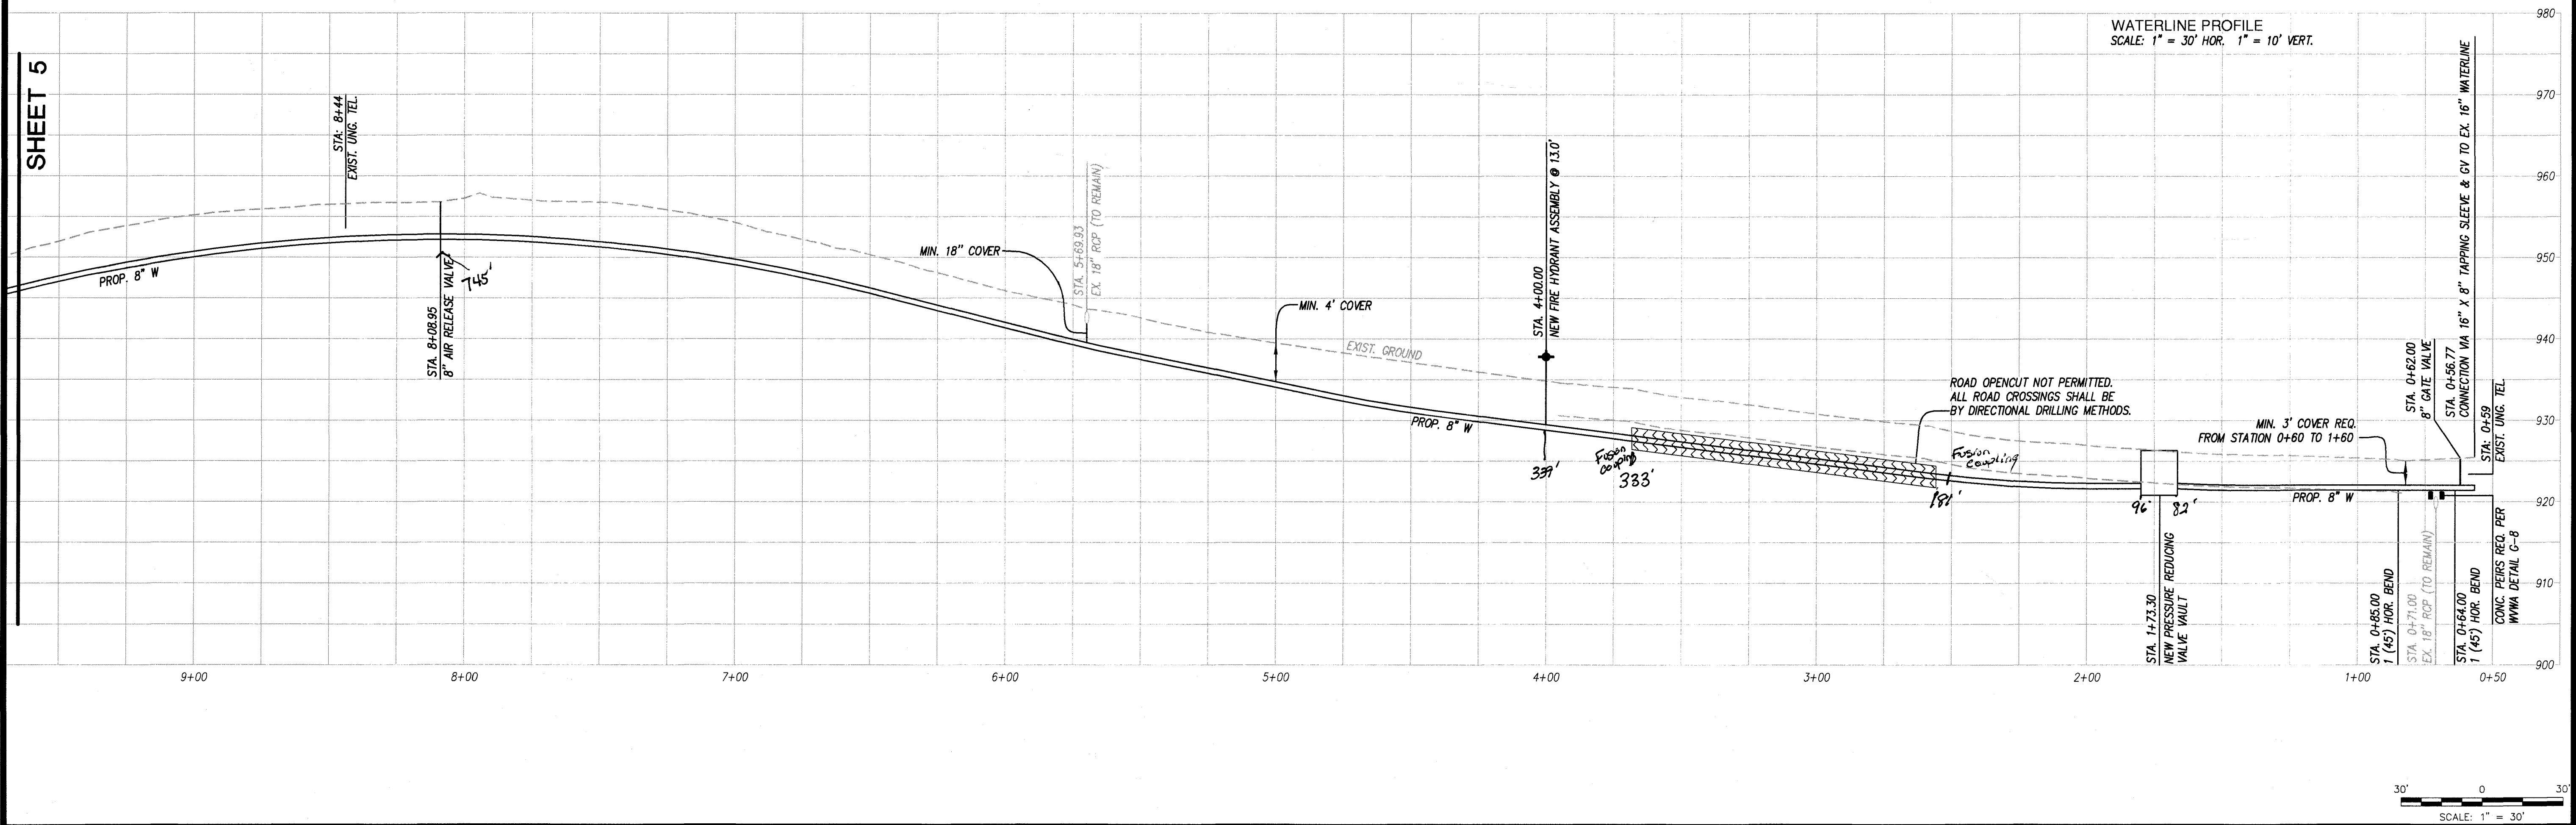

Lumsden Associates, P.C.
ENGINEERS | SURVEYORS | PLANNERS
4664 BRAMBLETON AVENUE
P.O. BOX 20669
ROANOKE, VIRGINIA 24018
PHONE: (540) 774-4411
FAX: (540) 772-9445
WWW.LUMSDENPC.COM

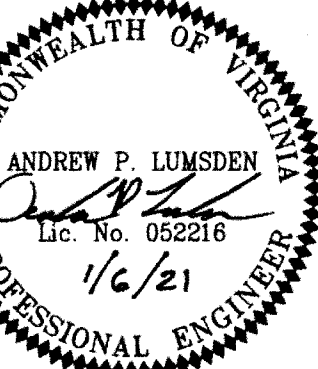

PLAN & PROFILE

STAROVER LAKE
WATERLINE EXTENSION
PREPARED FOR
WESTERN VIRGINIA WATER AUTHORITY
SITUATED IN
FRANKLIN COUNTY, VIRGINIA

REVISIONS		DESCRIPTION
NO.	DATE	
1		
2		
3		
4		
5		

DATE: January 6, 2021
SCALE: 1" = 30'
COMMISSION NO: 19-285
SHEET 4 OF 9