
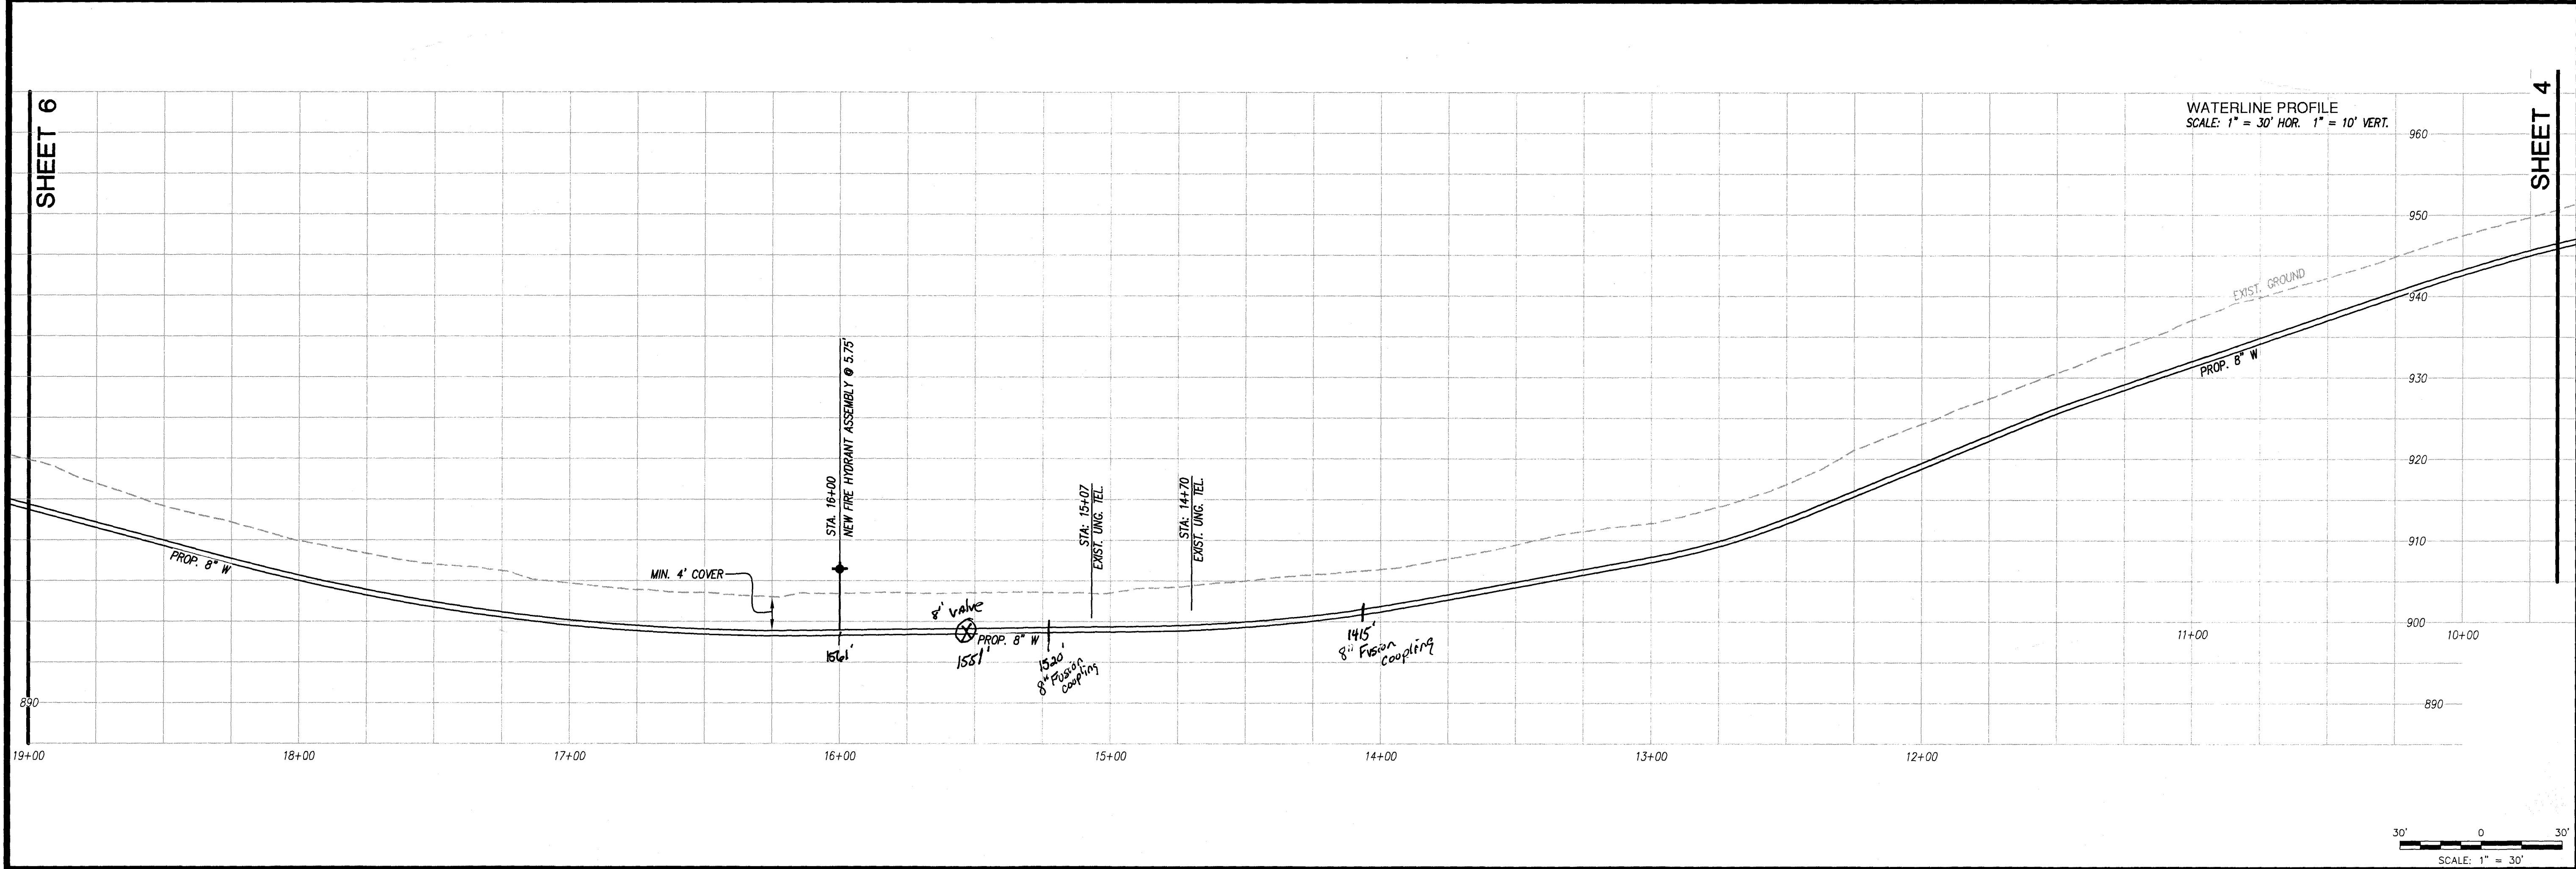


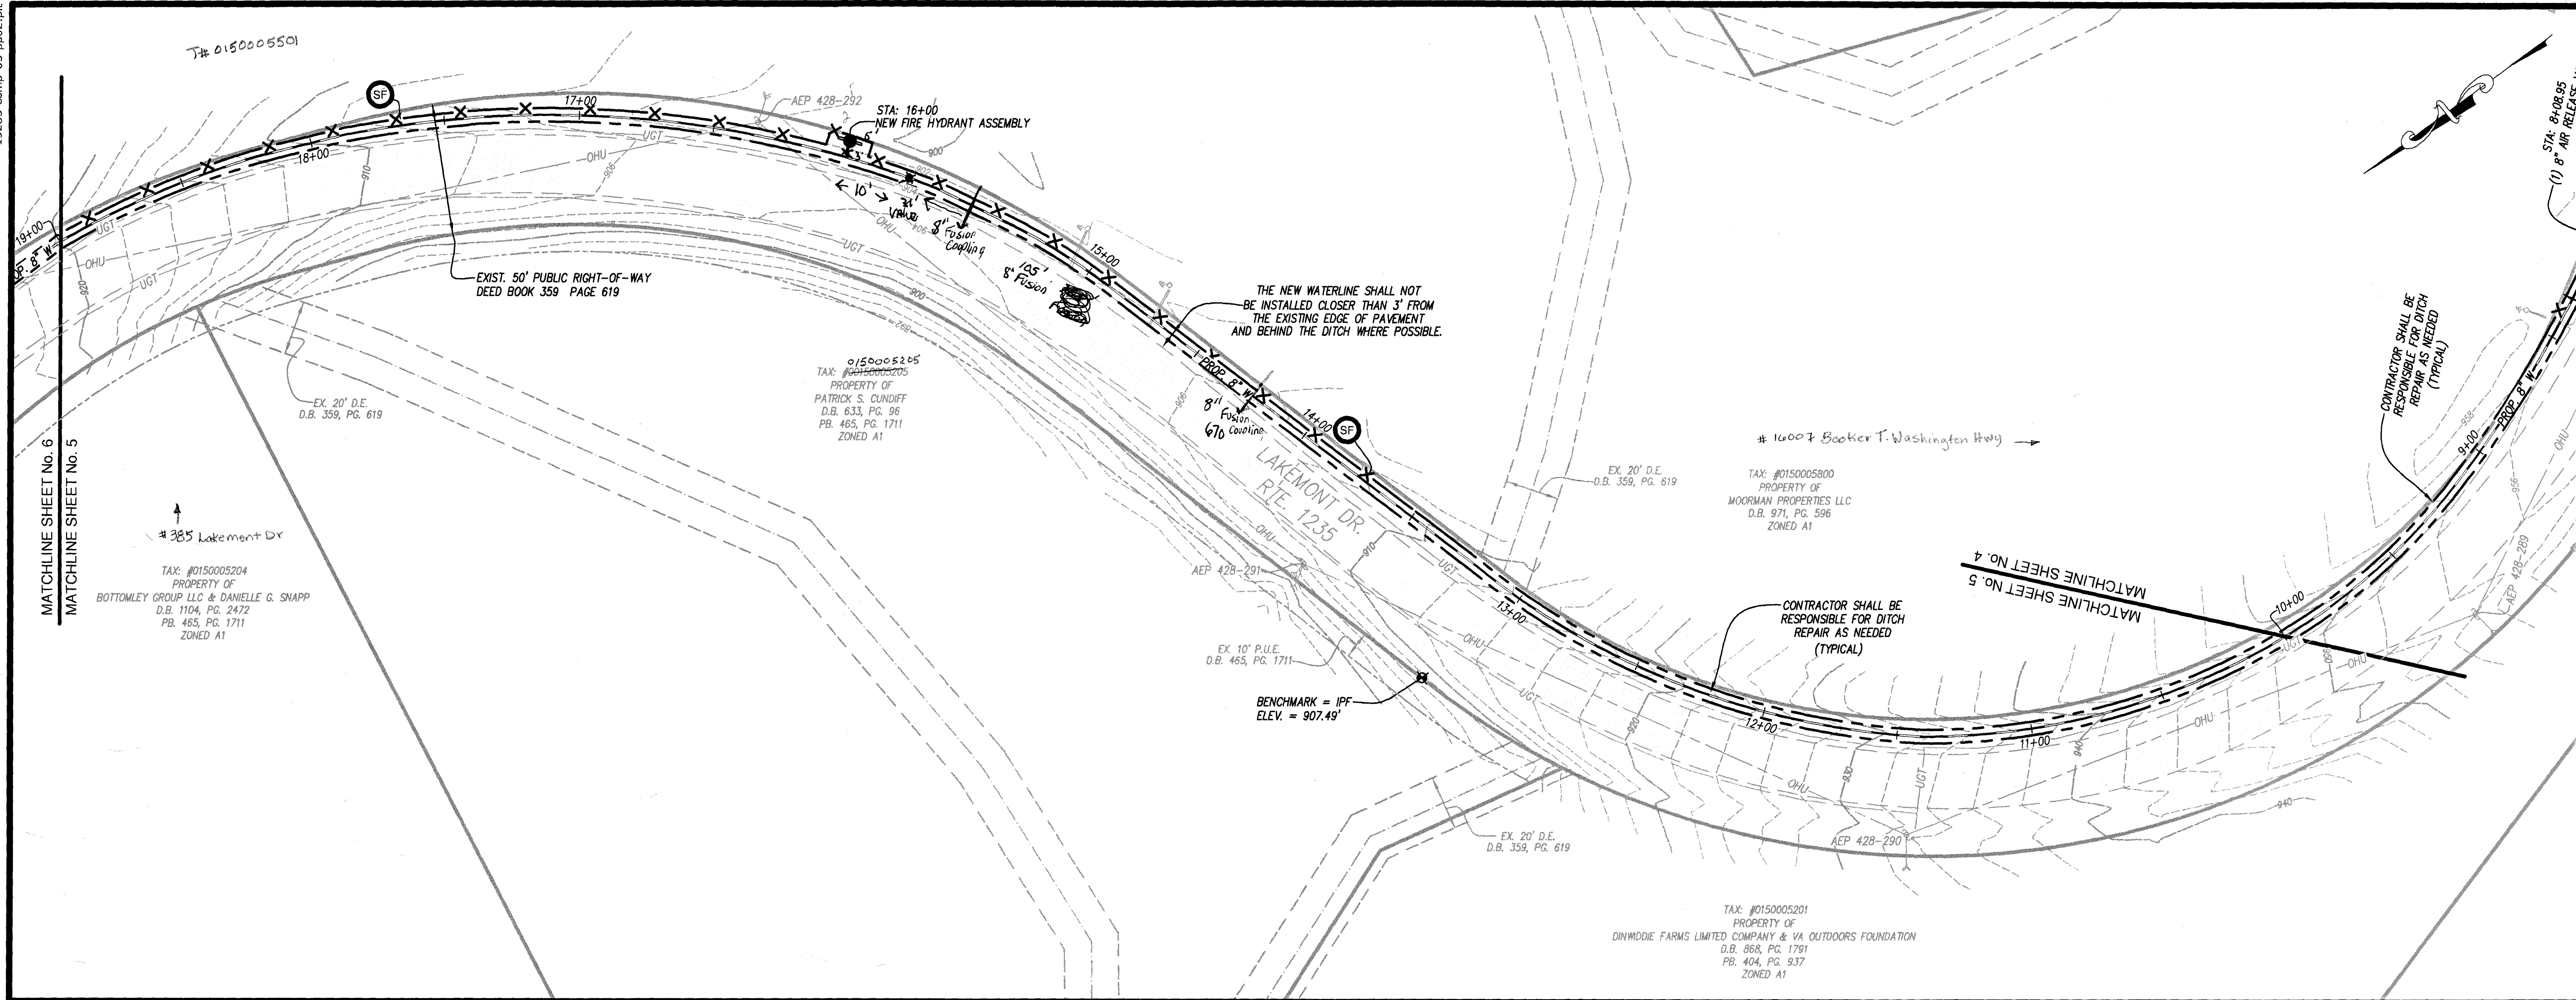

Lumsden Associates, P.C.
ENGINEERS | SURVEYORS | PLANNERS

4664 BRAMBLETON AVENUE
P.O. BOX 20669
ROANOKE, VIRGINIA 24018

PHONE: (540) 774-4411
FAX: (540) 772-5445
WWW.LUMSDENPC.COM

COMMONWEALTH OF VIRGINIA
ANDREW P. LUMSDEN
Lic. No. 052216
1/6/21
PROFESSIONAL ENGINEER

PLAN & PROFILE

**STAROVER LAKE
WATERLINE EXTENSION**
PREPARED FOR
WESTERN VIRGINIA WATER AUTHORITY
SITUATED IN
FRANKLIN COUNTY, VIRGINIA

REVISIONS		DATE		DESCRIPTION	
NO.	DATE	NO.	DATE	NO.	DESCRIPTION
1		2		3	
4		5			

DATE: January 6, 2021
SCALE: 1" = 30'
COMMISSION NO: 19-285
SHEET 5 OF 9