


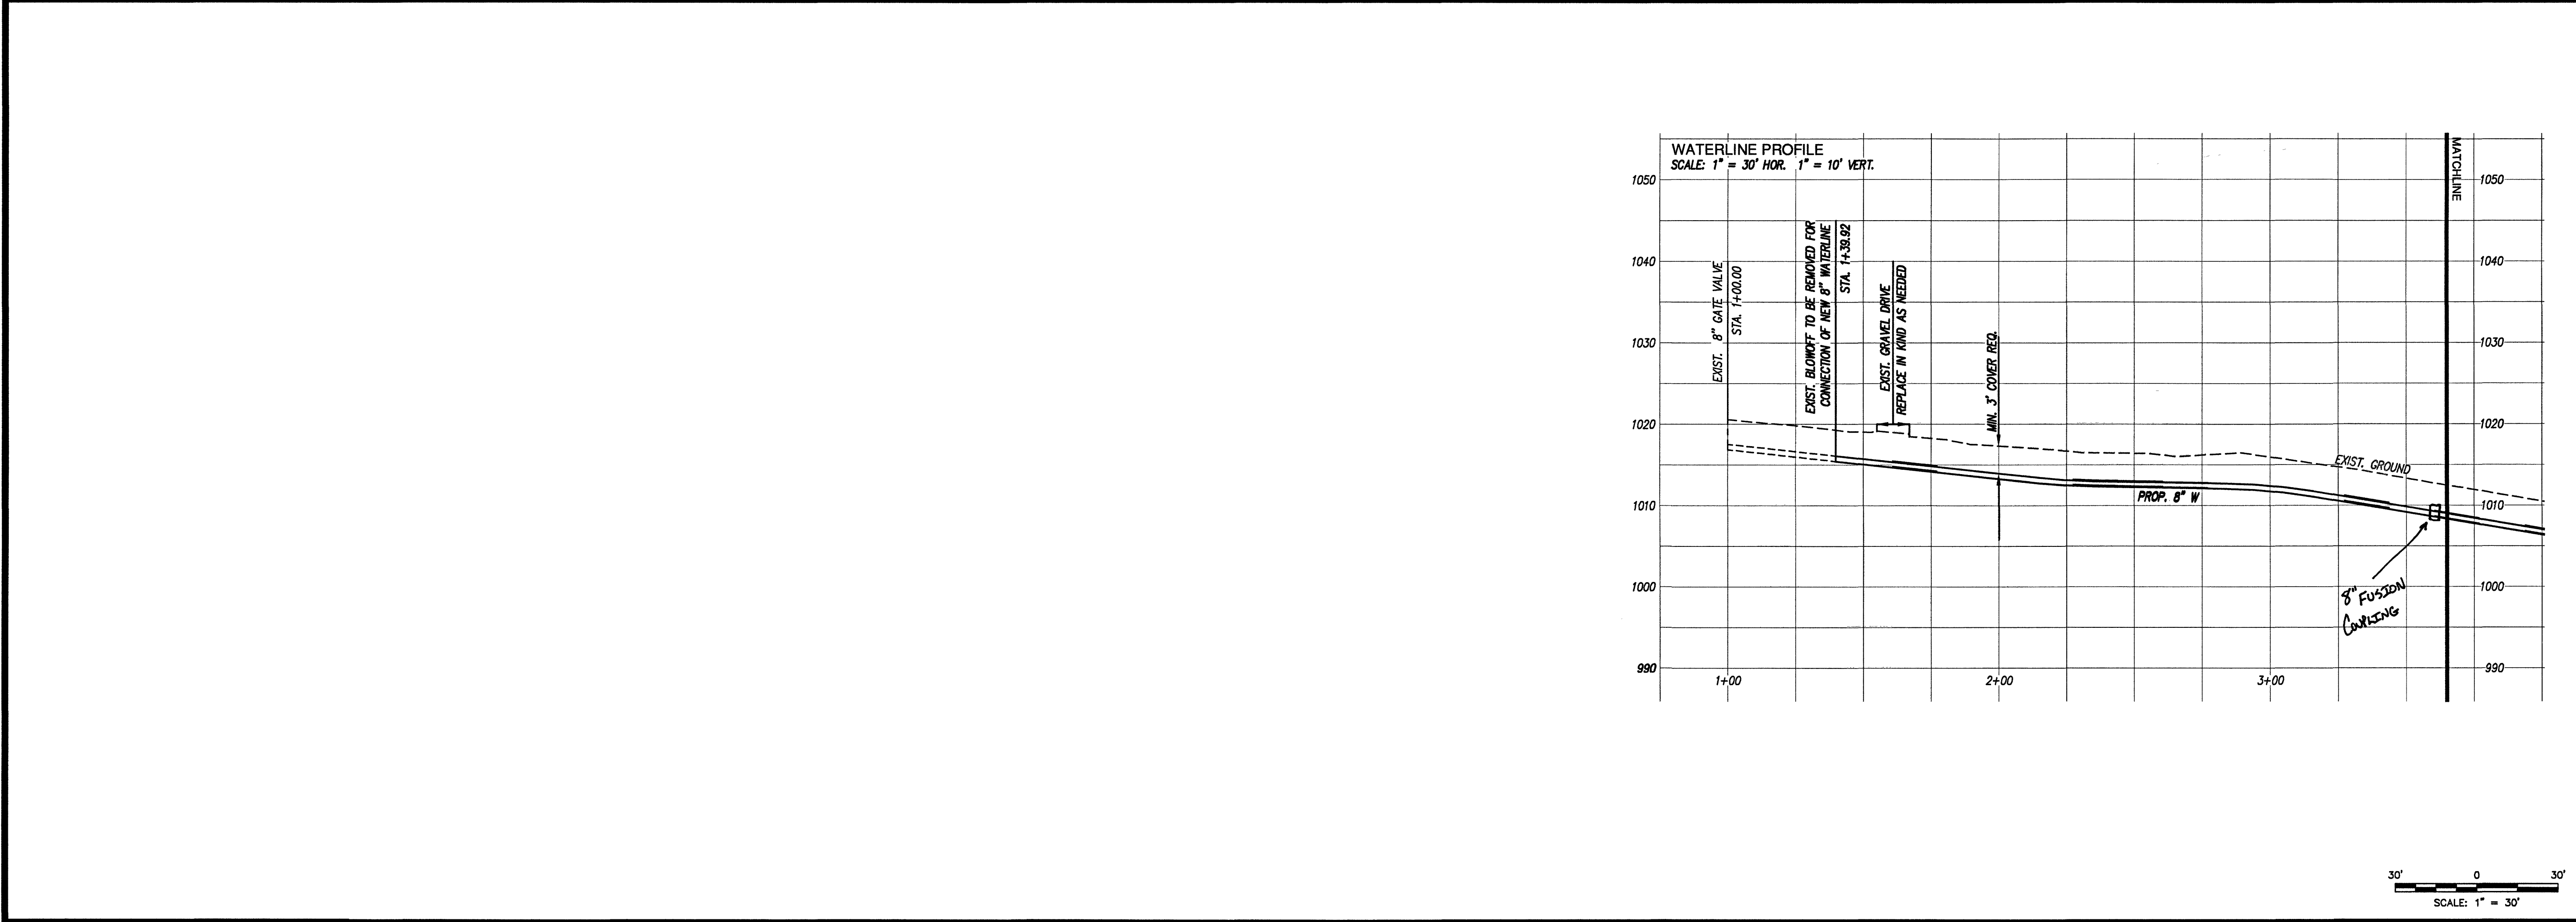

REVISIONS	
NO.	DESCRIPTION
1	
2	
3	
4	
5	

DATE: July 22, 2020

SCALE: 1" = 30'

COMMISSION NO: 19-284

SHEET 4 OF 11