
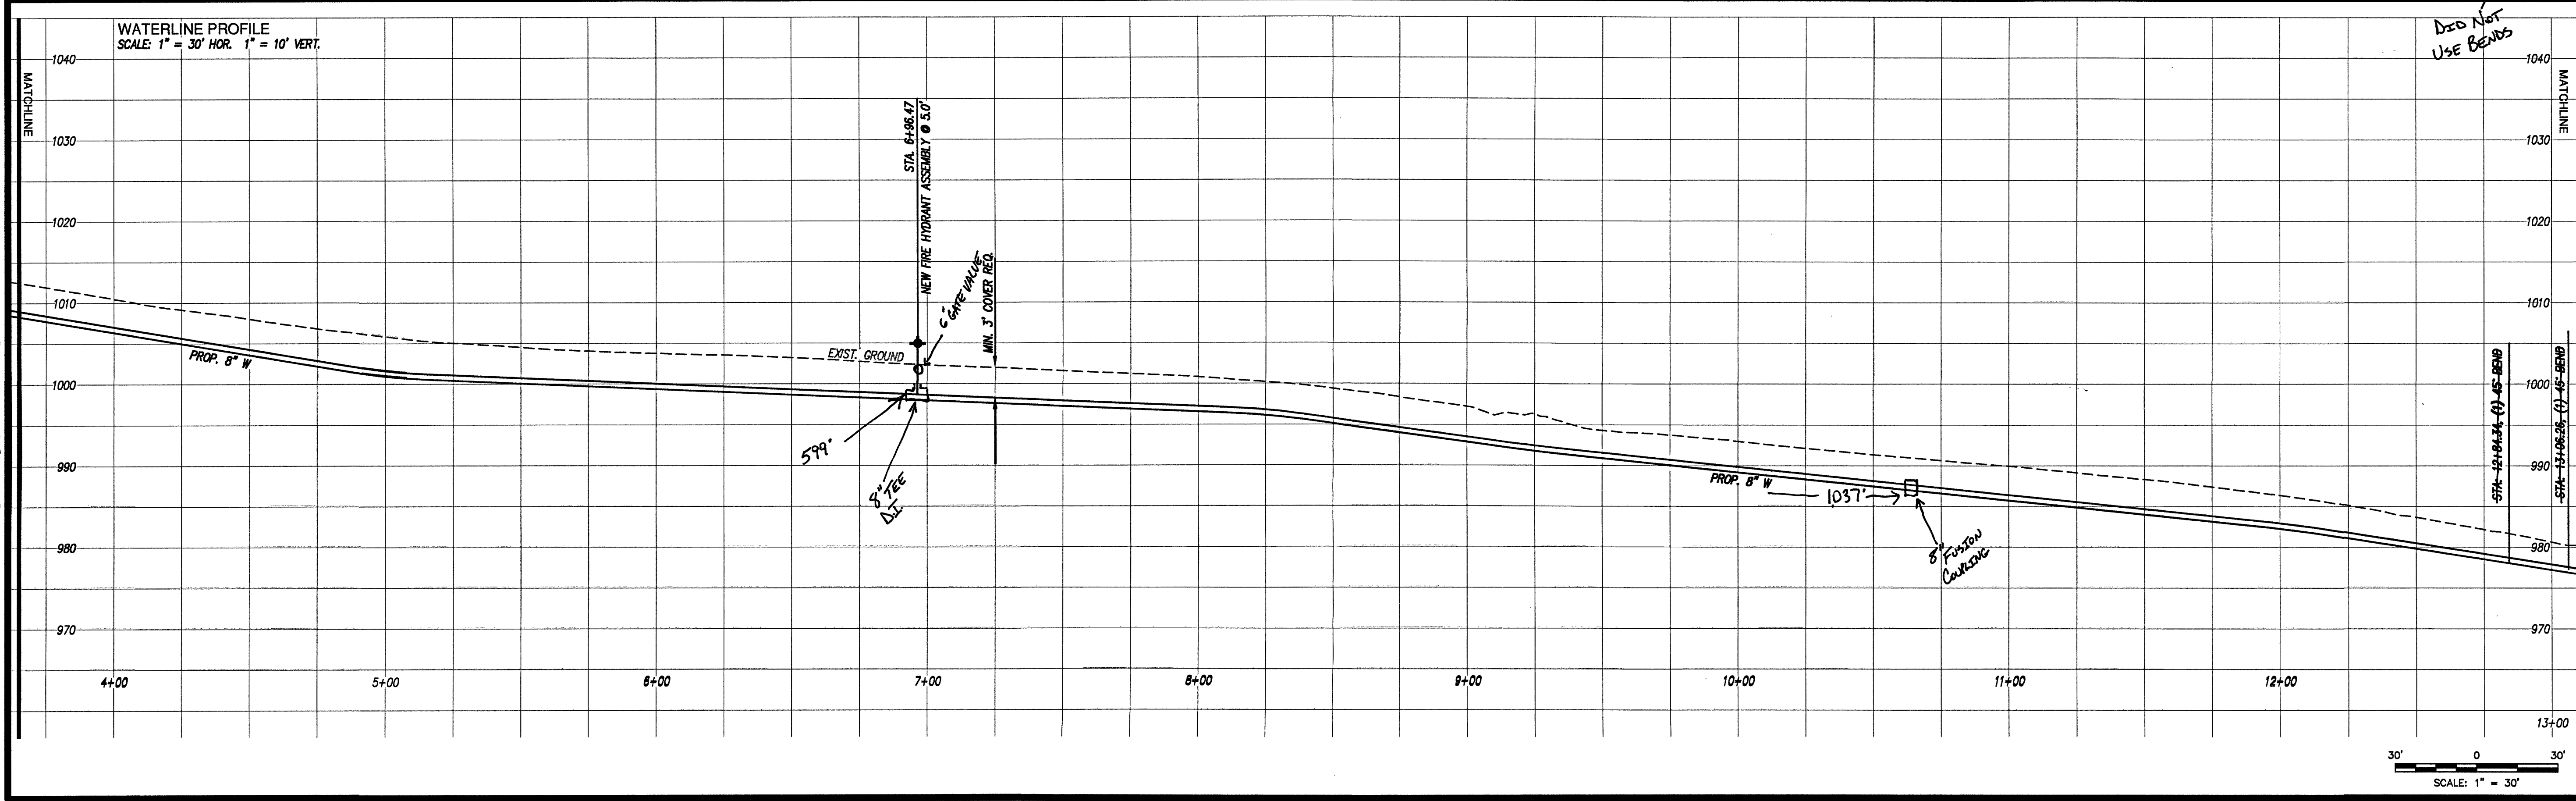


19284-comp-05-pp02.dwg

w:\drawings\2019\2019-284\01-engineering\02-design\19284-comp.dwg

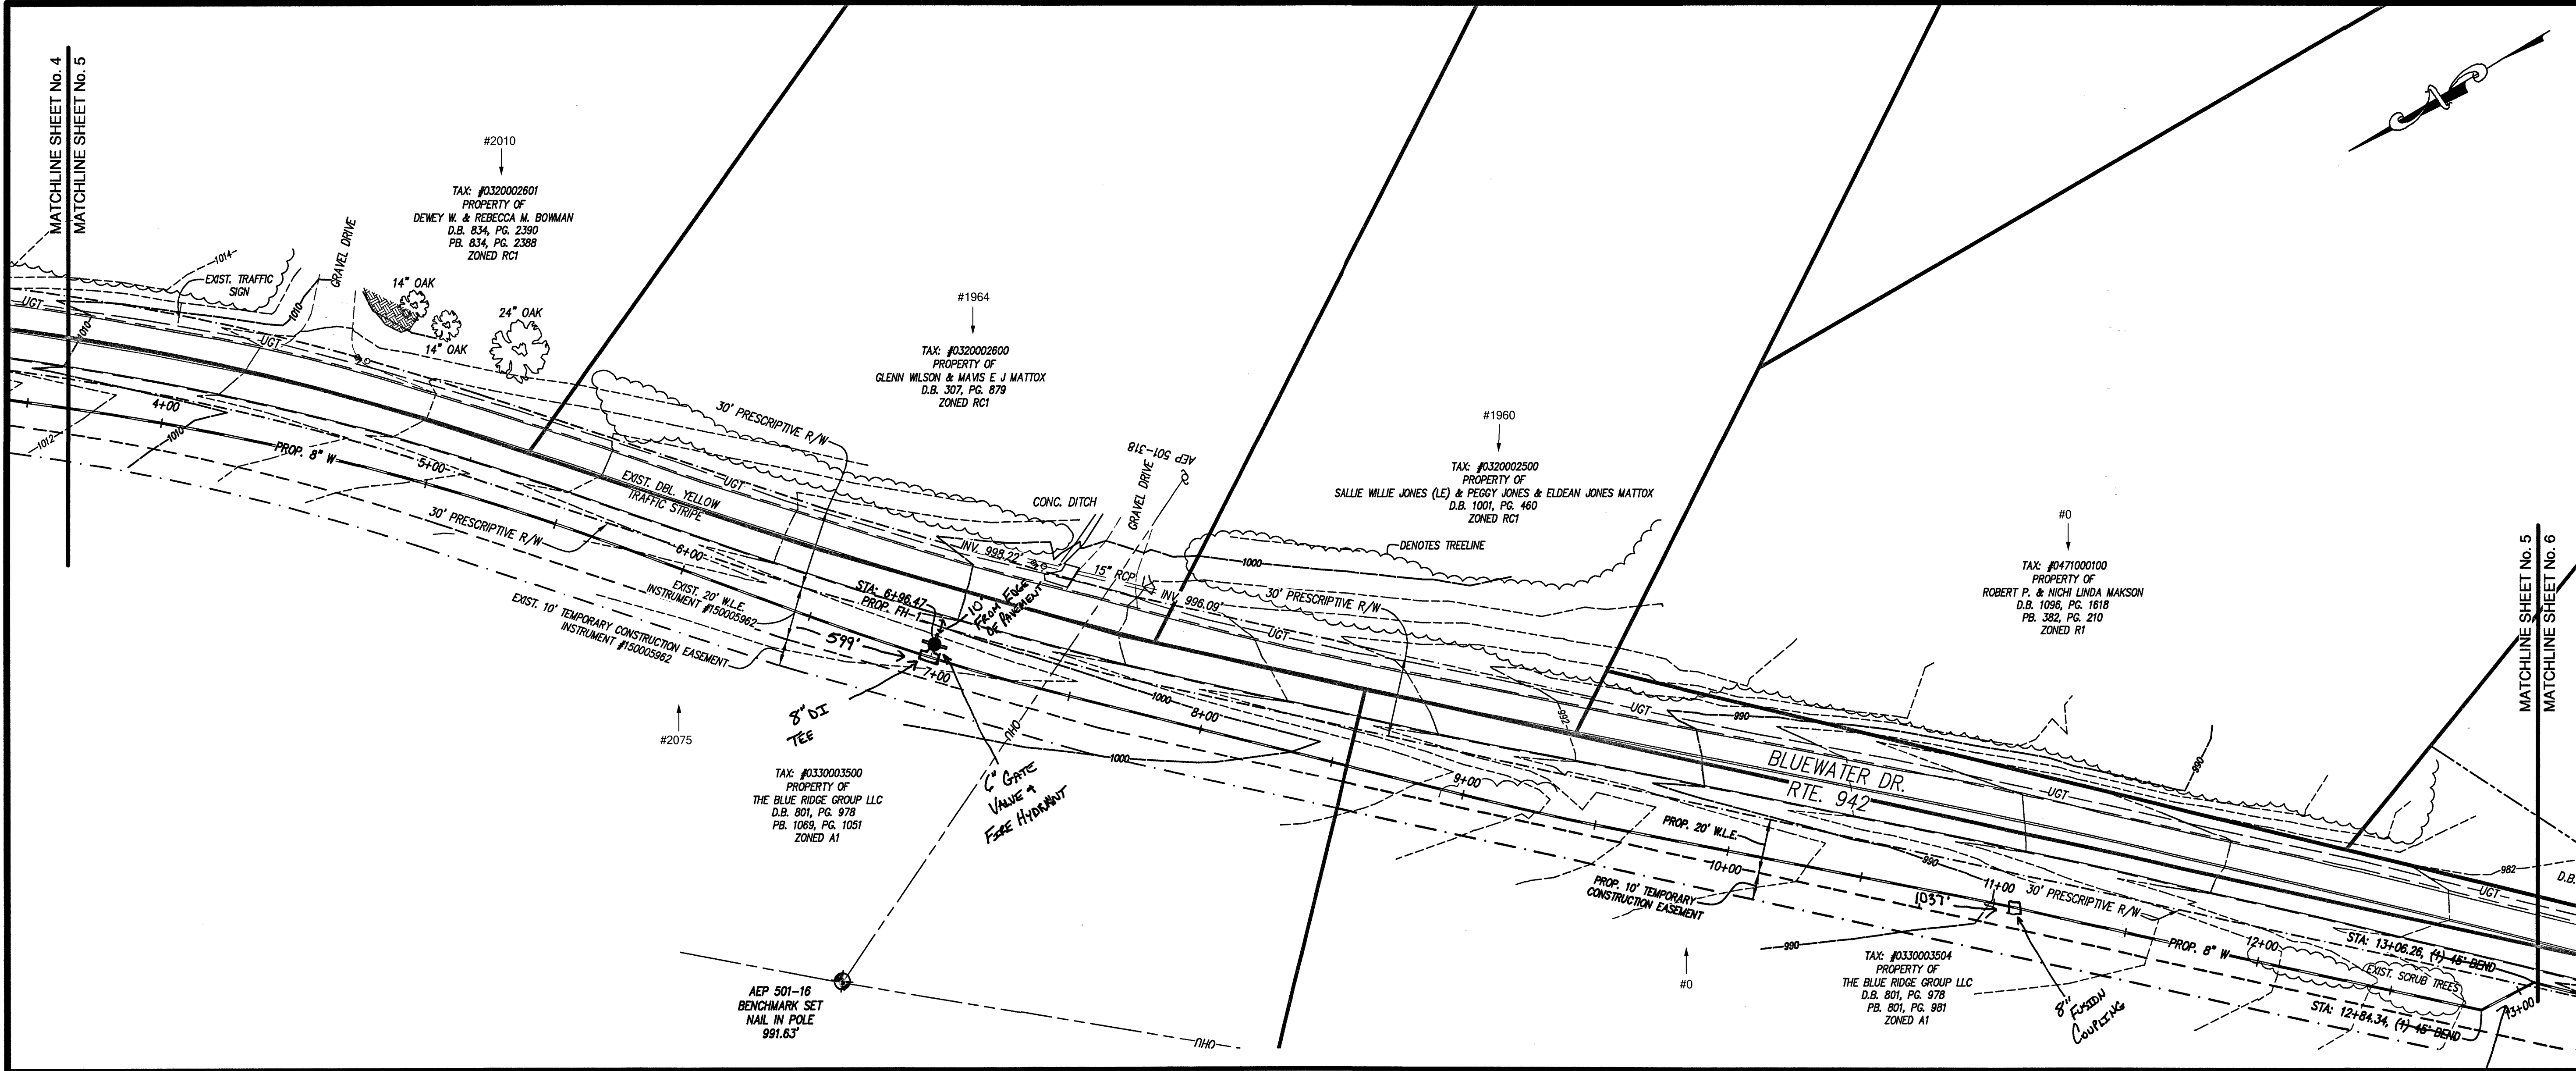

Lumsden Associates, P.C.
ENGINEERS | SURVEYORS | PLANNERS

4664 BRAMELETON AVENUE
P.O. BOX 20669
ROANOKE, VIRGINIA 24018

PHONE: (540) 774-4411
FAX: (540) 772-9445
WWW.LUMSDENPC.COM

COMMONWEALTH OF VIRGINIA

ANDREW P. LUMSDEN
Lic. No. 062218
7/22/20
PROFESSIONAL ENGINEER

PLAN & PROFILE

STRIPER'S LANDING
WATERLINE EXTENSION
PREPARED FOR
WESTERN VIRGINIA WATER AUTHORITY
SITUATED IN
FRANKLIN COUNTY, VIRGINIA

NO.	DATE	DESCRIPTION
1		
2		
3		
4		
5		

DATE: July 22, 2020
SCALE: 1" = 30'
COMMISSION NO: 19-284
SHEET 5 OF 11