
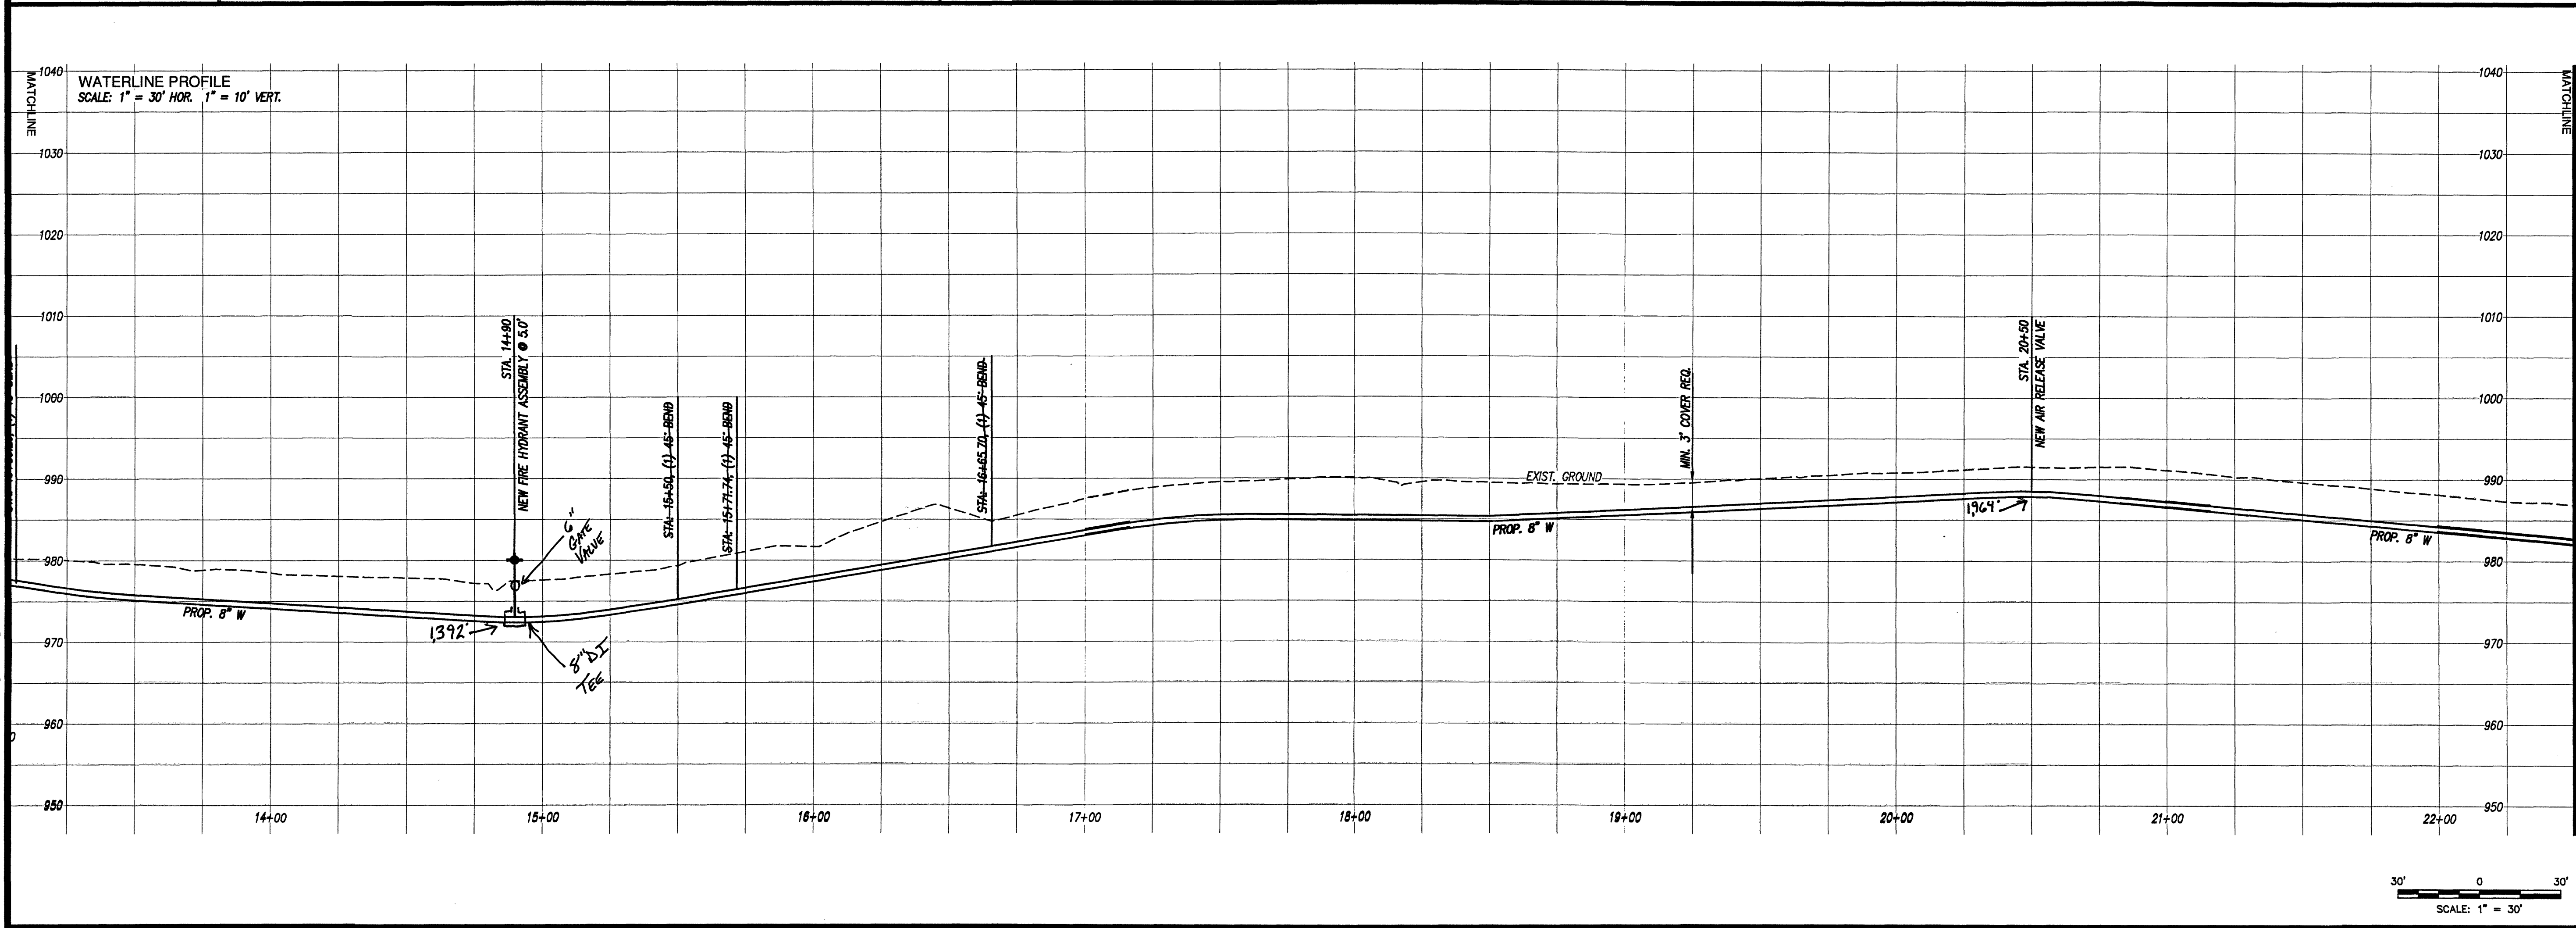


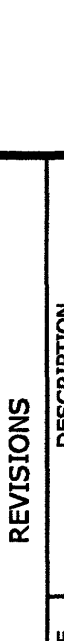

STRIPER'S LANDING WATERLINE EXTENSION PREPARED FOR WESTERN VIRGINIA WATER AUTHORITY SITUATED IN FRANKLIN COUNTY, VIRGINIA		PLAN & PROFILE				 Lumsden Associates, P.C. ENGINEERS SURVEYORS PLANNERS	
REVISIONS		PHONE: (540) 774-4411 FAX: (540) 777-9945 WWW.LUMSDENPC.COM					
NO.	DATE	DESCRIPTION					
1							
2							
3							
4							
5							

DATE: **July 22, 2020**
 SCALE: **1" = 30'**
 COMMISSION NO: **19-284**

SHEET **6** OF **11**