

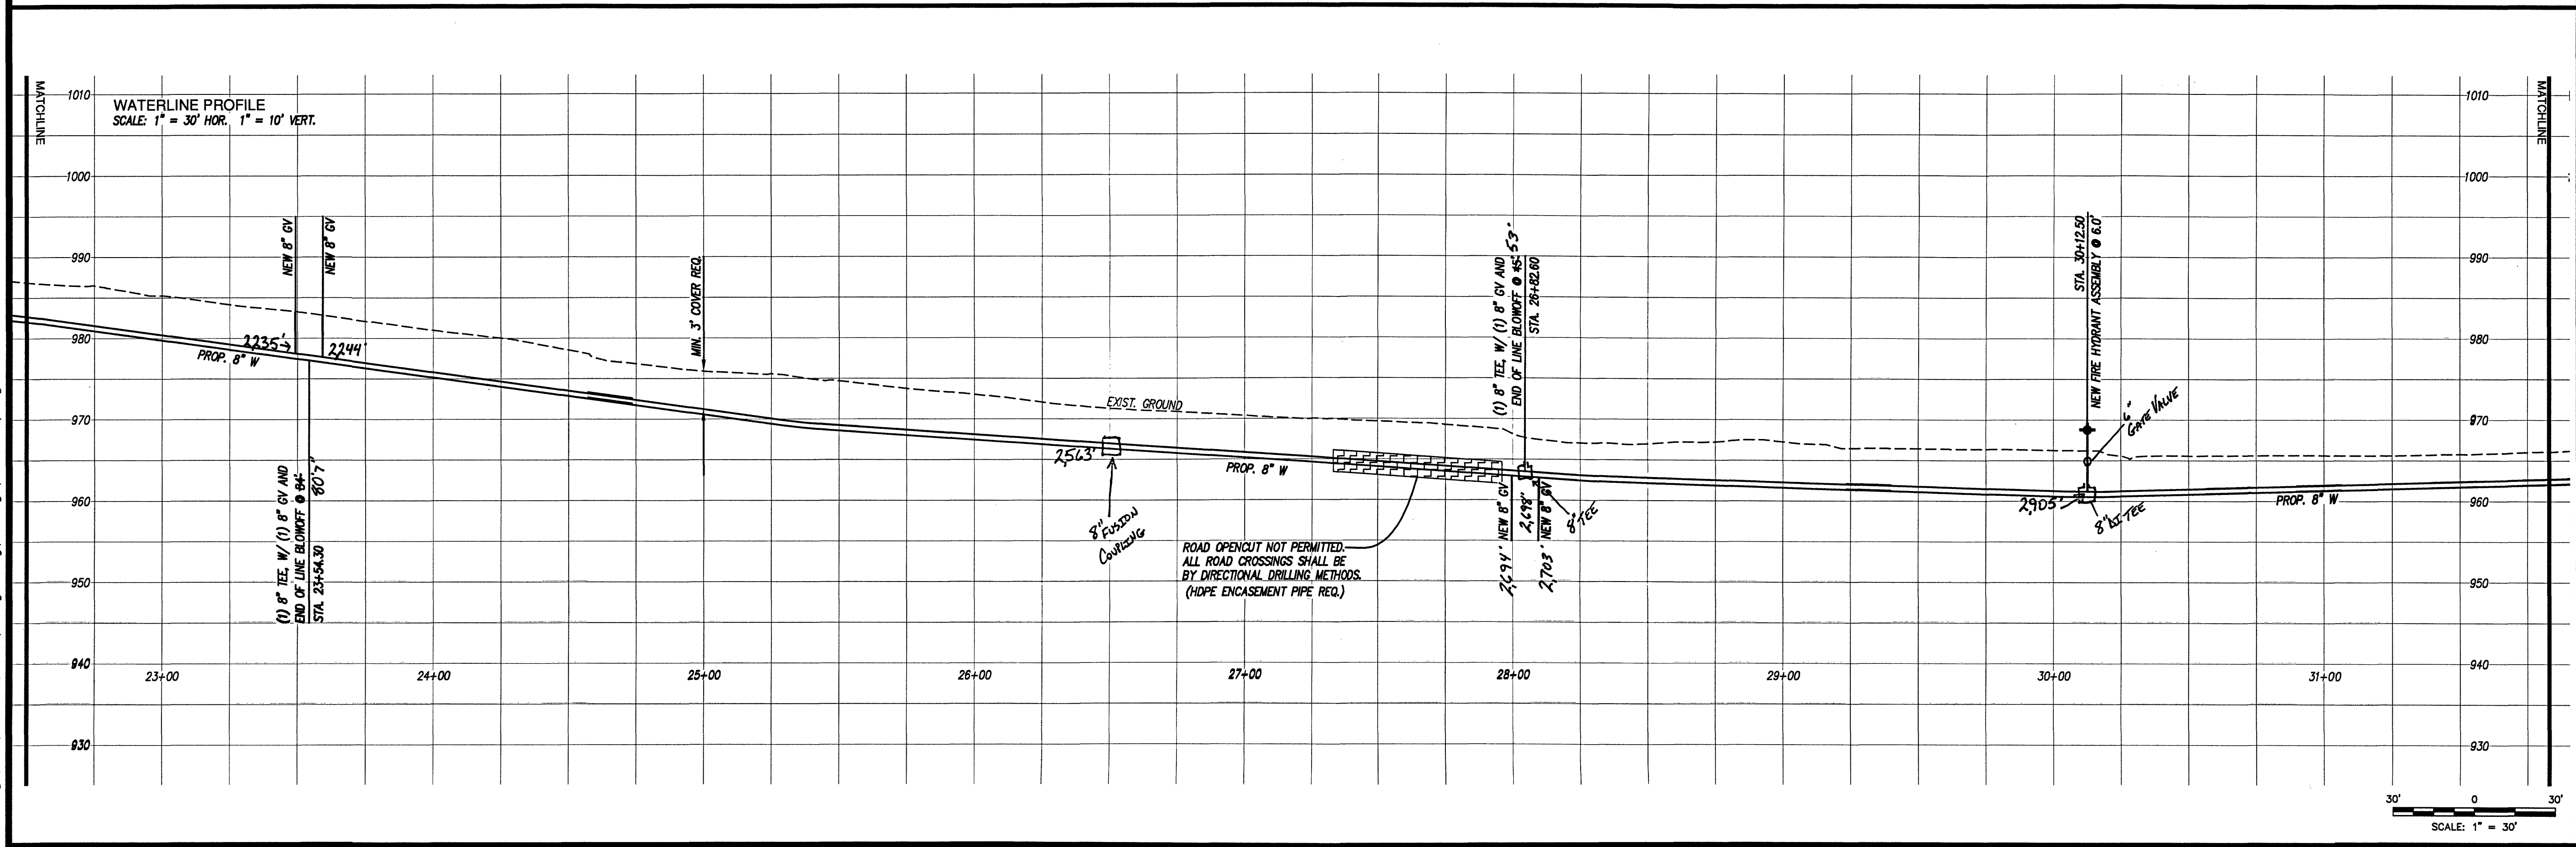


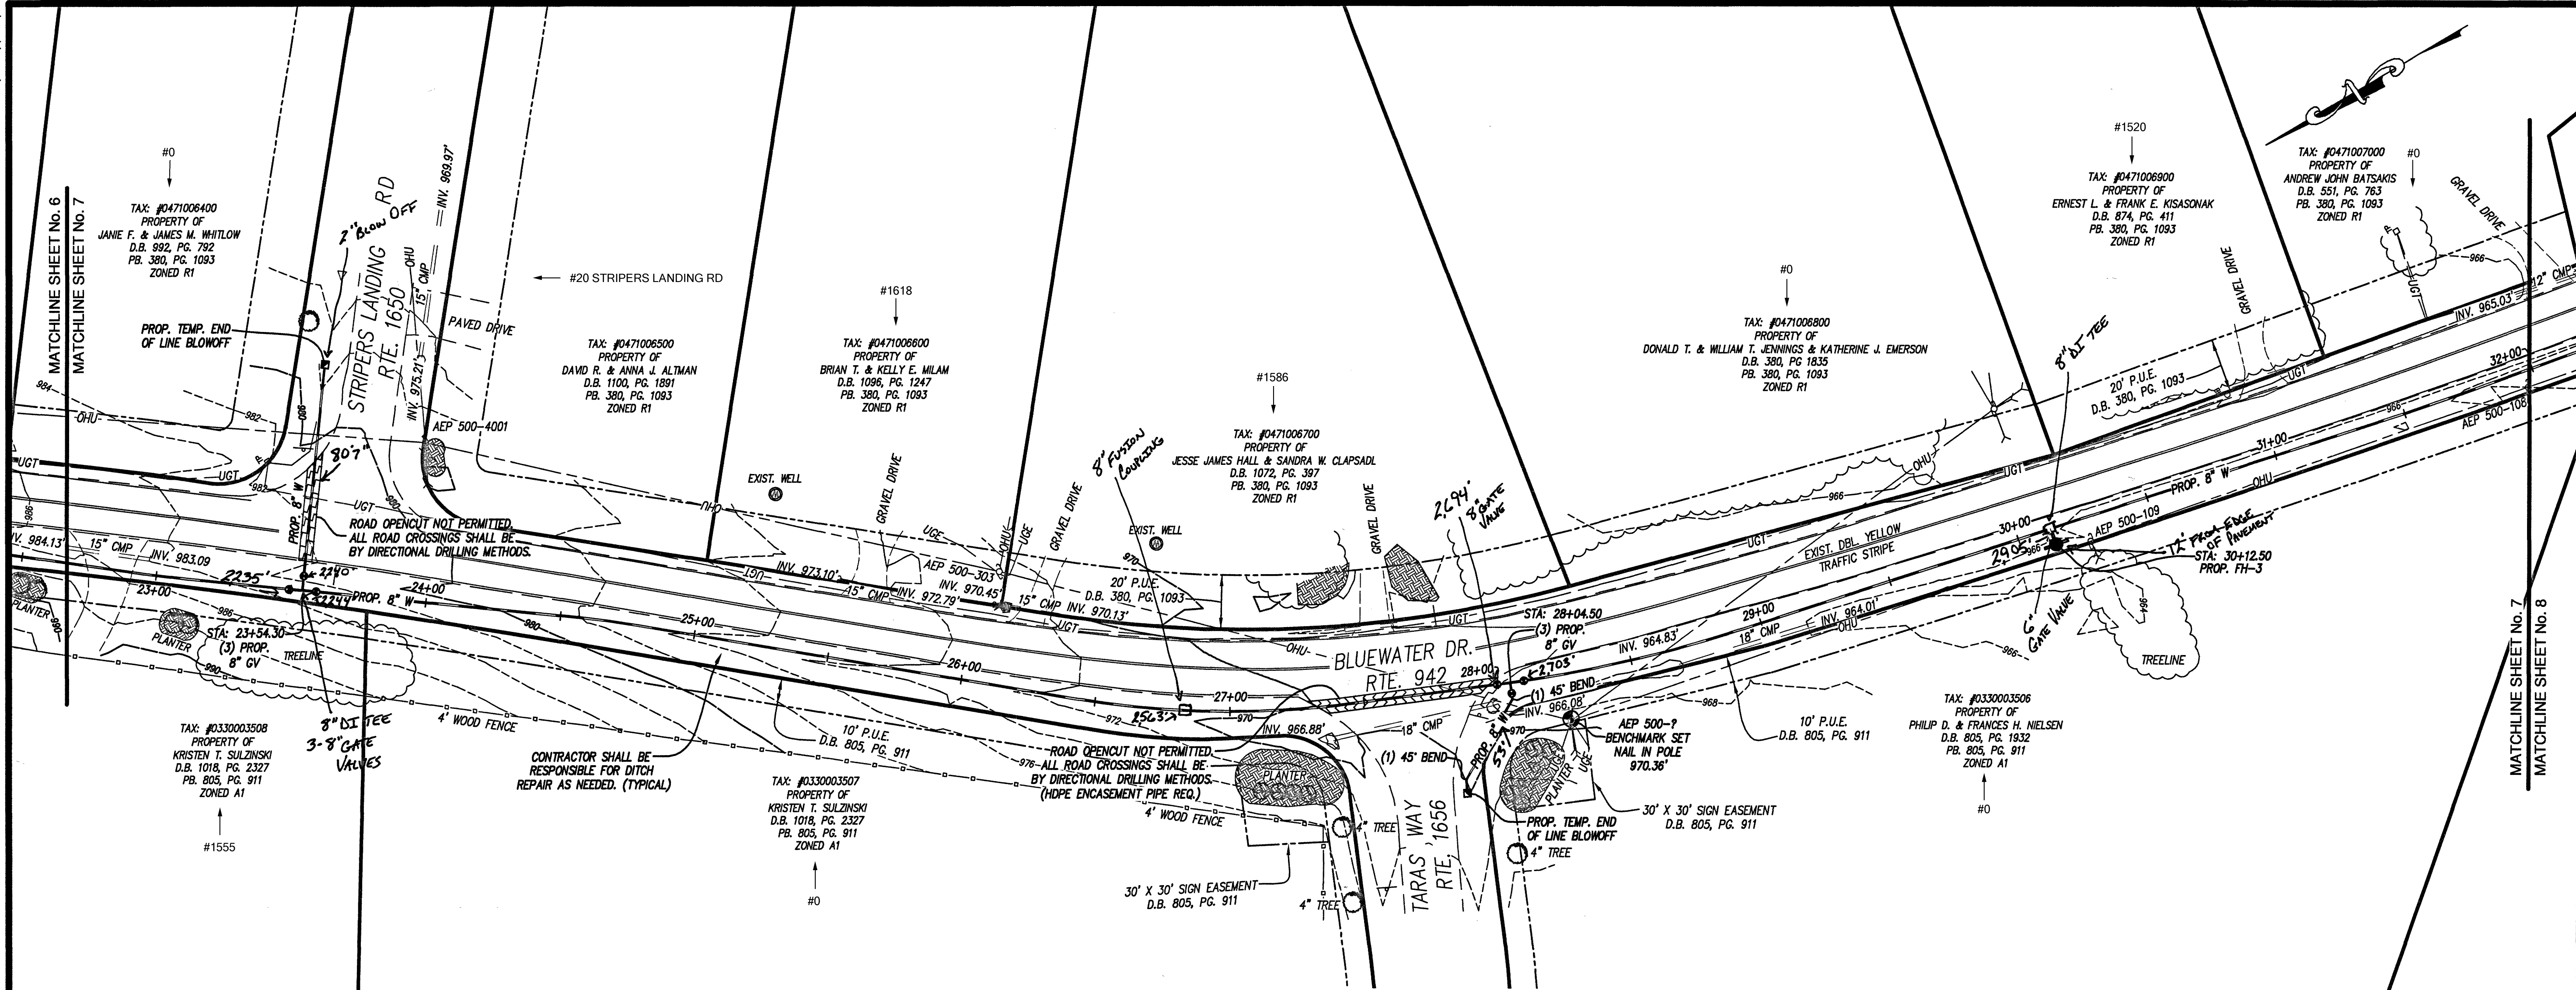

Lumsden Associates, P.C.
ENGINEERS | SURVEYORS | PLANNERS
4664 BRAMBLETON AVENUE
P.O. BOX 20665
ROANOKE, VIRGINIA 24018
PHONE: (540) 774-4411
FAX: (540) 772-9945
WWW.LUMSDENPC.COM

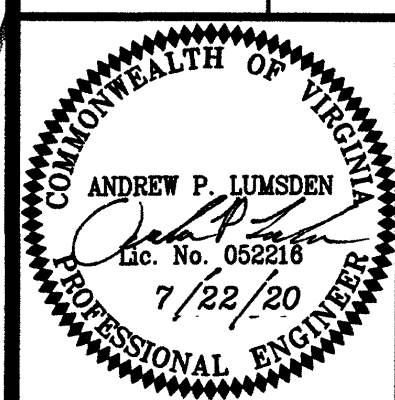

PLAN & PROFILE

**STRIPER'S LANDING
WATERLINE EXTENSION**
PREPARED FOR
WESTERN VIRGINIA WATER AUTHORITY
SITUATED IN
FRANKLIN COUNTY, VIRGINIA

REVISIONS		DATE	DESCRIPTION
NO.	1		
	2		
	3		
	4		
	5		

DATE: July 22, 2020
SCALE: 1" = 30'
COMMISSION NO.: 19-284
SHEET 7 OF 11