




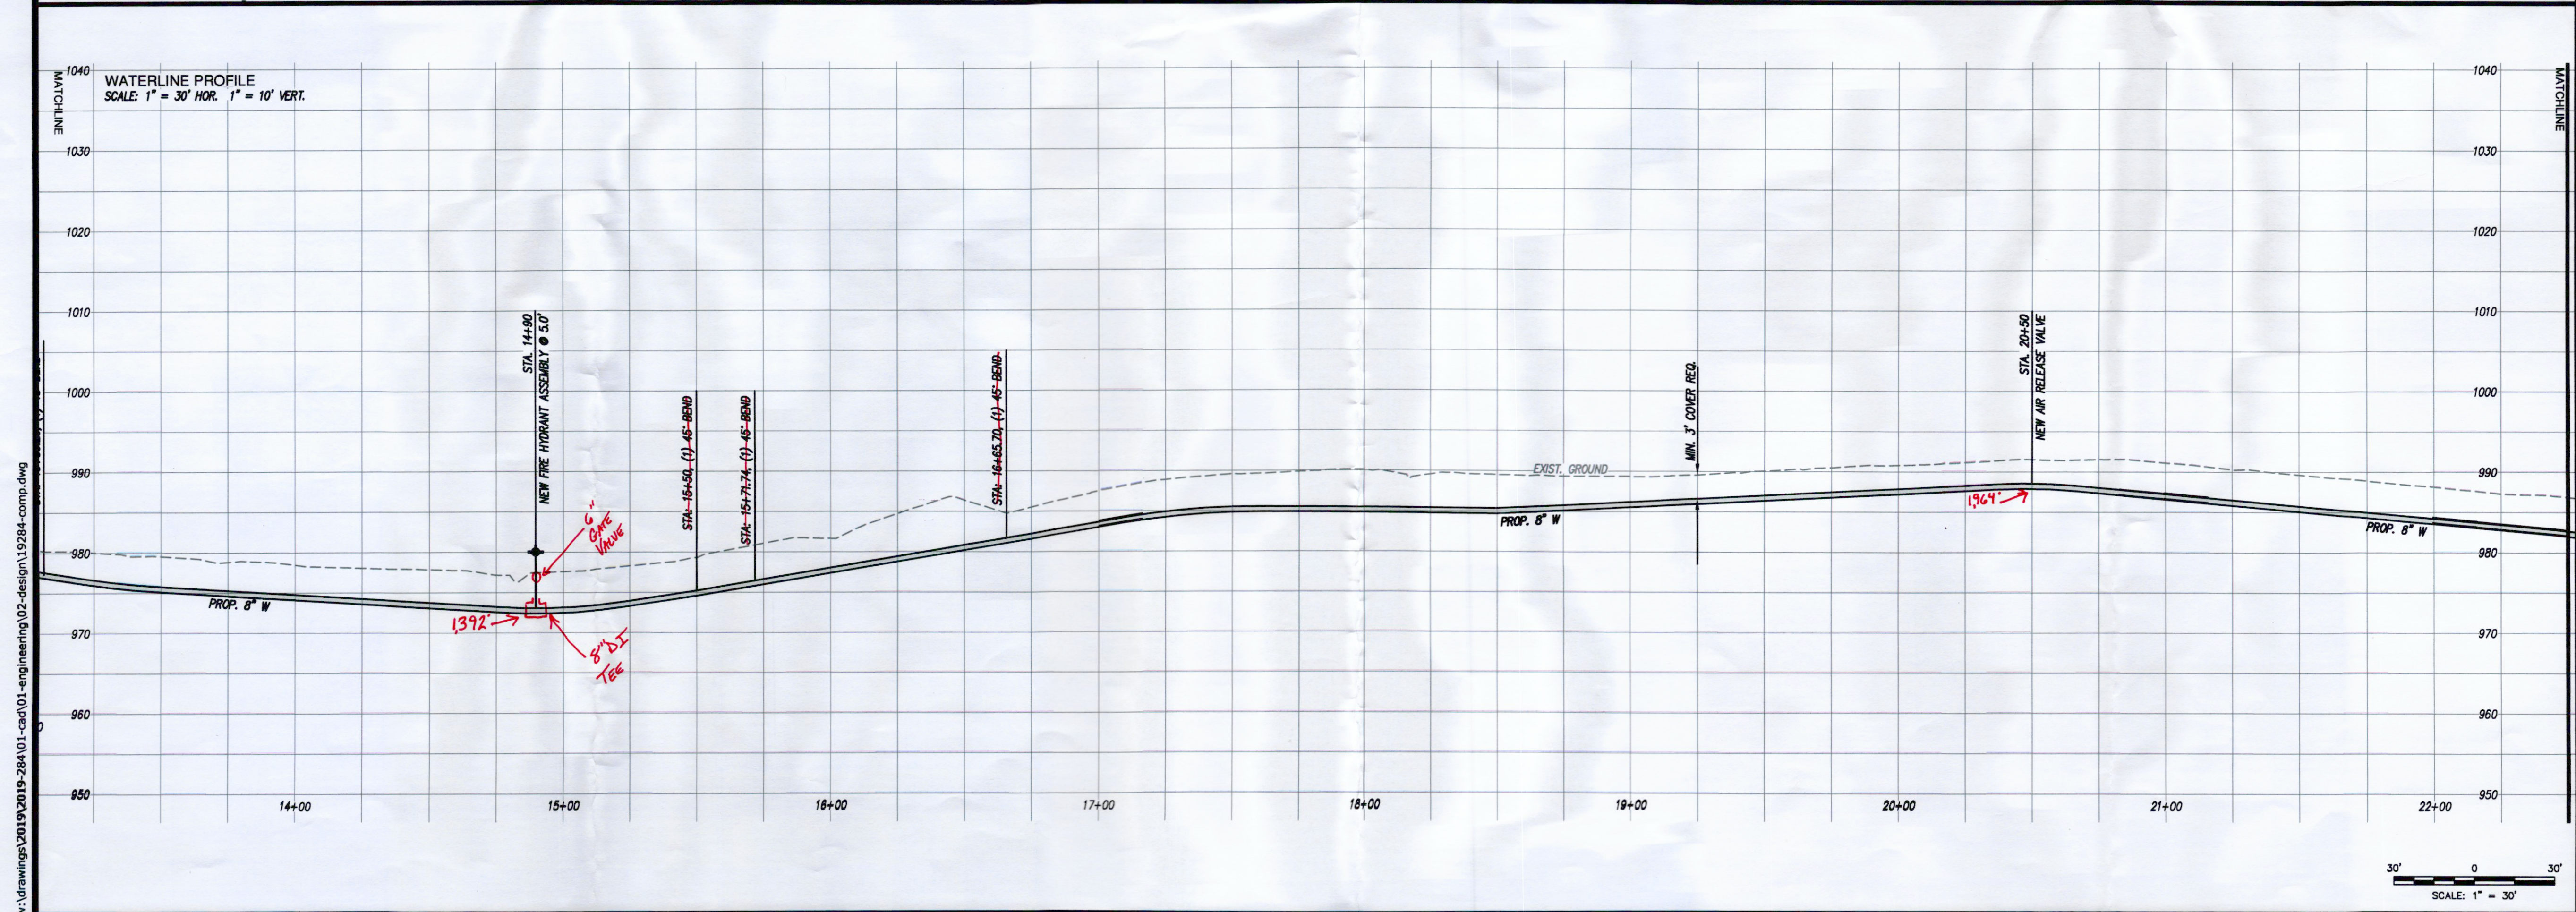

Lumsden Associates, P.C.
ENGINEERS | SURVEYORS | PLANNERS

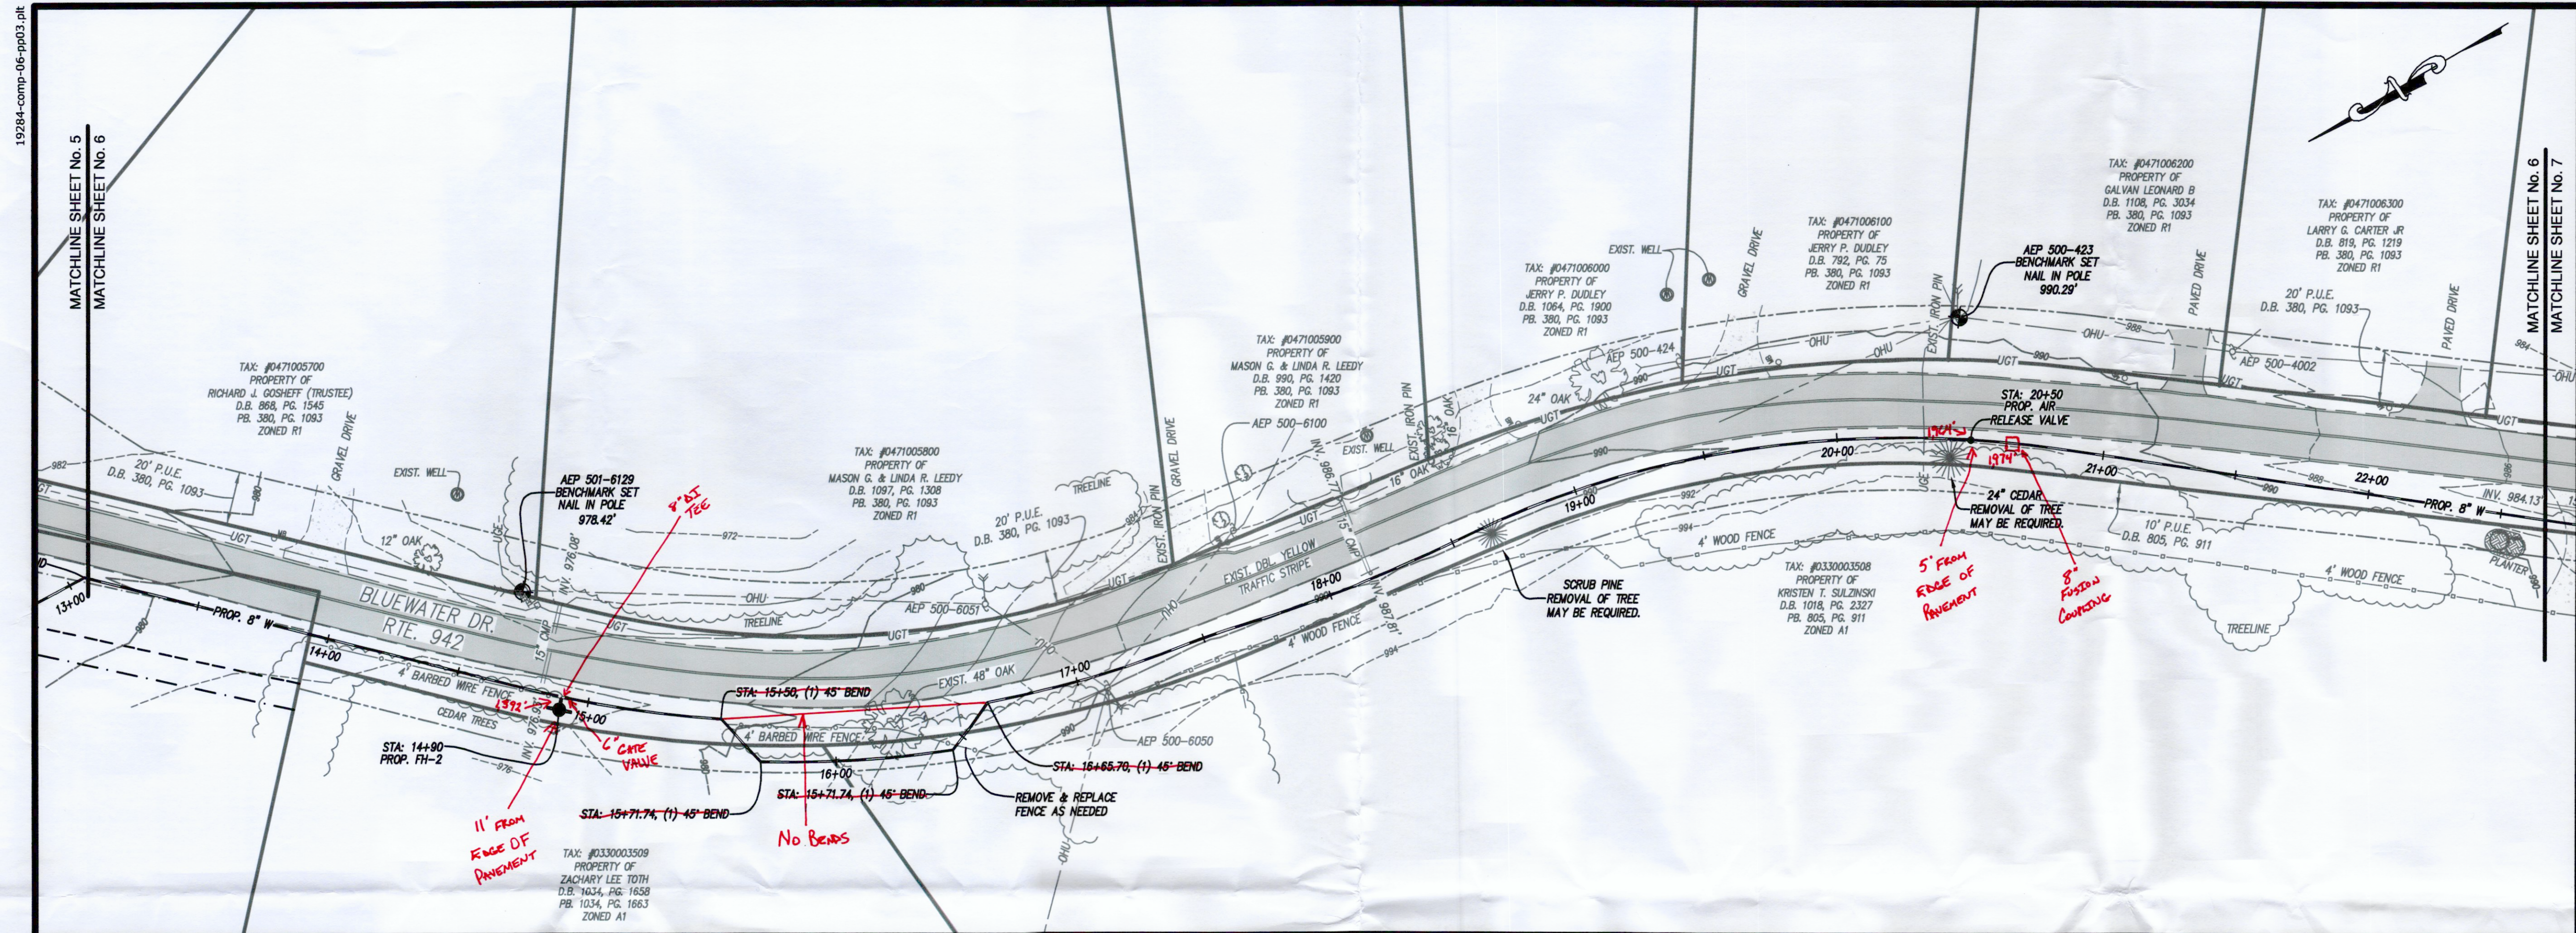

4664 BRAMBLETON AVENUE
P.O. BOX 20669
ROANOKE, VIRGINIA 24018
PHONE: (540) 774-4411
FAX: (540) 772-9445
WWW.LUMSDENPC.COM

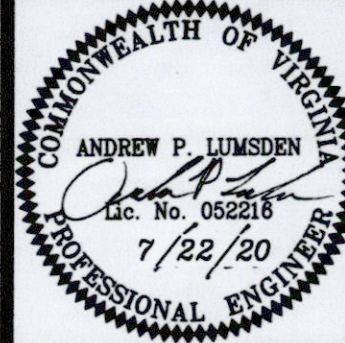

PLAN & PROFILE

**STRIPER'S LANDING
WATERLINE EXTENSION**
PREPARED FOR
WESTERN VIRGINIA WATER AUTHORITY
SITUATED IN
FRANKLIN COUNTY, VIRGINIA

REVISIONS		
NO.	DATE	DESCRIPTION
1		
2		
3		
4		
5		

DATE: July 22, 2020

SCALE:

 $1'' = 30'$

COMMISSION NO: 19-284

SHEET 6 OF 11