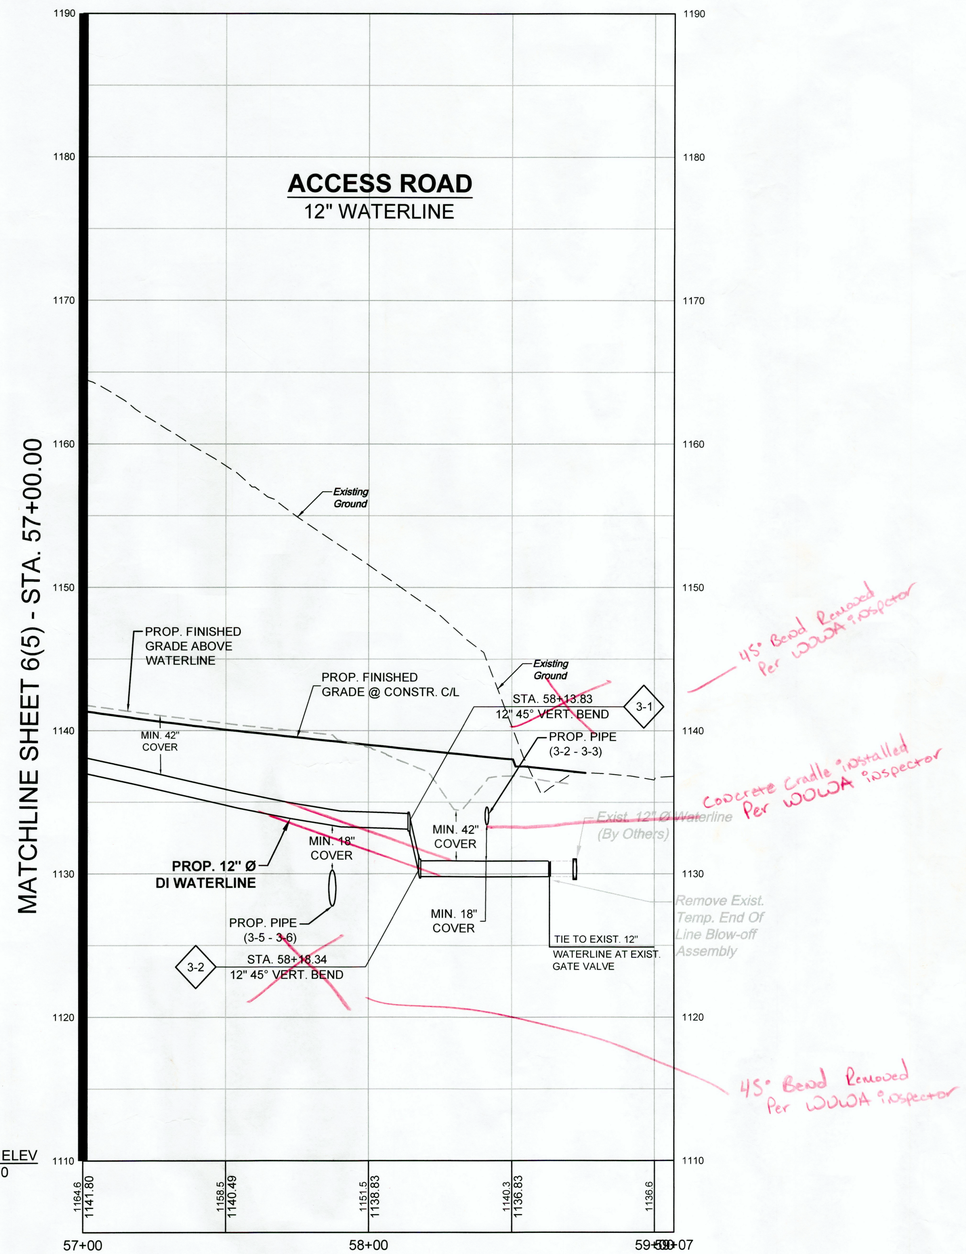


45° Bend Removed Per WOWA inspector

Concrete Cradle installed Per WOWA inspector

45° Bend Removed Per WOWA inspector

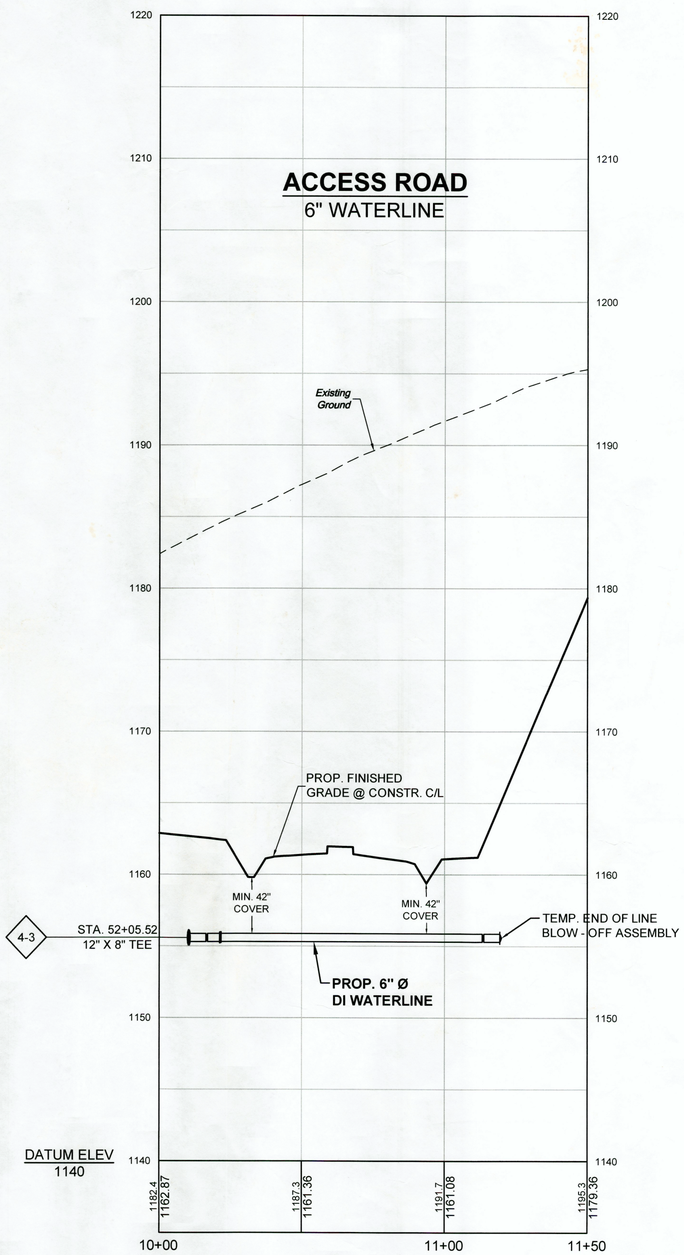

COMMONWEALTH OF VIRGINIA
CRAIG WILLIAM KRUPP
Lic. No. 0402053003
05/21/19
PROFESSIONAL ENGINEER

THIS DRAWING PREPARED AT THE
**CORPORATE OFFICE**
1001 Boulders Parkway, Suite 300 | Richmond, VA 23225
TEL 804.200.6500 FAX 804.560.1016 www.timmons.com

YOUR VISION ACHIEVED THROUGH OURS.

**Site Development | Residential | Infrastructure | Technology**

| DATE | REVISION DESCRIPTION |
|---|---|
| 08/29/18 | PER COUNTY AND VDOT COMMENTS |
| 10/03/18 | PER COUNTY AND VDOT COMMENTS |
| 03/12/19 | WATERLINE & SAN. SEWER COMMENT REVISIONS |
| 05/07/19 | ENTRANCE #1 GEOMETRIC AND DRAINAGE REVISIONS |
| 05/21/19 | SANITARY SEWER COMMENT REVISIONS |

| | |
|---|---|
| DATE | 03/30/18 |
| DRAWN BY | MRF |
| DESIGNED BY | CWK |
| CHECKED BY | CMK |
| SCALE | 1"=25' |

TIMMONS GROUP

# SUMMIT VIEW BUSINESS PARK PHASE II

BOONE DISTRICT - FRANKLIN COUNTY - VIRGINIA

## WATER & SEWER PROFILE

| | |
|---|---|
| JOB NO. | 41271 |
| SHEET NO. | 6(6) |

These plans and associated documents are the exclusive property of TIMMONS GROUP and may not be reproduced in whole or in part and shall not be used for any purpose whatsoever inclusive, but not limited to construction, bidding, and/or construction staking without the express written consent of TIMMONS GROUP.

L:\20\41271-Summit_View_II\DWG\Sheet\CD41271-2032-06(3)v.dwg | Plotted on 5/21/2019 10:20 AM | by Melvin Fleming