
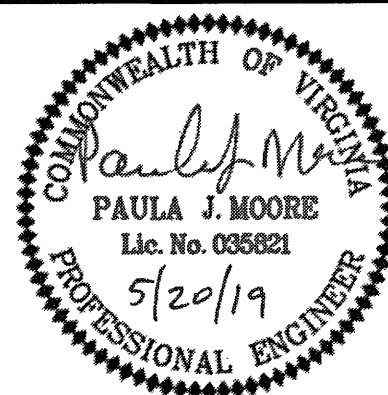


Town of Rocky Mount Water : 1- Boring Pit 1- Flushing Assembly 2- 8" Plug Valves 2- MJ Adapters

NOTE:

1. ALL PIPE MATERIALS SHALL BE AS SPECIFIED ON THE PIPE SCHEDULE SHOWN ON DRAWING C1.06.

WATER - MATCH LINE STA. 96+90 SHEET 33
SFM - MATCH LINE STA. 127+50 SHEET 33

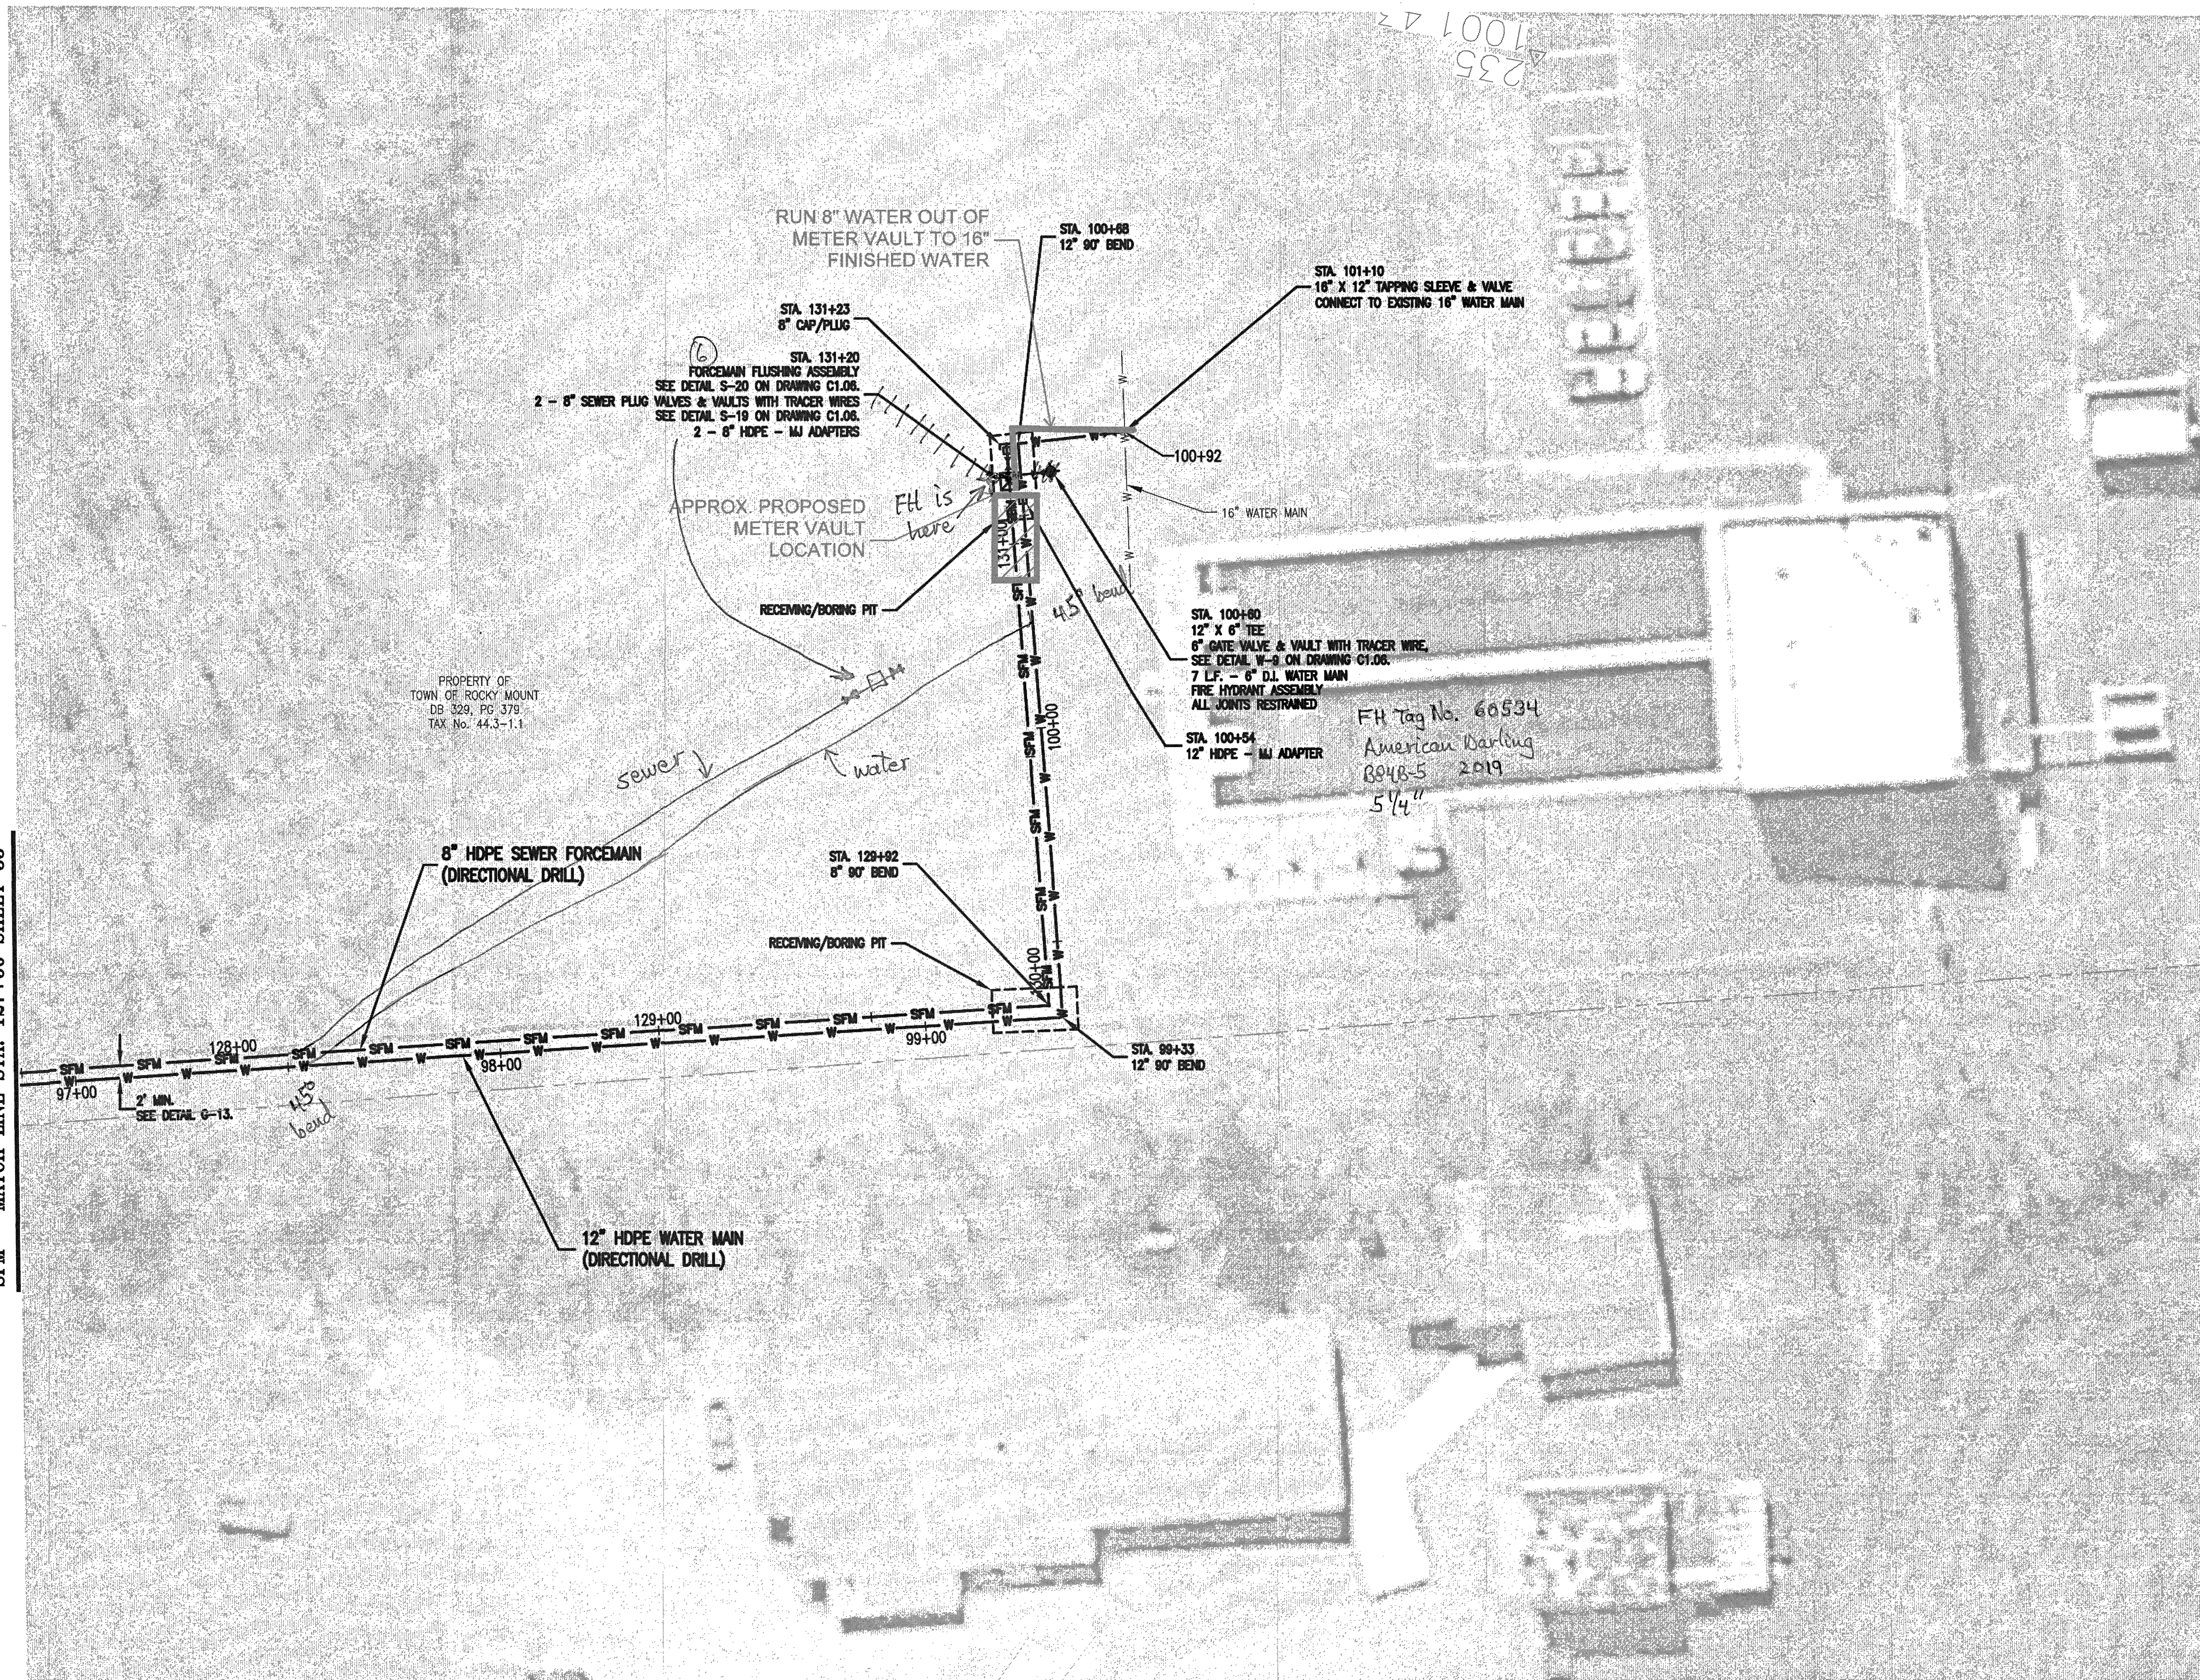

WESTERN VIRGINIA WATER AUTHORITY
601 South Jefferson Street, Suite 300
Roanoke, Virginia 24011

DES: PJM
DRAWN: JES
CHECK: GWP
DATE: 5/20/19

SCALE: AS SHOWN
HORIZ: 1" = 20'
VERT: 1" = 5'


SUMMIT VIEW BUSINESS PARK UTILITY IMPROVEMENTS
PHASE 2

8" SEWER FORCEMAIN PLAN - PROFILE
STA. 127+50 TO STA. 131+23
12" WATER MAIN PLAN - PROFILE
STA. 96+90 TO STA. 101+10

DRAWING
C1.30

SHEET
33

GRAPHIC SCALES

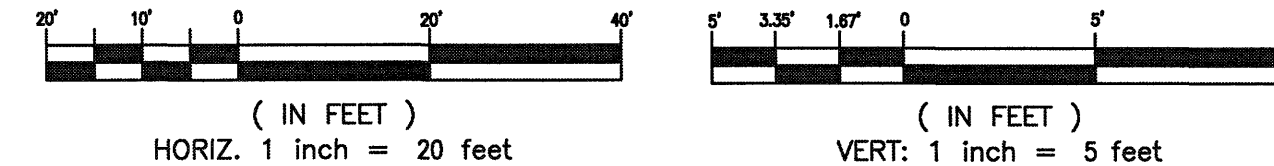

REV	DATE	DESCRIPTION