


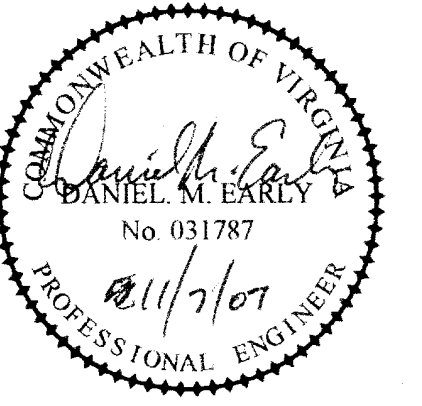

**ACS
DESIGN**

ENGINEERING • SURVEYING
LANDSCAPE ARCHITECTURE
CONSTRUCTION MANAGEMENT

2203 PETERS CREEK ROAD
ROANOKE, VIRGINIA 24017
P 540.562.2345 F 562.2344
INFO@ACSDSIGNLLC.COM
WWW.ACSDSIGNLLC.COM


The Coves at Smith Mountain Lake
Optima Properties-Smith Mountain Lake, LLC
Franklin County, Virginia

DRAWN BY: dme
DESIGNED BY: dme
CHECKED BY: XXX
DATE: 15 May 2006
JOB NUMBER: 05271

REVISIONS:	
No. 1	08/28/2006
No. 2	05/11/2007
Final For Construction	
No. 3	11/7/2007
Delete Automatic Blowoff Note	
No. 4	

SHEET NO.:
C1.14

COVES ROAD
ROAD & UTILITY
PROFILE

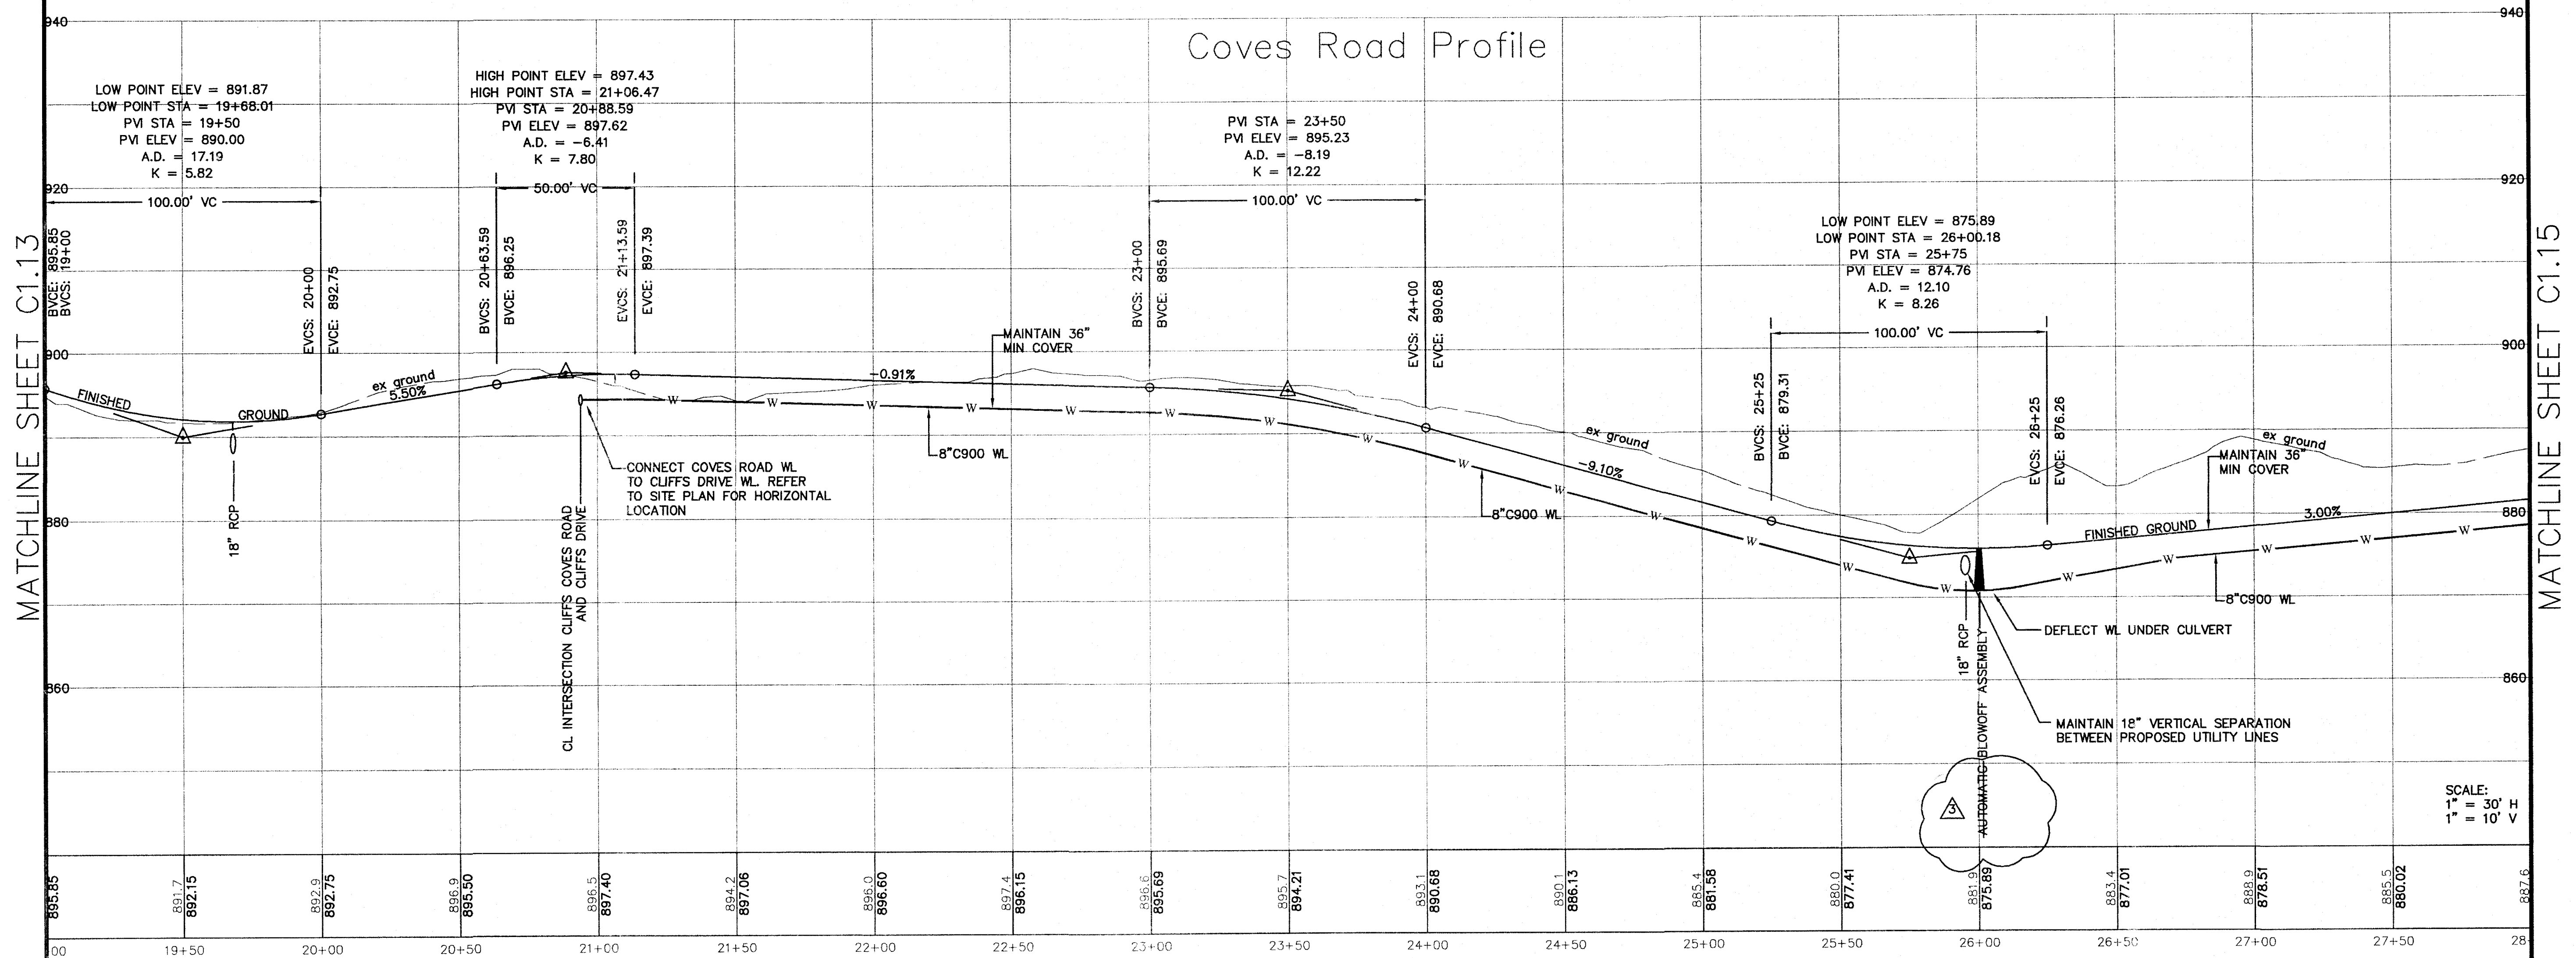

NOTE:
THE UTILITY PROFILE INDICATED HEREON FOR THE WATERLINE
SHALL BE REPRESENTATIVE OF THE PROPOSED COMMON LOW
PRESSURE FORCEMAIN PROPOSED FOR INSTALLATION ON THIS
ROAD. THE SEWER FORCEMAIN SHALL BE INSTALLED IN THE
EXACT SAME CONFIGURATION AS THE WATERLINE INCLUDING
ALL AIR RELEASE ASSEMBLIES. REFER TO THE SITE PLAN
FOR HORIZONTAL LOCATION OF THE SEWER FORCEMAIN.