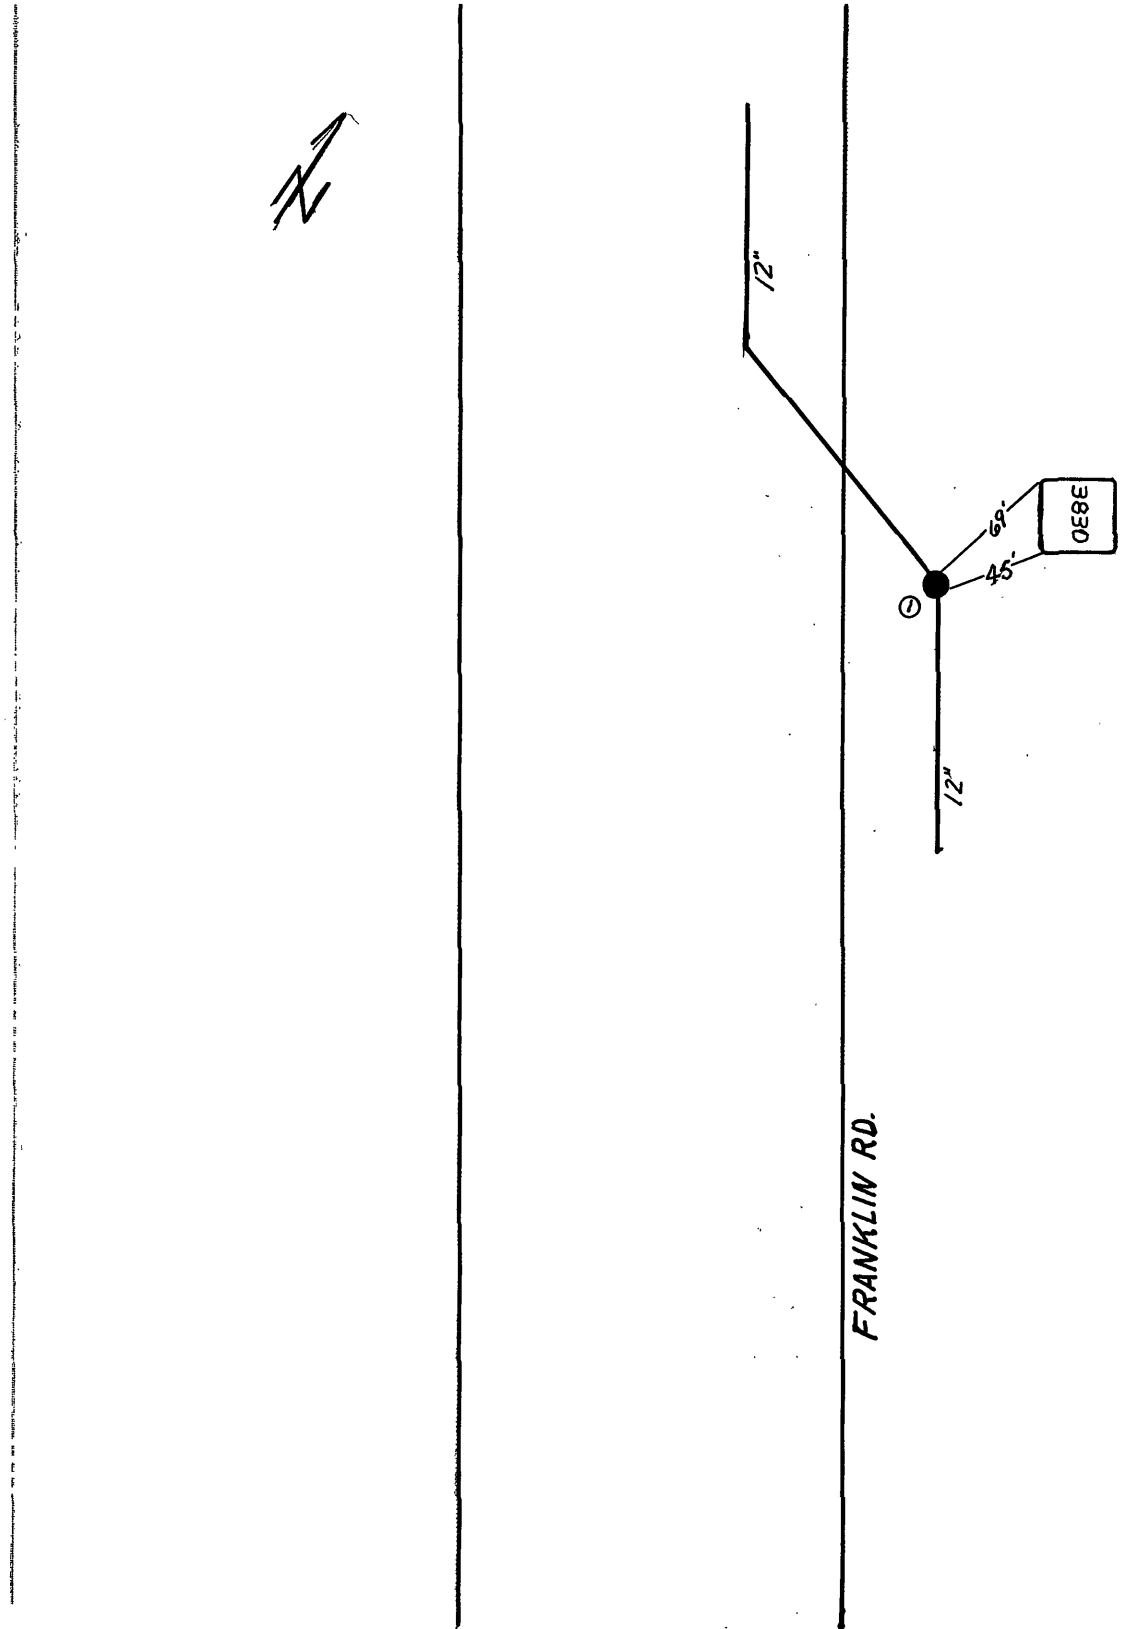

DATE	NO.	SIZE	VALVE	OPEN	TURNS
5-79	1	12"	MUELLER	R	

CITY OF ROANOKE - WATER DEPT

VALVE DIAGRAM

IN FRONT 3830 FRANKLIN RD. S.W.

SEC. & P

DATE PAGE NO.