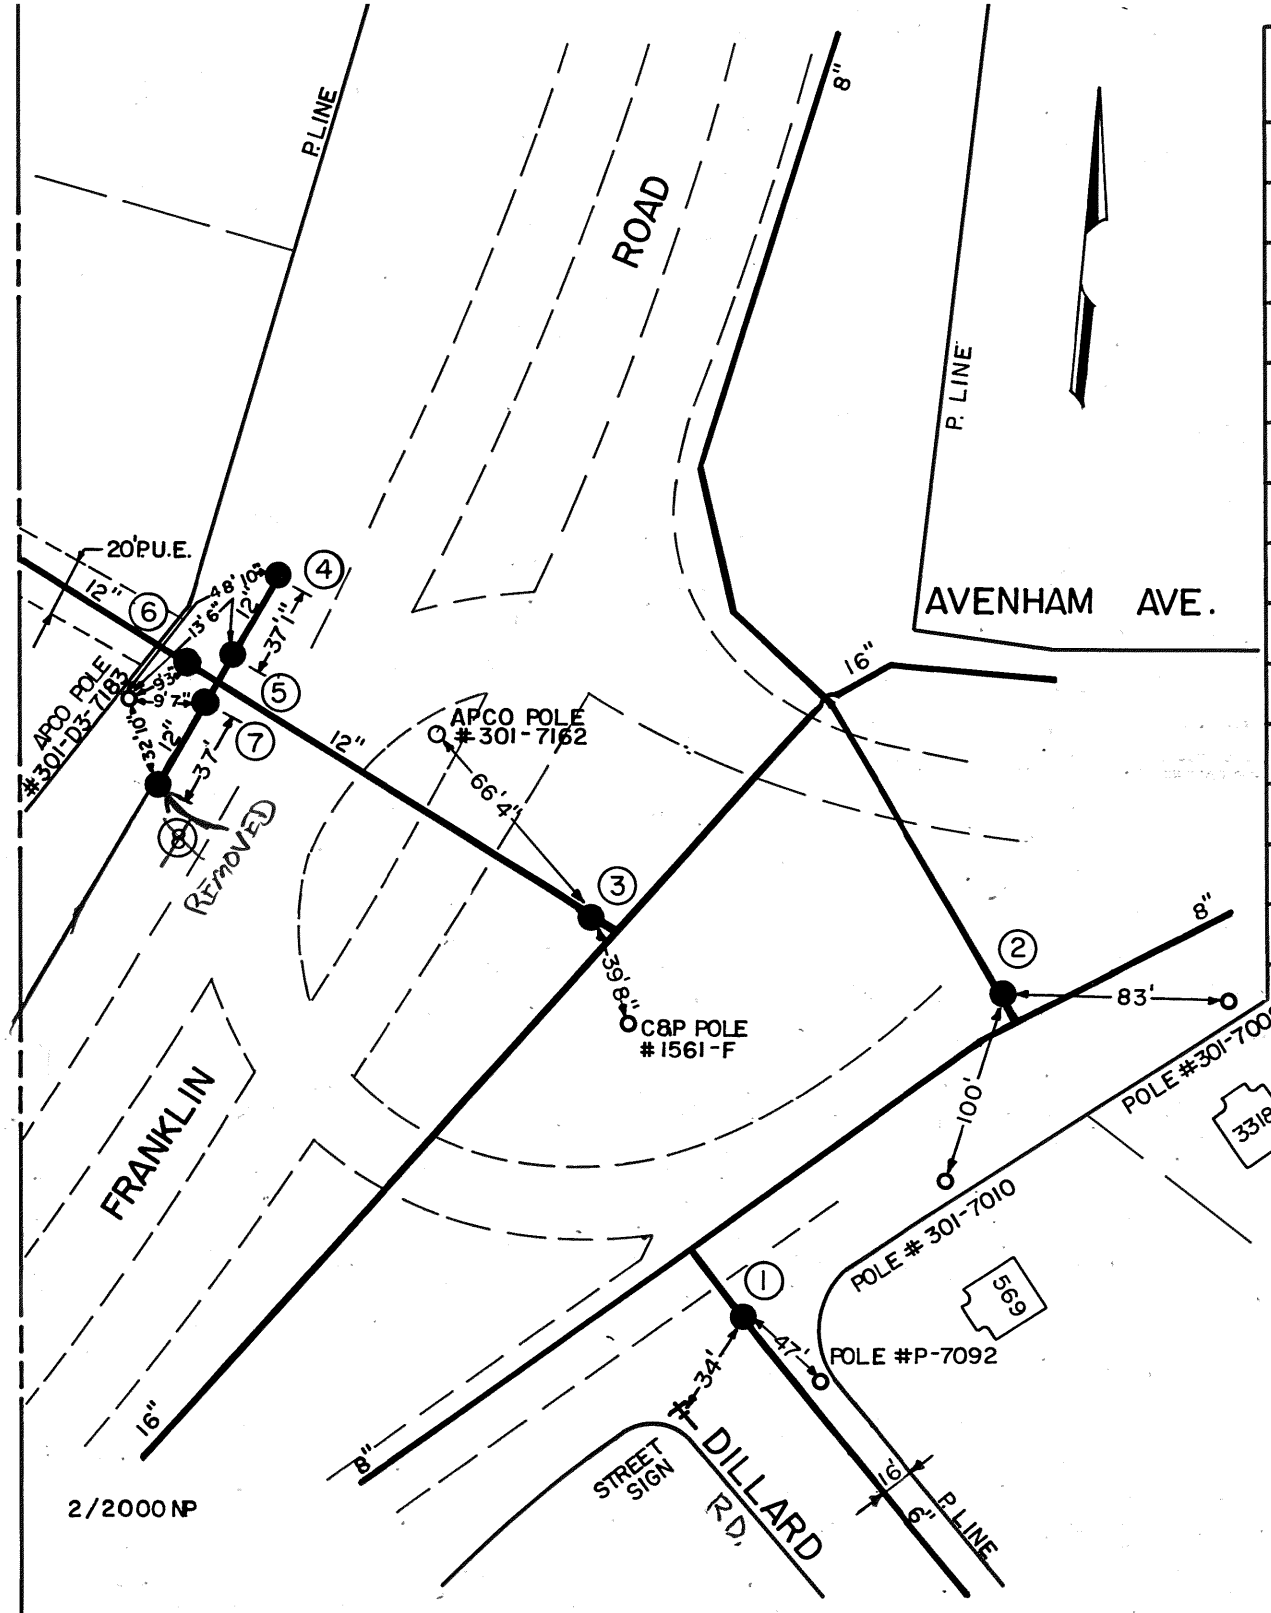

DATE	NO.	SIZE	MAKE	OPEN	TURNS
WR 1951	1	6"	DARLING	R	21
1970	2	8"	MUELLER	R	27
1998	3	12"		R	39
1998	4	2"	BLOW OFF		
1998	5	12"		R	39
1998	6	12"		R	39
1998	7	12"		R	39
~~1998~~	~~8~~	~~2"~~	~~BLOW OFF~~		
	1	16'-N	SPL		

CITY OF ROANOKE - WATER DEP'T.

VALVE DIAGRAM

AVENHAM AVENUE

DILLARD ROAD

FRANKLIN ROAD

SEC. MAP 129,130 S.W.

DATE: PAGE NO.