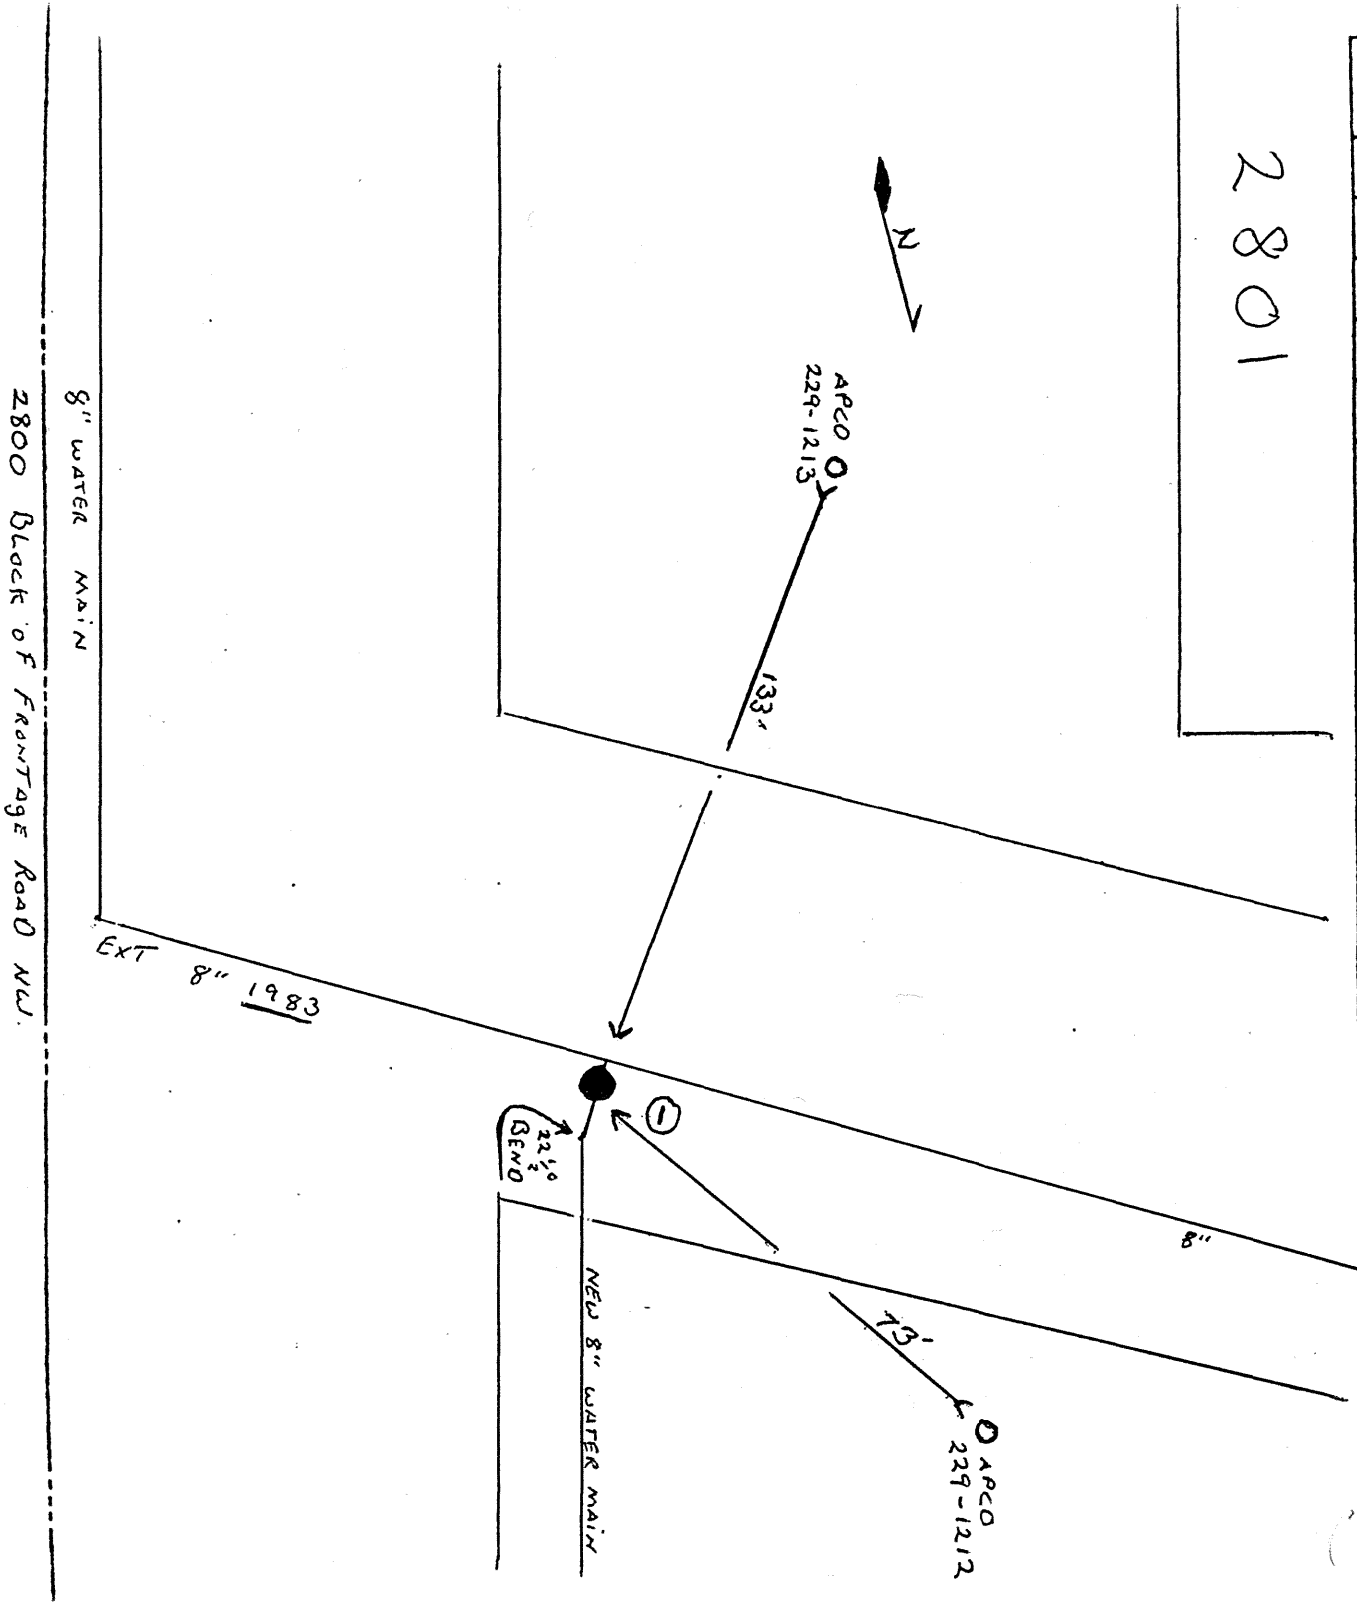

DATE	NO.	SIZE	MAKE	OPEN	TURNS
11/97	1	8	MULL	R	27

CITY OF ROANOKE—WATER DEP'T

VALVE DIAGRAM

2800 Block of Frontage Road NW

SEC. MAP 645

DATE 11-21-97 PAGE NO.