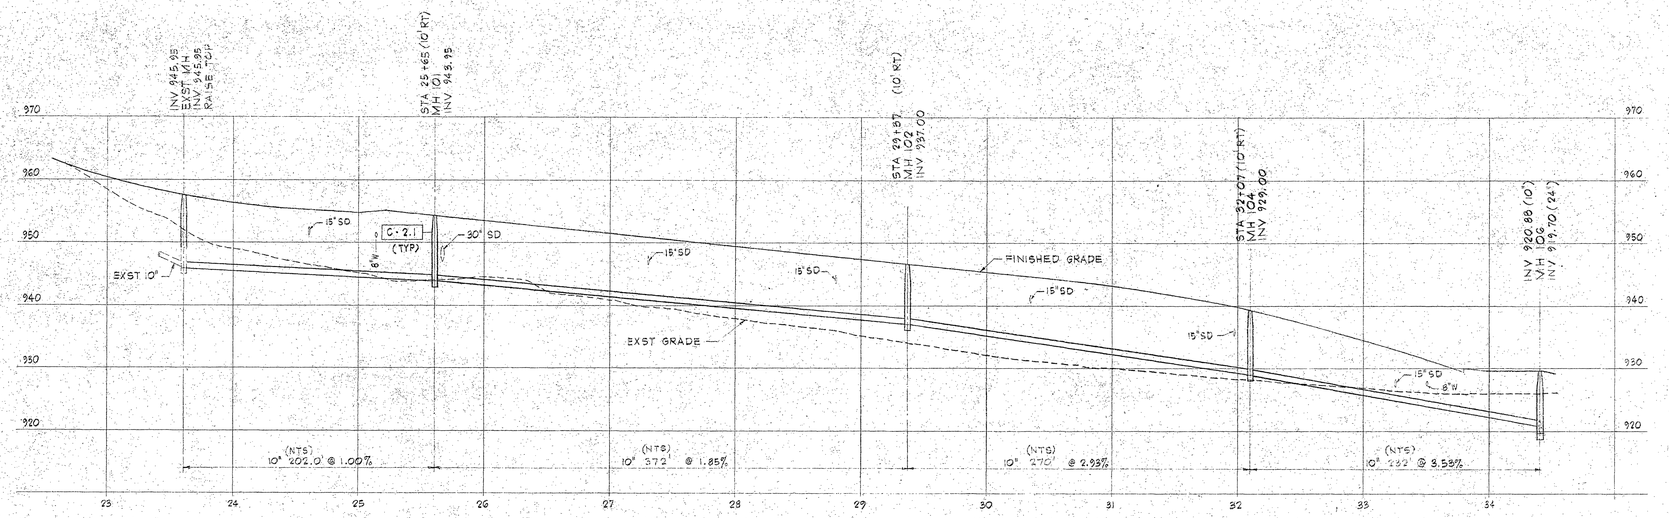

MADISON AVENUE
SCALE- HORIZ - 1"=50'
VERT - 1"=10'

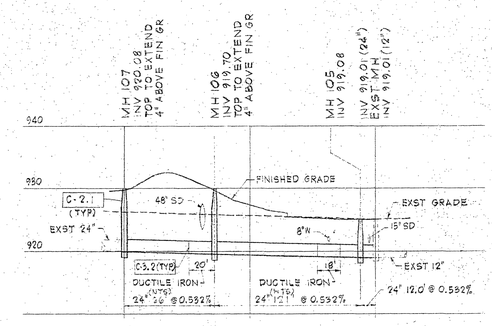

RELOCATED 24" LINE
SCALE- HORIZ - 1"=50'
VERT - 1"=10'

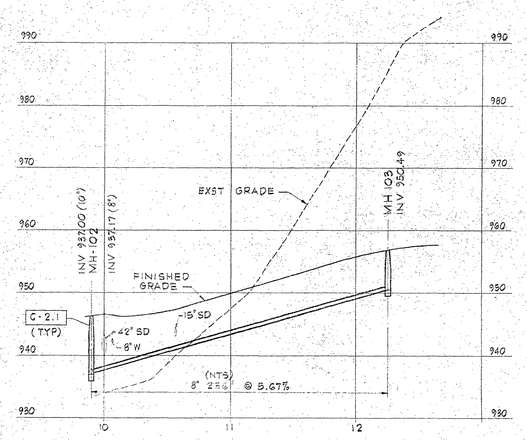

SYDNOR CIRCLE
SCALE- HORIZ - 1"=50'
VERT - 1"=10'

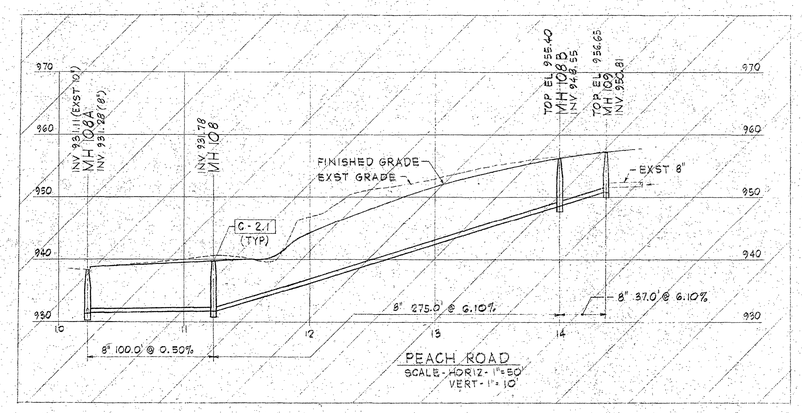

PEACH ROAD
SCALE- HORIZ - 1"=50'
VERT - 1"=10'

AS BUILT
DRAWING

REVISION	DATE	DESCRIPTION	BY	APP.
1	8-1-79	AS BUILT	JHW	[illegible]

COMMONWEALTH OF VIRGINIA
JAMES M. STRICKLAND, JR.
No. 1378
CERTIFIED PROFESSIONAL ENGINEER

DESIGNED JHW
DRAWN JHW
CHECKED [illegible]
APPROVED [illegible]
SUBMITTED [illegible]

ORANGE AVENUE INDUSTRIAL PARK
SECTION 4 GAINSBORO NDP - ROANOKE, VIRGINIA
EDA PROJECT NO. 01-01-01301

SANITARY SEWER PROFILES PART 1 & PART 2

HAYES, SEAY, MATTERN & MATTERN
ARCHITECTS - ENGINEERS - PLANNERS
ROANOKE, VIRGINIA — RICHMOND, VIRGINIA
VIRGINIA BEACH, VIRGINIA — WASHINGTON, D.C.

SCALE AS NOTED
COMM. NO. 3930
DATE AUG 16, 1976
SHEET 6

5409-4