PLAN
SURVEYED
PLOTTED
NOTE BOOK
No.
DATE
BY
ALIGNMENT CHECKED.
R/W DRAWN & ADDITIONS CHECKED.

PROFILE
SURVEYED
PLOTTED
NOTE BOOK
No.
DATE
BY
LP AXES CHECKED.
B. M.'s NOTED.
STRUCTURE ADDITIONS CHECKED.

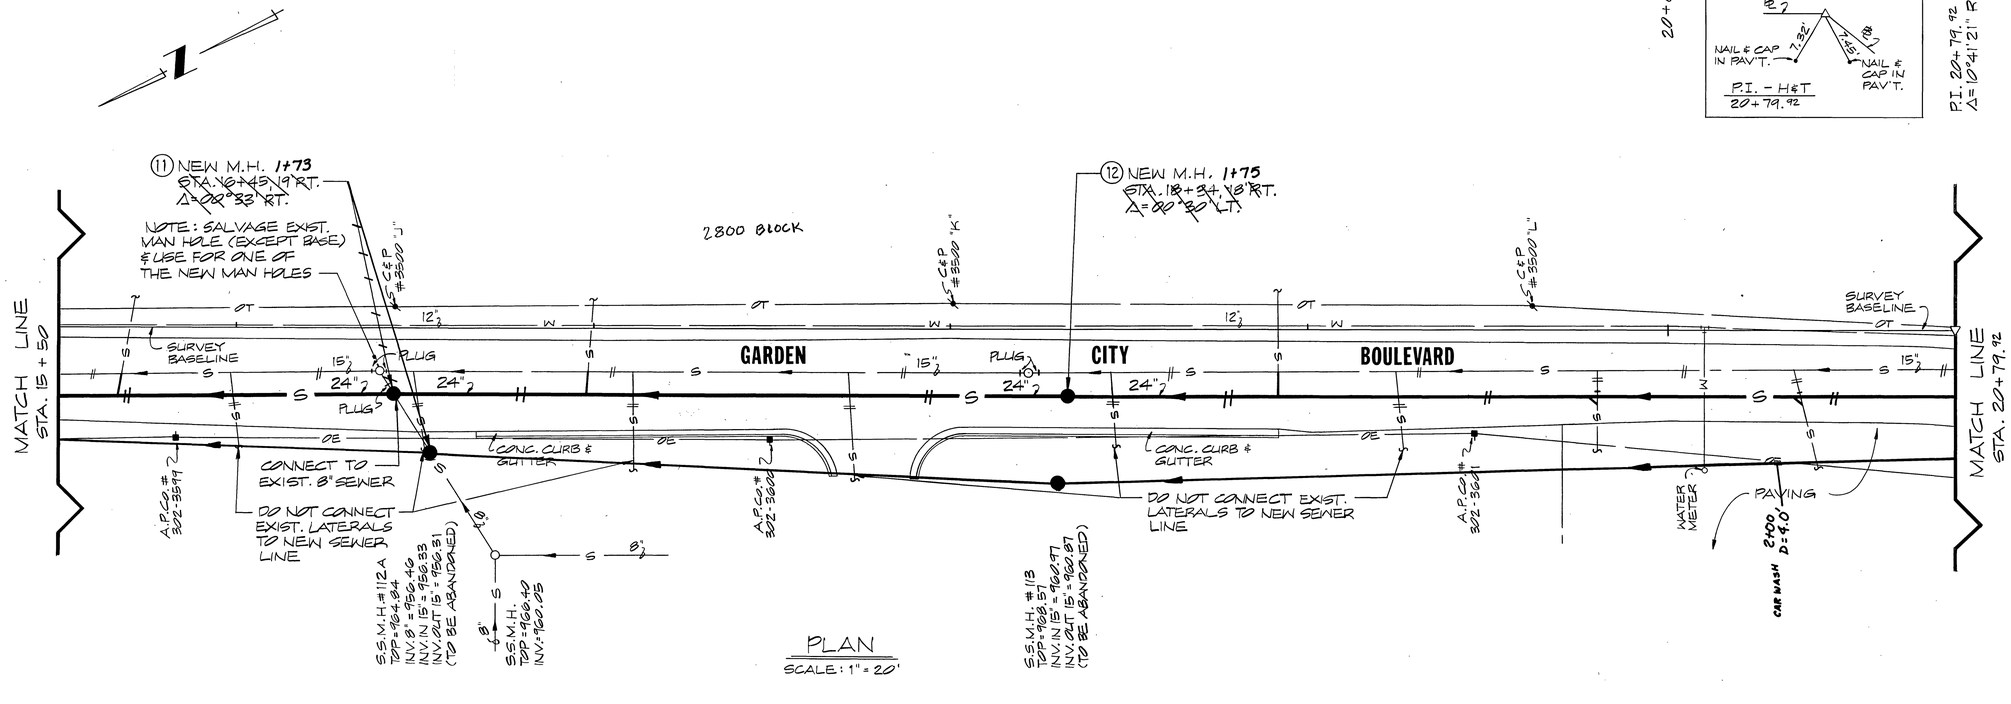

PLAN
SCALE: 1" = 20'

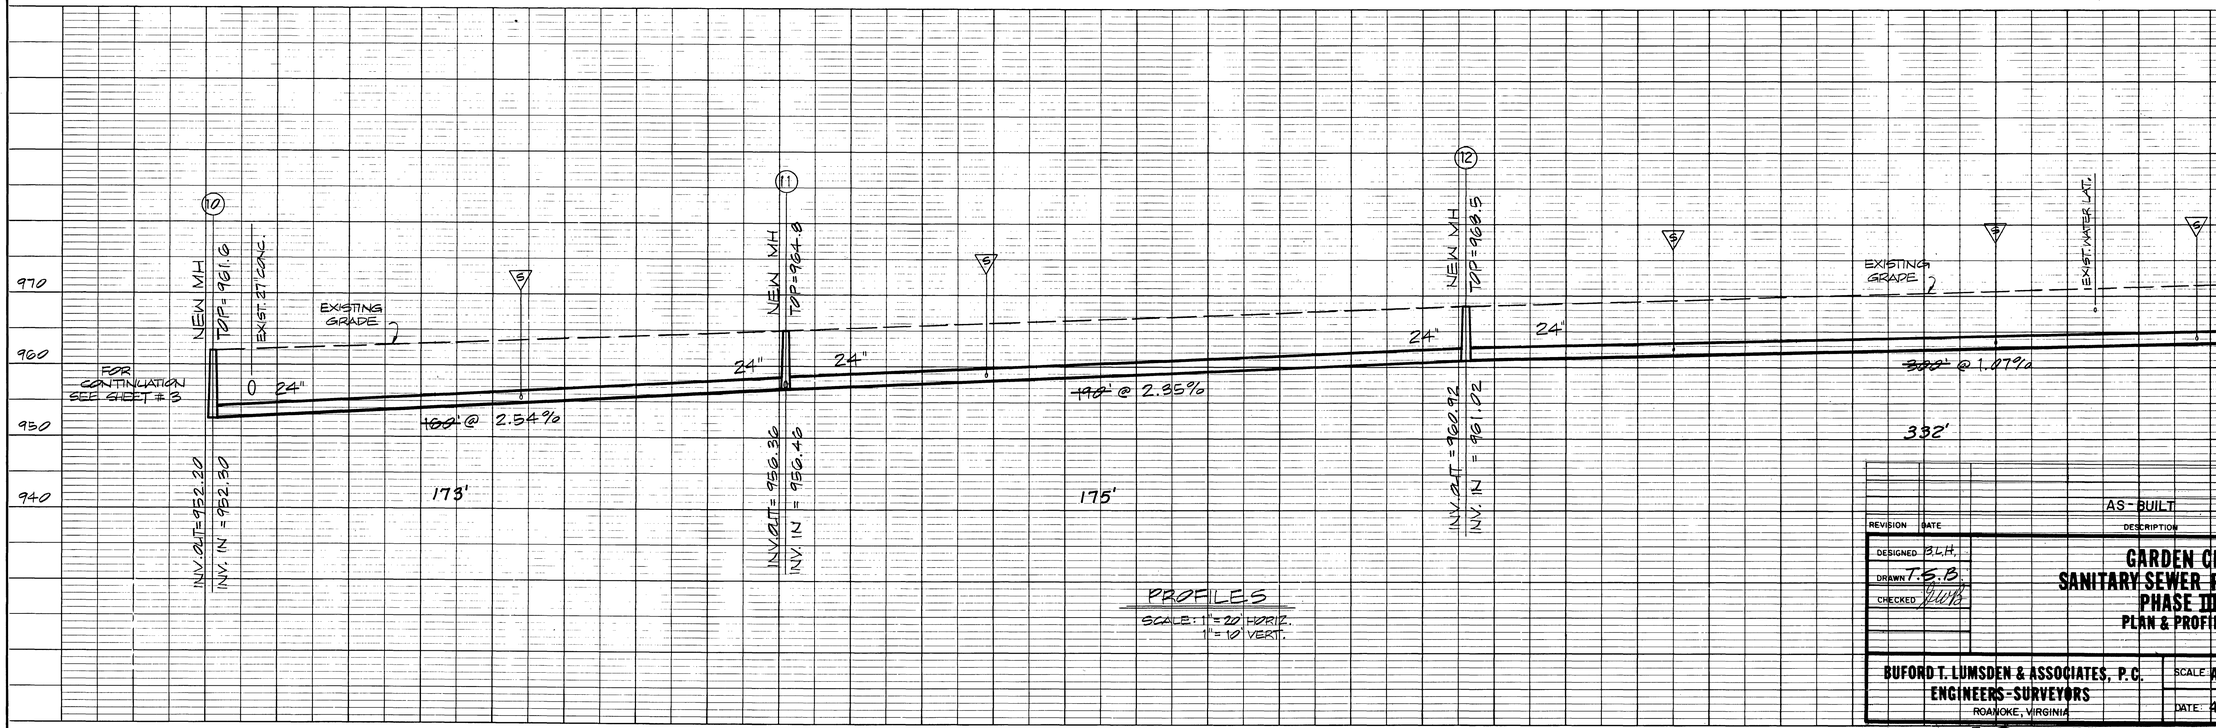

PROFILES
SCALE: 1" = 20' HORIZ.
1" = 10' VERT.

AS-BUILT

REVISION	DATE	DESCRIPTION

DESIGNED B.L.H.
DRAWN T.S.B.
CHECKED

GARDEN CITY SANITARY SEWER REPLACEMENT PHASE III
PLAN & PROFILE

BUFORD T. LUMSDEN & ASSOCIATES, P.C.
ENGINEERS-SURVEYORS
ROANOKE, VIRGINIA

SCALE AS SHOWN | COMM 83-32
DATE 4 APR. '85 | SHEET 4 of 7

AS BUILT

PLAN NO. 5488

K·E PLATE 1, PLAN-PROFILE
KEUFFEL & ESSER CO.