VICINITY MAP

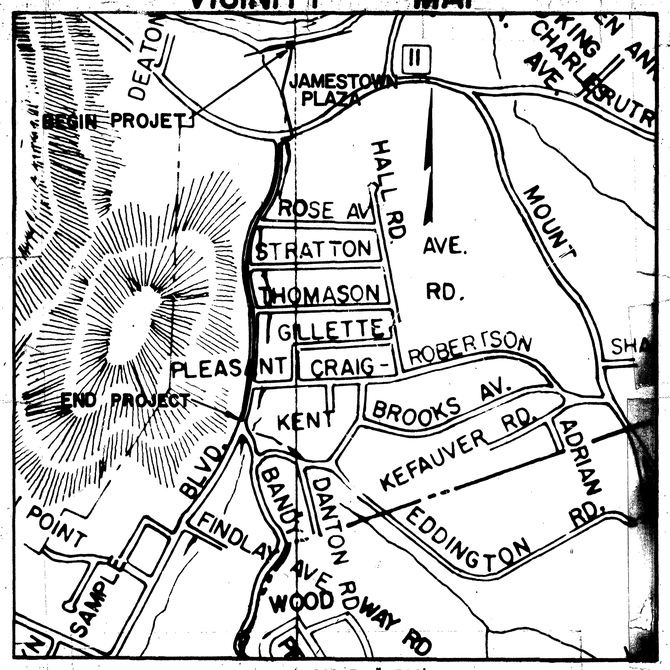

SCALE: 1" = 528'

0 528 1,056 1,584 2,112

INDEX OF SHEETS

SHEET NO.	DESCRIPTON
1	COVER SHEET
2	QUANITIES, LEGEND
3	PLAN - PROFILE
4	PLAN - PROFILE

ROANOKE, VIRGINIA

OFFICE OF CITY ENGINEER

CONSTRUCTION PLAN

GARDEN CITY BOULEVARD SANITARY SEWER REPLACEMENT FROM EXISTING ROANOKE RIVER INTERCEPTOR TO BANDY ROAD S.E.

AS BUILT

F.B. 603

SHEET NO.	DATE	SHEET NO.	DATE
PLANS REVISED			

APPROVED FOR CONSTRUCTION	
4-1-77 DATE	Thomas F. Beard CITY ENGINEER
DATE	
DATE	
DATE	
April 1st 1977 DATE	DESIGNED BY
April 1, 1977 DATE	Eugene V. Worley DESIGNED BY

APPROVED:

DATE:

APPROVED:

DATE:

SHEET 1 OF 4

PLAN NO. 5488