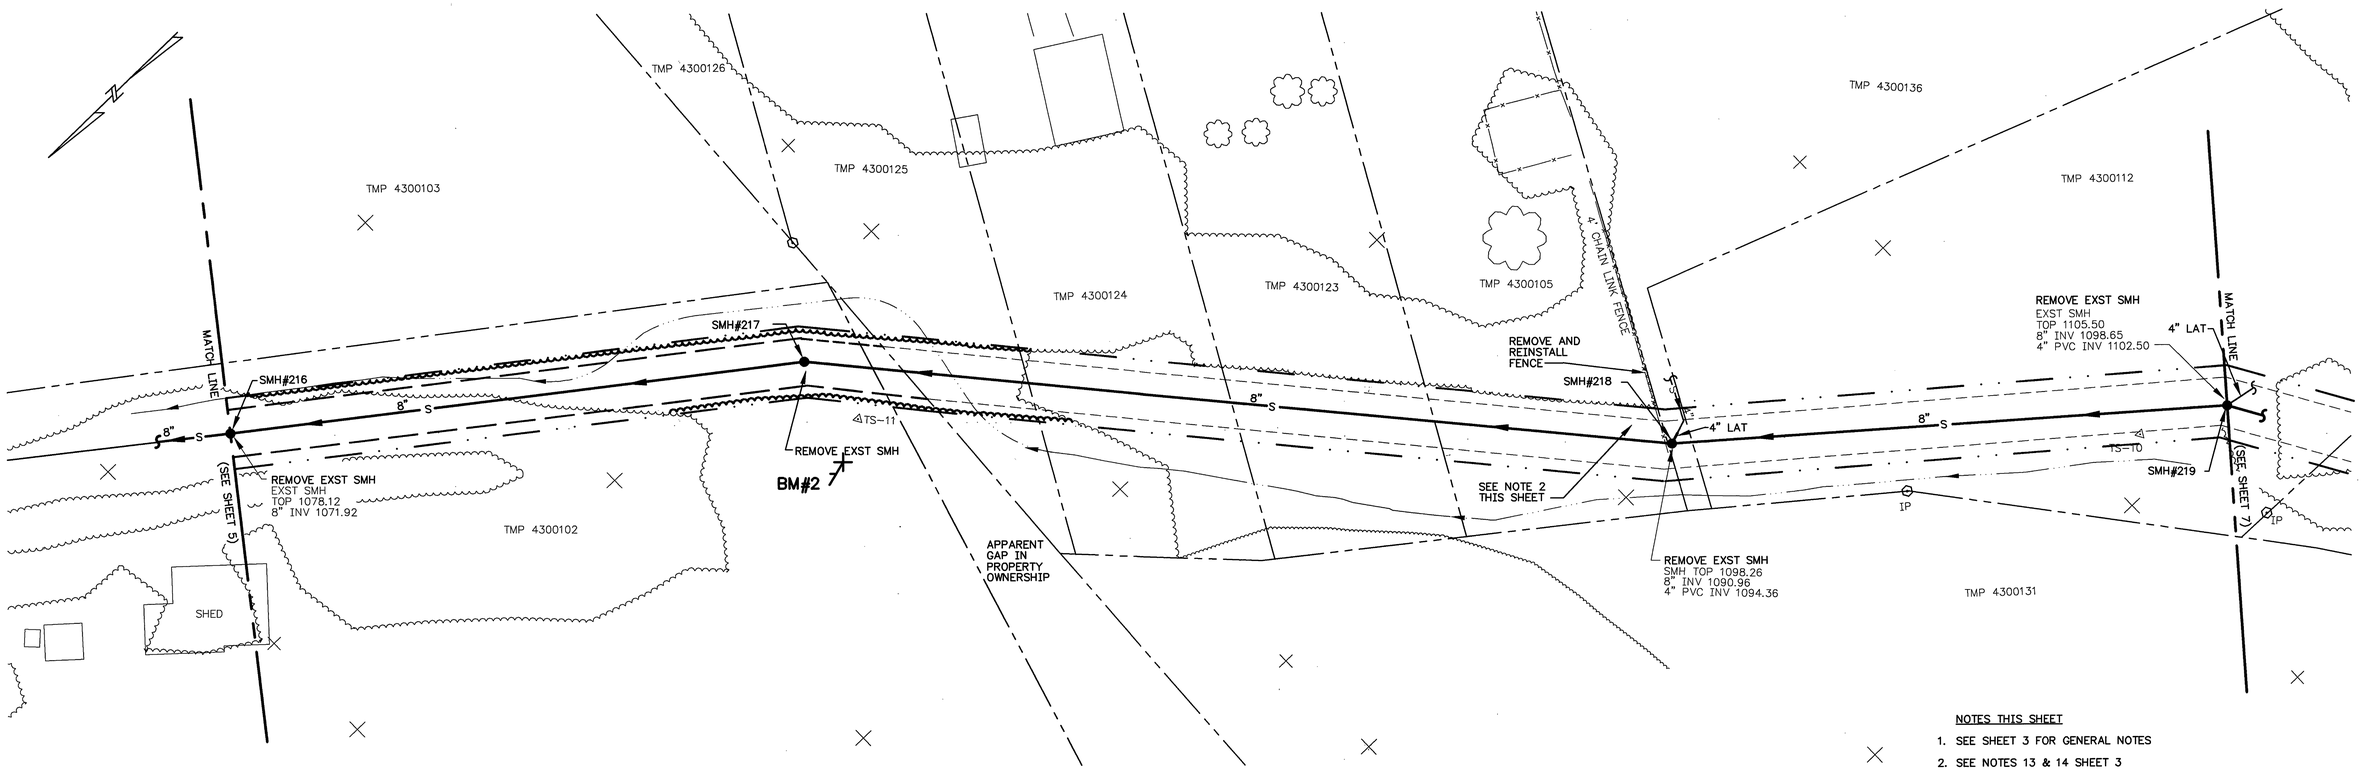

NOTES THIS SHEET

1. SEE SHEET 3 FOR GENERAL NOTES
2. SEE NOTES 13 & 14 SHEET 3

BM#2

R/R SPIKE IN NORTH SIDE OF 18" LOCUST TREE IN OLD FENCE ROW. 15' N.W. OF T.S. 11
ELEVATION 1089.60

PLAN

SCALE: 1"= 30'

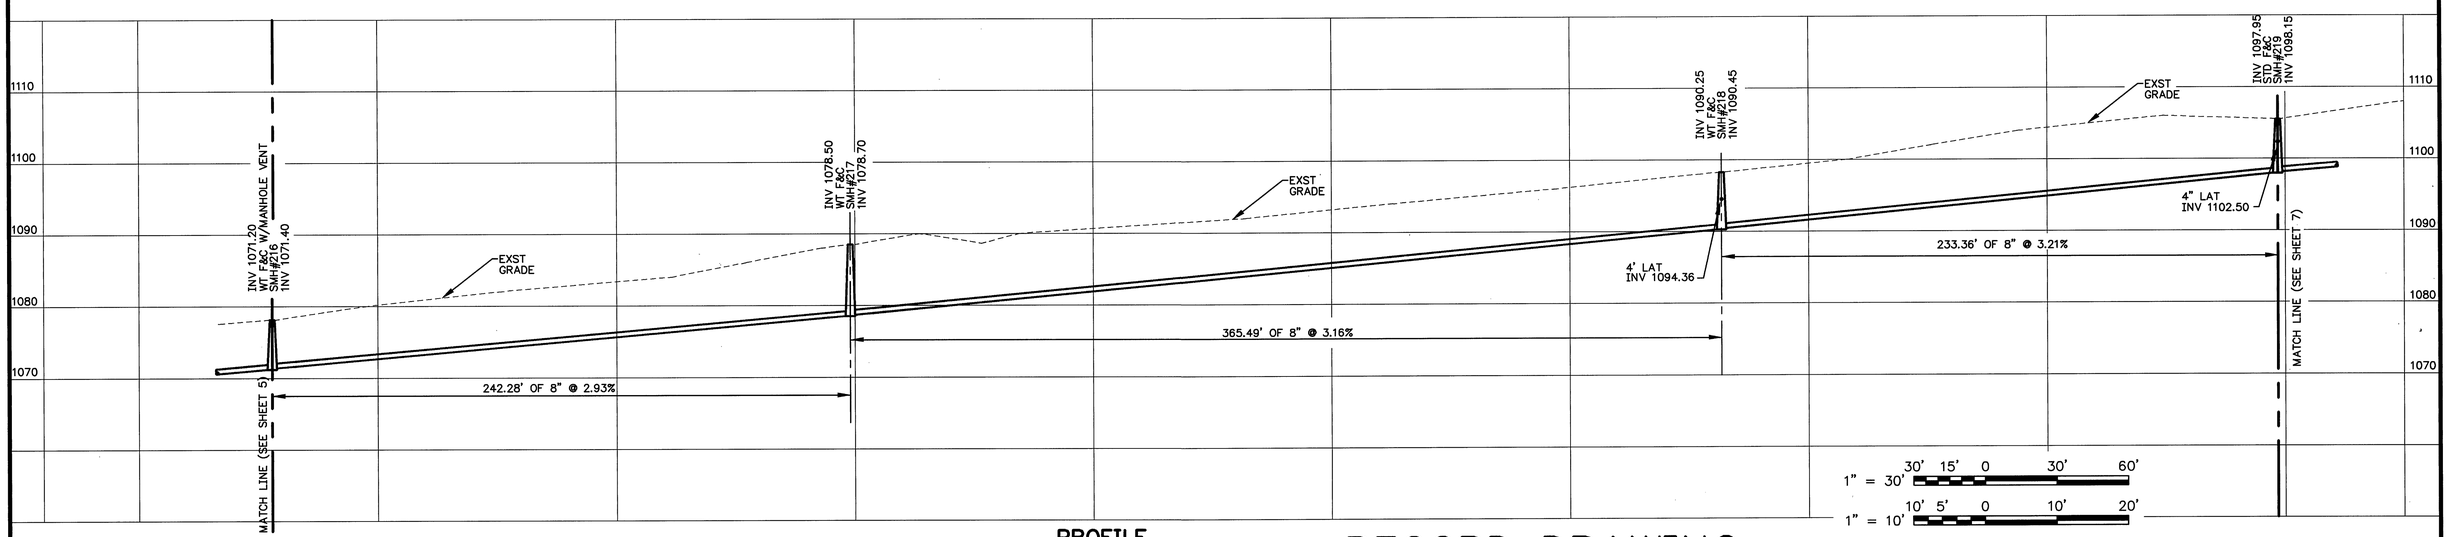

PROFILE

SCALE: 1"= 30' HORIZ.
1"= 10' VERT.

RECORD DRAWING

GRAPHIC SCALES

HAYES, SEAY, MATTERN AND MATTERN
ARCHITECTS/ENGINEERS/PLANNERS

DESIGNED:	DMC
DRAWN:	DMC
CHECKED:	DMH
APPROVED:	DMH

REVISIONS

DATE	BY	DESCRIPTION
7/3/97	DMC	RECORD DRAWINGS PREPARED FROM DRAWINGS AND INFORMATION PROVIDED BY PRILLAMAN AND PACE, INC.

SEWER REPLACEMENT PROJECT GC-1
GARDEN CITY SEWERSHED
ROANOKE, VIRGINIA

PLAN AND PROFILE

COMM. NO.: 7122B | SCALE: AS NOTED | DATE: JUNE 19 1996

SHEET NO. 6

7122BC5 C7122B JY0897 REV. I ACAD DMC PLOT SCALE: 1=30 133'52'54"

PROJECT NO.: 6272