NOTE: GAS LINE LOCATION IS APPROXIMATE. CONTRACTOR SHALL COORDINATE WITH ROANOKE GAS COMPANY PRIOR TO EXCAVATING IN THIS REACH OF SEWER.

MH-52
STA 12+60, 75' LT ℄ D'
STD. COVER

MH-53
PI STA 14+46.43 ℄ D
STD COVER

MH-56
STA 20+80.04
4' R
WT COVER

MH-55
STA 17+70.17 ℄ D
STD COVER

MH-54
PI STA 14+55.7 ℄ D
STD COVER

MH-57
STA 22+31.00 ℄ D'
21' R
WT COVER

MH-58
STA 23+60.00 ℄ D'
17' L
WT COVER

BM - SPIKE NAIL IN 18" WILLOW
52' RT STA 17+72
EL 988.32

BM.- SPIKE NAIL IN 30" WALNUT
21' LT STA 2+50
EL. 995.25

BM.- STANDARD TABLET IN WINGWALL OF BRIDGE OVER COOK CREEK ON RTE 603
USGS 114 W SM.- EL 990.10
123' LT STA. 12+80

PI STA 16+55.17 ℄ D'

PI STA 18+66.42 ℄ D'

PI STA 20+40.04 ℄ D'

PI STA 10+74.04 ℄ D'

PI STA 13+81.43 ℄ D'

MATCH LINE FOR CONT. SEE SH. 12 STA 234+00 ℄ C'

MATCH LINE FOR CONT. SEE SH 14 STA 23+50 ℄ D'

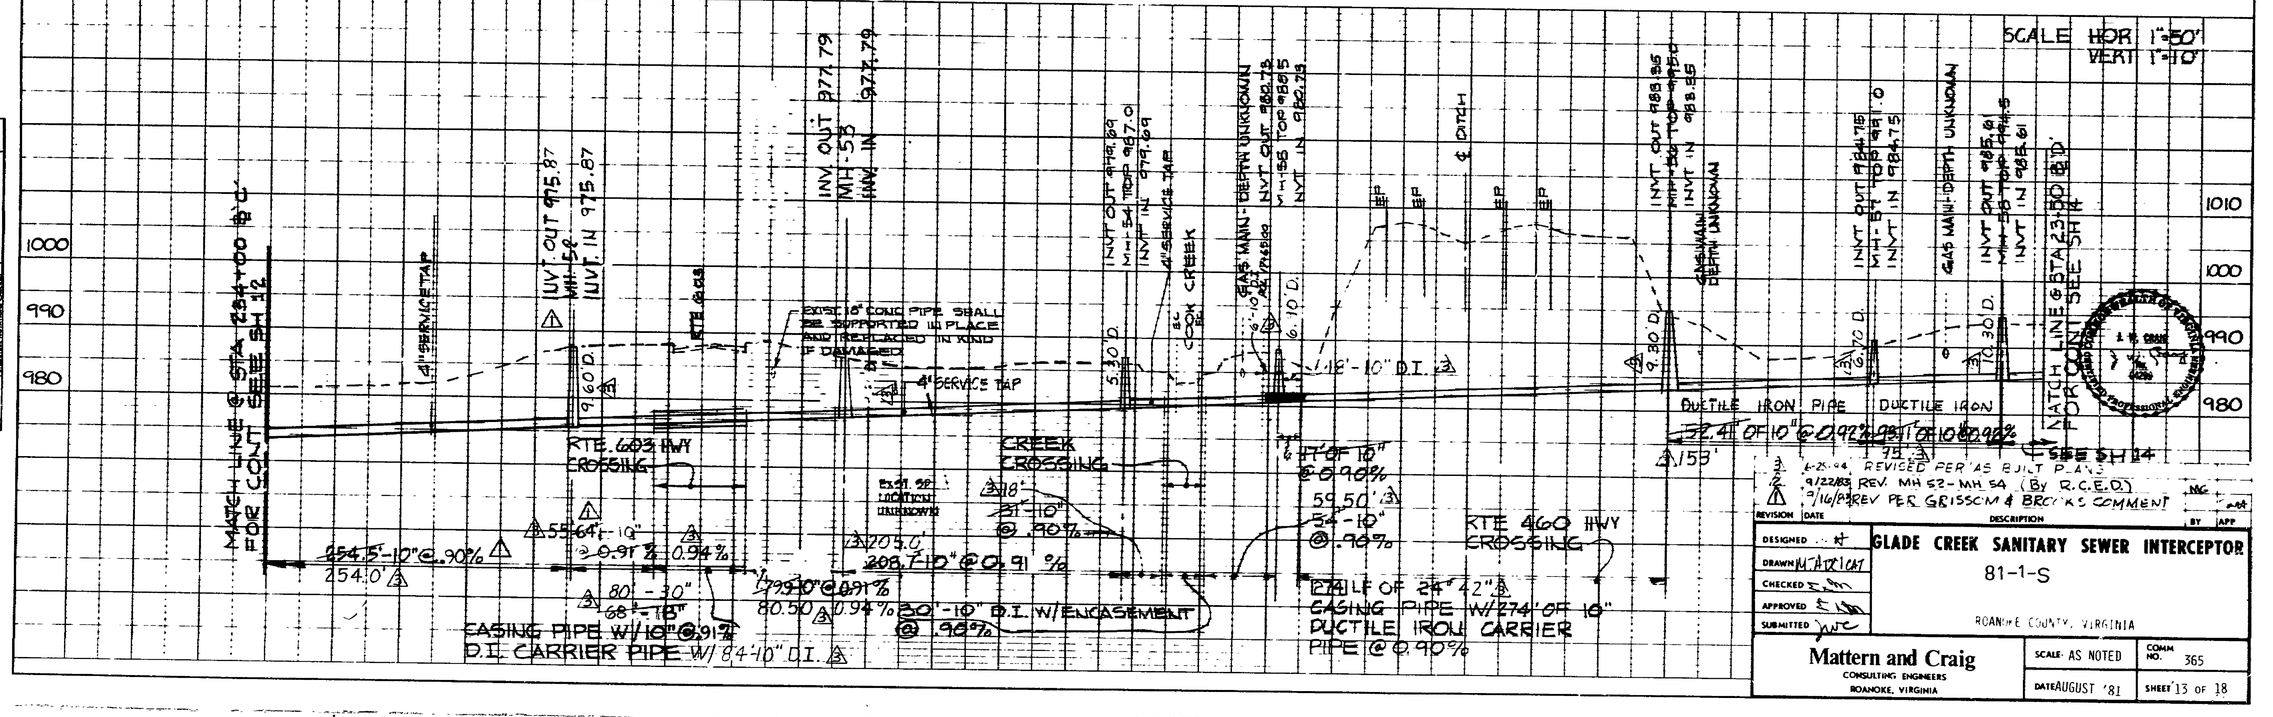

REVISION	DATE	DESCRIPTION	BY	APP
3	6-25-84	REVISED PER AS BUILT PLANS		
2	9/22/83	REV. MH 52 - MH 54 (BY R.C.E.D.)		
1	9/16/83	REV PER GRISSOM & BROOKS COMMENT		

DESIGNED
DRAWN M. ATKICAT
CHECKED
APPROVED
SUBMITTED

GLADE CREEK SANITARY SEWER INTERCEPTOR

81-1-S

ROANOKE COUNTY, VIRGINIA

Mattern and Craig
CONSULTING ENGINEERS
ROANOKE, VIRGINIA

SCALE: AS NOTED
COMM. NO. 365
DATE AUGUST '81
SHEET 13 OF 18