CENTERLINE CURVE DATA						
CURVE	ANGLE	RADIUS	ARC	TAN	CHORD	CH. BEARING
"B"	25°31'06"	212.00'	94.42'	48.01'	93.64'	N 12°57'07" W

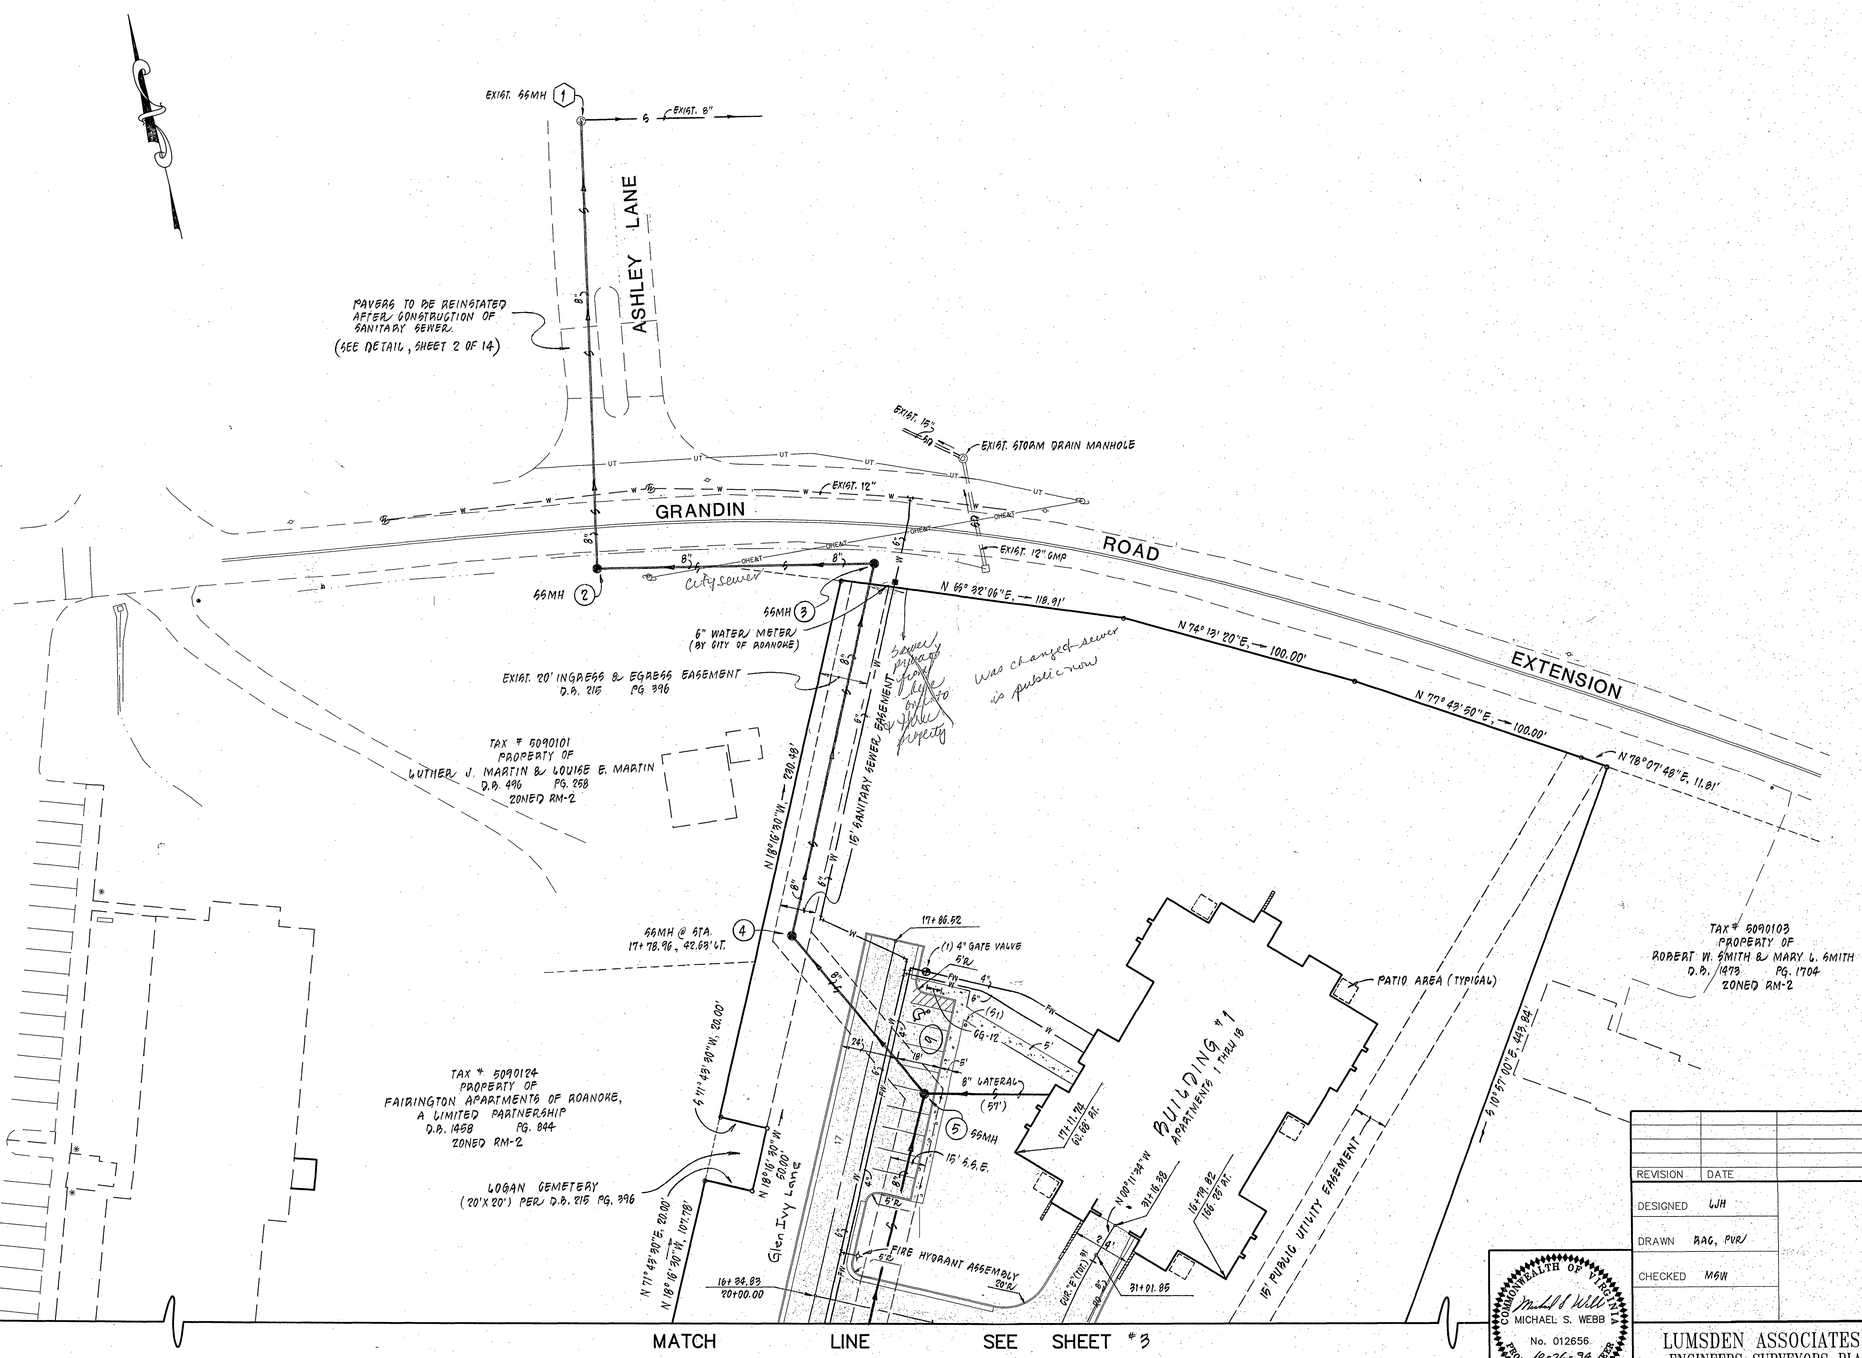

"AS-BUILT"

REVISION	DATE	DESCRIPTION

DESIGNED WJH
DRAWN BAG, PVR/
CHECKED MGW

DIMENSIONAL LAYOUT & UTILITY PLAN
FOR
"GLEN IVY"
PREPARED FOR
RADFORD & COMPANY
ROANOKE, VIRGINIA

COMMONWEALTH OF VIRGINIA
MICHAEL S. WEBB
No. 012656
10-26-94
PROFESSIONAL ENGINEER

LUMSDEN ASSOCIATES, P.C.
ENGINEERS-SURVEYORS-PLANNERS
ROANOKE, VIRGINIA

SCALE: 1" = 30'
COMM: #94-53
DATE: 1 MAR. 1995
SHEET 4 of 15