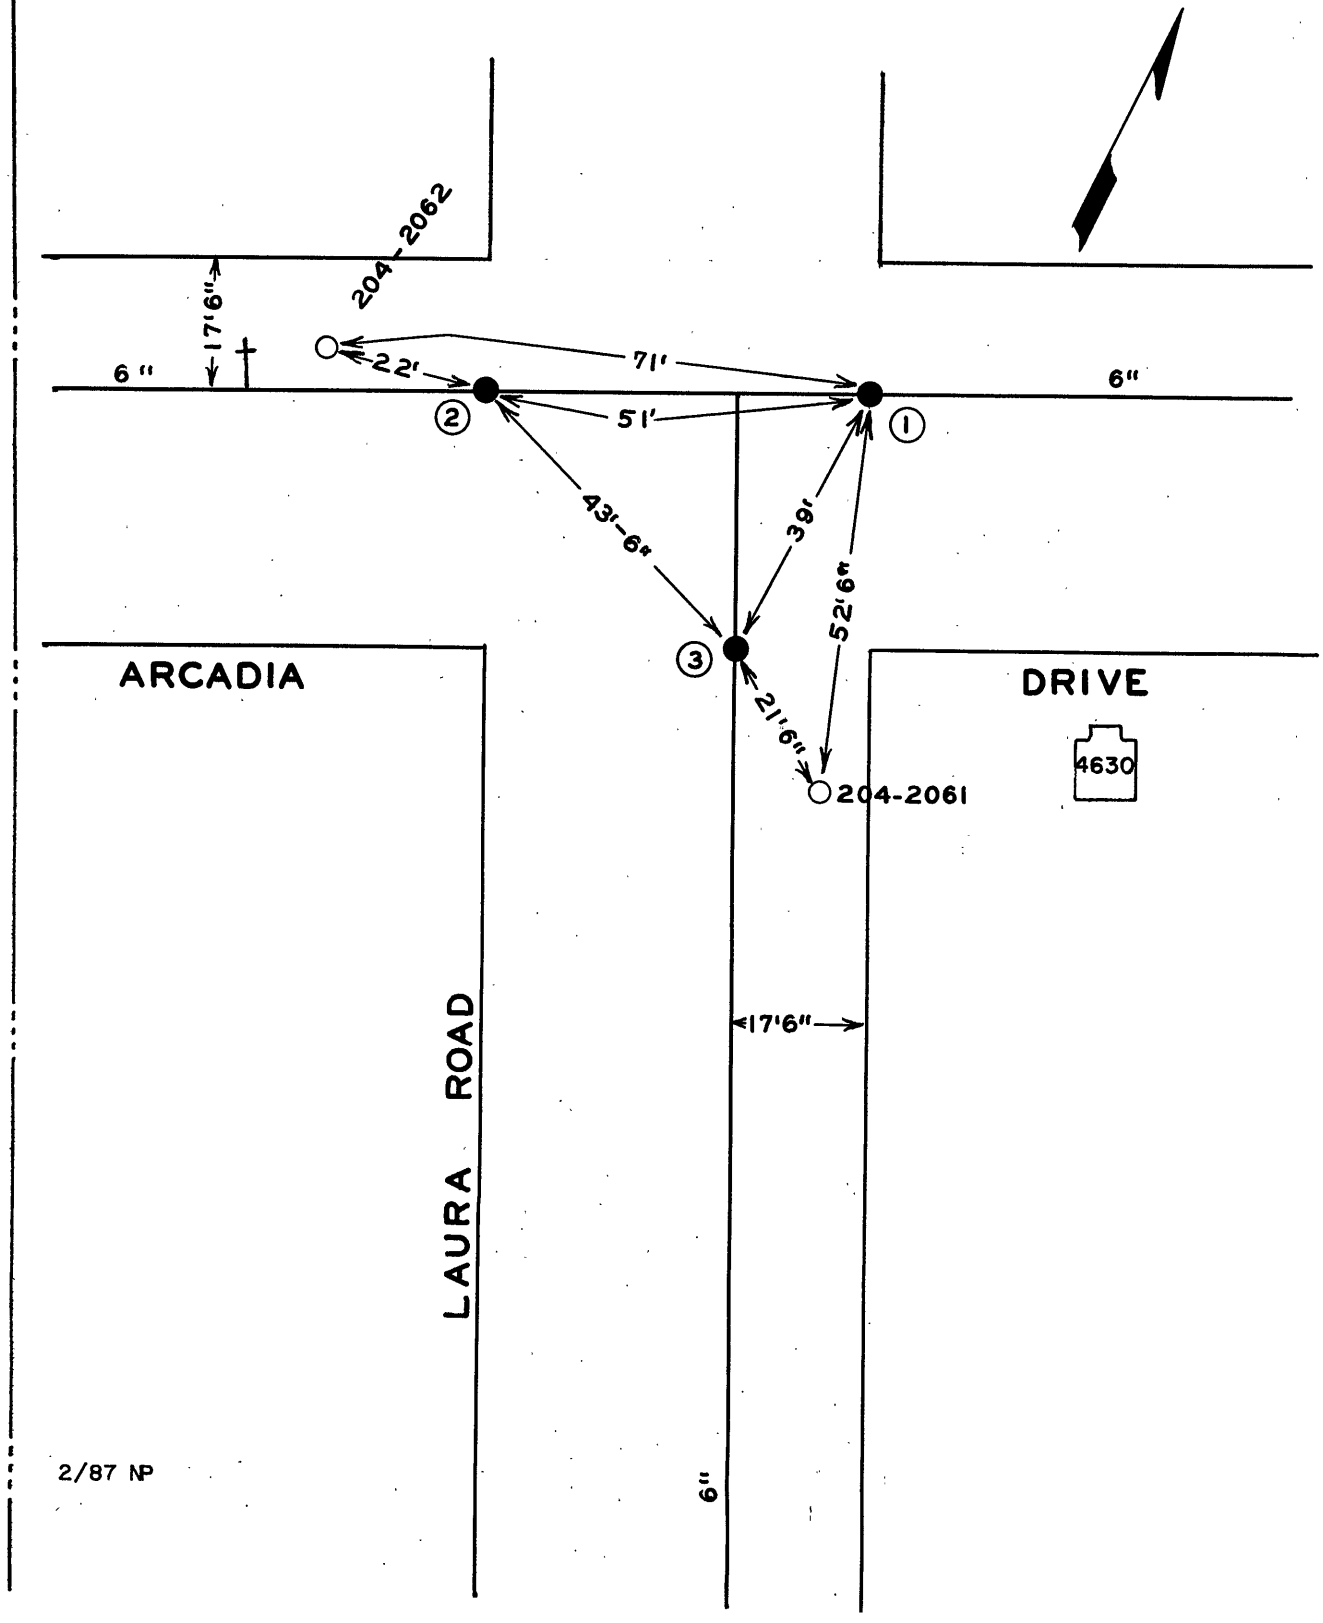

DATE	NO.	SIZE	MAKE	OPEN	TURNS
10-64	1	6"	MUELLER	R	21
10-64	2	6"	MUELLER	R	21
10-64	3	6"	MUELLER	R	21
	1	0	E.P.L.		
	2	0	W.P.L.		
	3	0	S.P.L.		

CITY OF ROANOKE—WATER DEPT.

VALVE DIAGRAM

ARCADIA DRIVE & LAURA ROAD

SEC. MAP 615 N.W.

DATE PAGE NO.