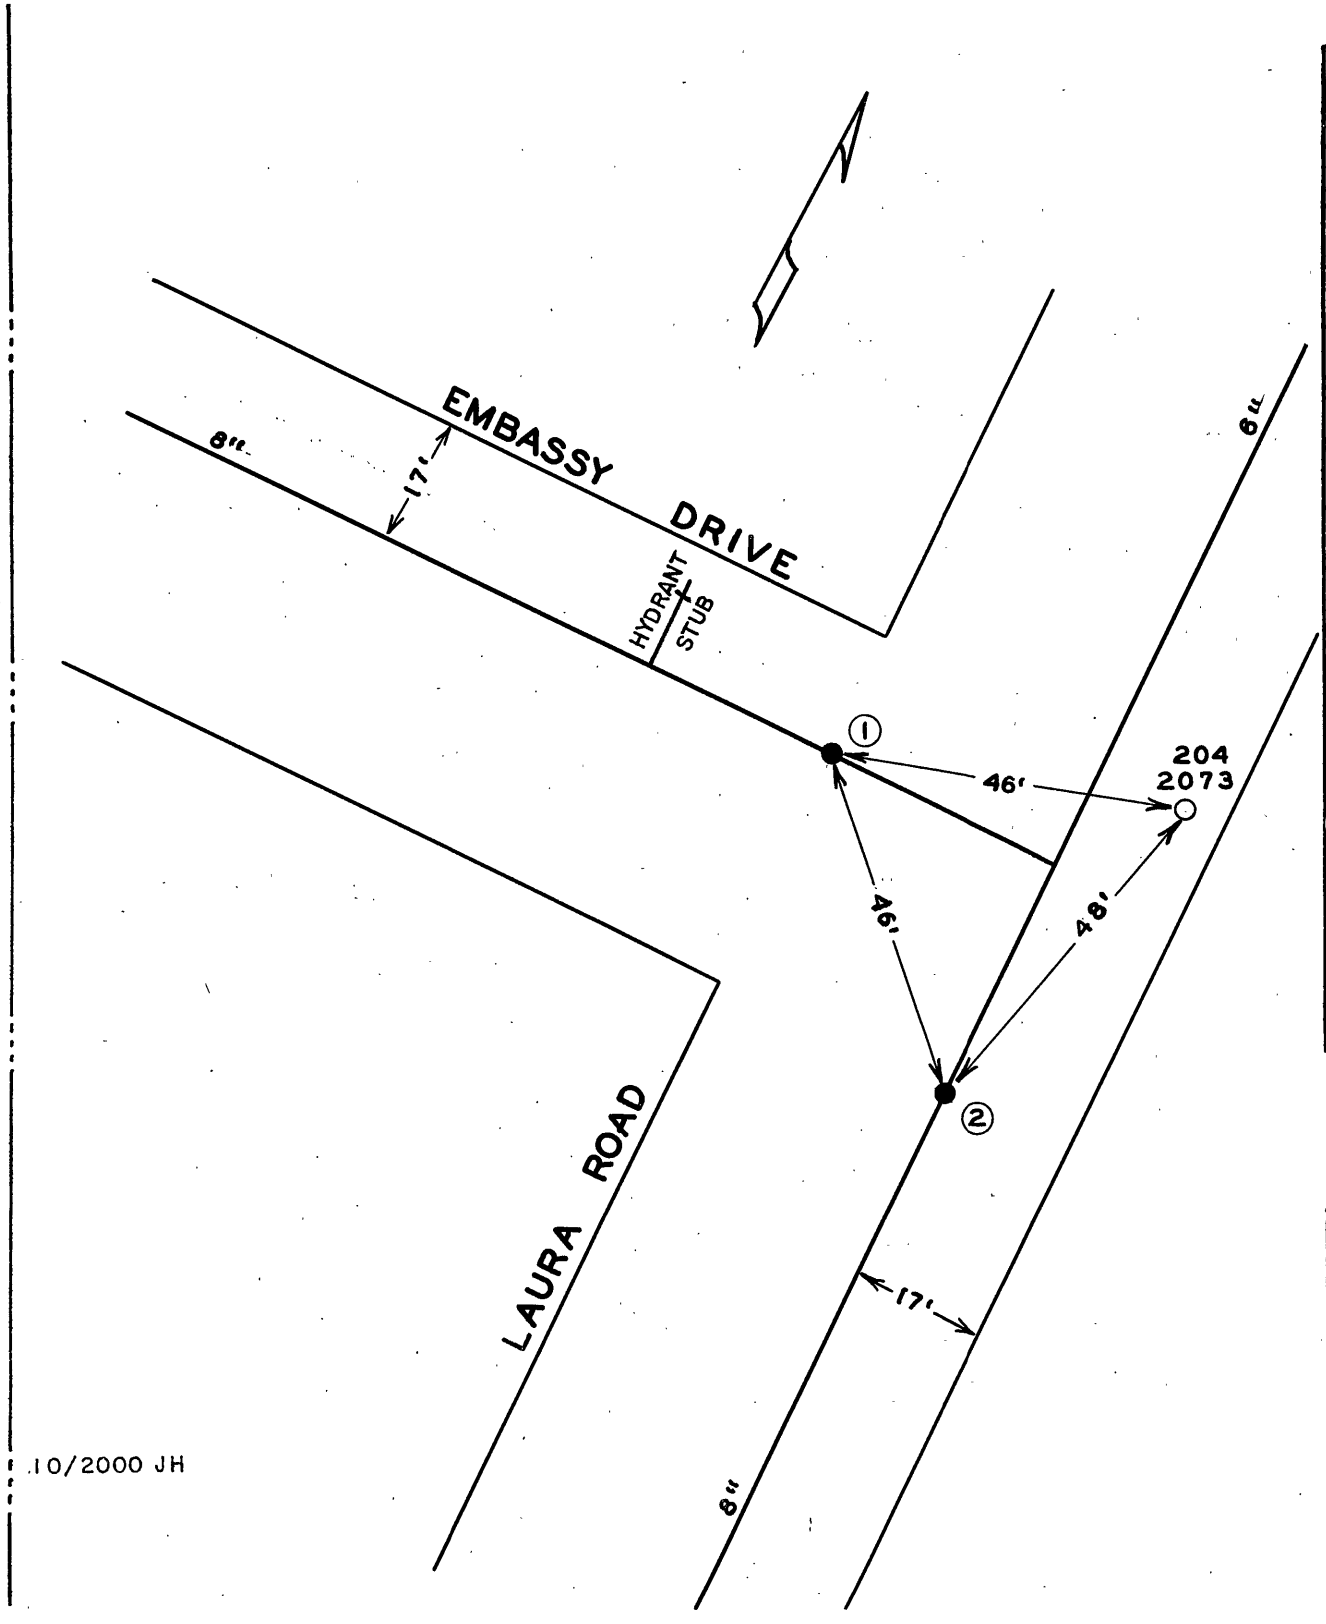

DATE	NO.	SIZE	MAKE	OPEN	TURNS
10-64	1	8"	MUELLER	R	27
10-64	2	8"	MUELLER	R	27
	1	0	W.P.L.		
	2	0	S.P.L.		

CITY OF ROANOKE—WATER DEPT.

VALVE DIAGRAM

EMBASSY DRIVE &

LAURA ROAD

SEC. MAP 615 N.W.

DATE PAGE NO.

10/2000 JH