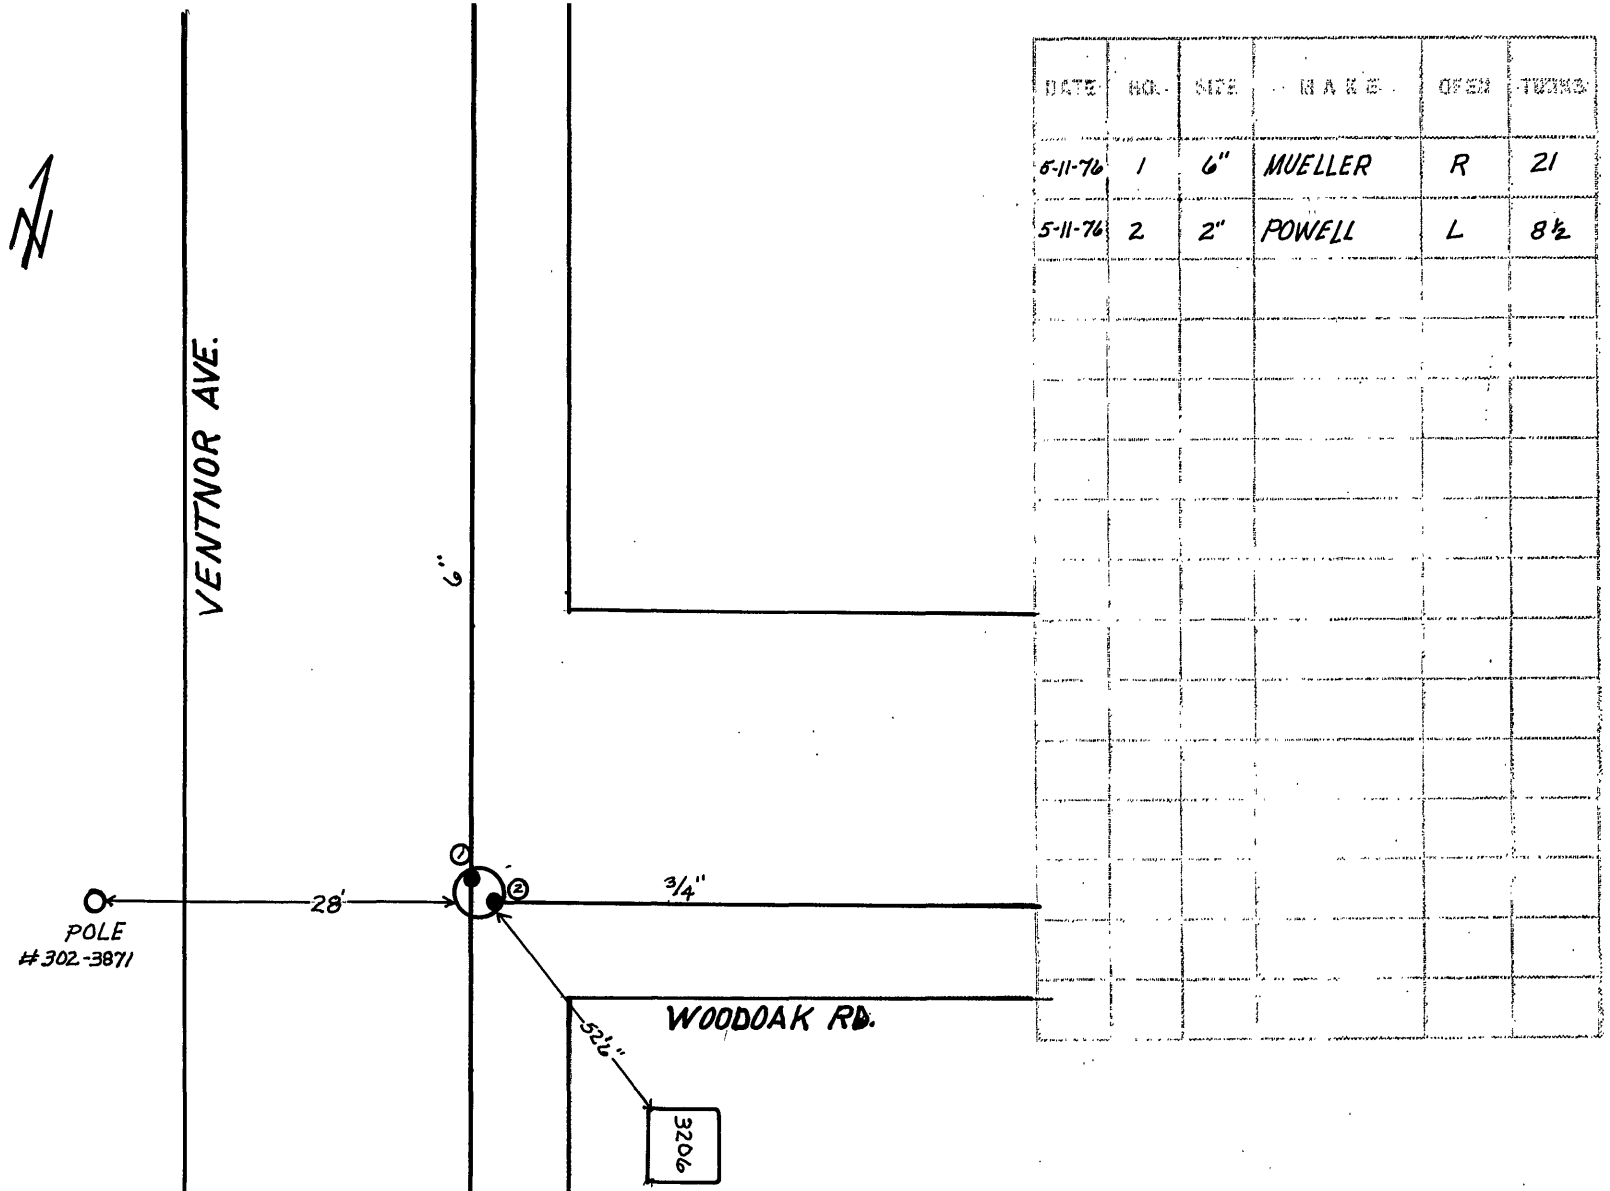

DATE	NO.	SIZE	NAME	OPEN	TURNS
6-11-76	1	6"	MUELLER	R	21
5-11-76	2	2"	POWELL	L	8½

CITY OF ROANOKE - WATER DEPT

VALVE LOCATION

VENTNOR AVE. AND

WOODOAK RD.

S.E.

SEC. MAP 438

DATE PAGE NO.