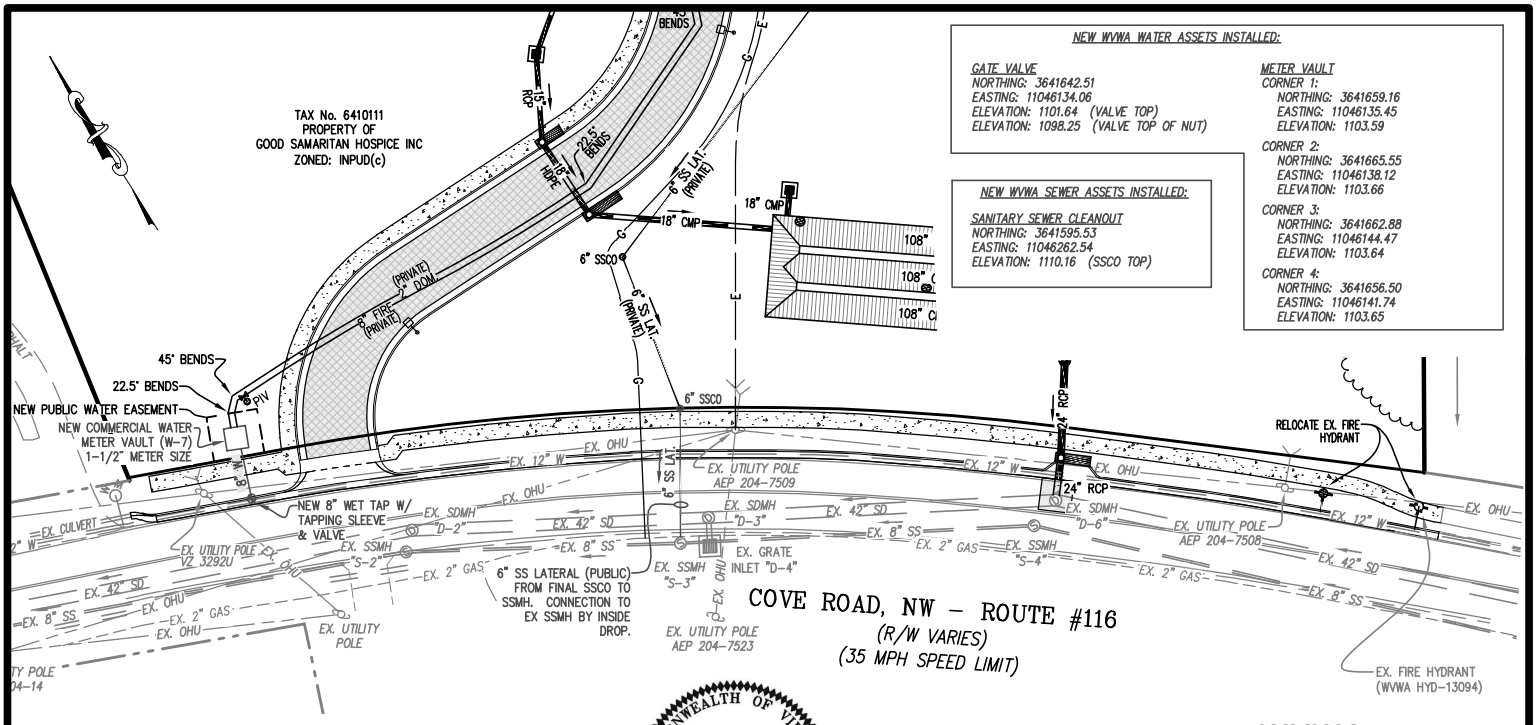

NEW WVWA WATER ASSETS INSTALLED:

GATE VALVE
NORTHING: 3641642.51
EASTING: 11046134.06
ELEVATION: 1101.64 (VALVE TOP)
ELEVATION: 1098.25 (VALVE TOP OF NUT)

METER VAULT
CORNER 1:
NORTHING: 3641659.16
EASTING: 11046135.45
ELEVATION: 1103.59
CORNER 2:
NORTHING: 3641665.55
EASTING: 11046138.12
ELEVATION: 1103.66
CORNER 3:
NORTHING: 3641662.88
EASTING: 11046144.47
ELEVATION: 1103.64
CORNER 4:
NORTHING: 3641656.50
EASTING: 11046141.74
ELEVATION: 1103.65

NEW WVWA SEWER ASSETS INSTALLED:

SANITARY SEWER CLEANOUT
NORTHING: 3641595.53
EASTING: 11046262.54
ELEVATION: 1110.16 (SSCO TOP)

AS-BUILT

AS-BUILT INFORMATION SHOWN ON THIS PLAN IS THE RESULT OF A FIELD SURVEY PERFORMED BY LUMSDEN ASSOCIATES, P.C. OR AS SUPPLIED BY WELLS CONSTRUCTION COMPANY INC. (CONTRACTOR) FIELD MARKUPS.

COMMONWEALTH OF VIRGINIA
ANDREW P. LUMSDEN
Lic. No. 052216
9/29/23
PROFESSIONAL ENGINEER

30' 0 30'
SCALE: 1" = 30'

WVWA
AS-BUILT PLAN
"GOOD SAMARITAN HOSPICE BUILDING"
4751 COVE ROAD, N.W.
ROANOKE COUNTY, VIRGINIA

Lumsden Associates, P.C.
ENGINEERS | SURVEYORS | PLANNERS
4664 BRAMBLETON AVENUE
P.O. BOX 20669
ROANOKE, VIRGINIA 24018
PHONE: (540) 774-4411
FAX: (540) 772-9445
WWW.LUMSDENPC.COM

DATE:	September 29, 2023
COMM. NO.:	22-119
SCALE:	1" = 30'

SHEET 1 OF 2

22119 - wvwa as-built-01-ab01.plt
W:\drawings\2022\2022-119\01-cad\01-engineering\02-design\wvwa as-built\22119 - wvwa as-built.dwg