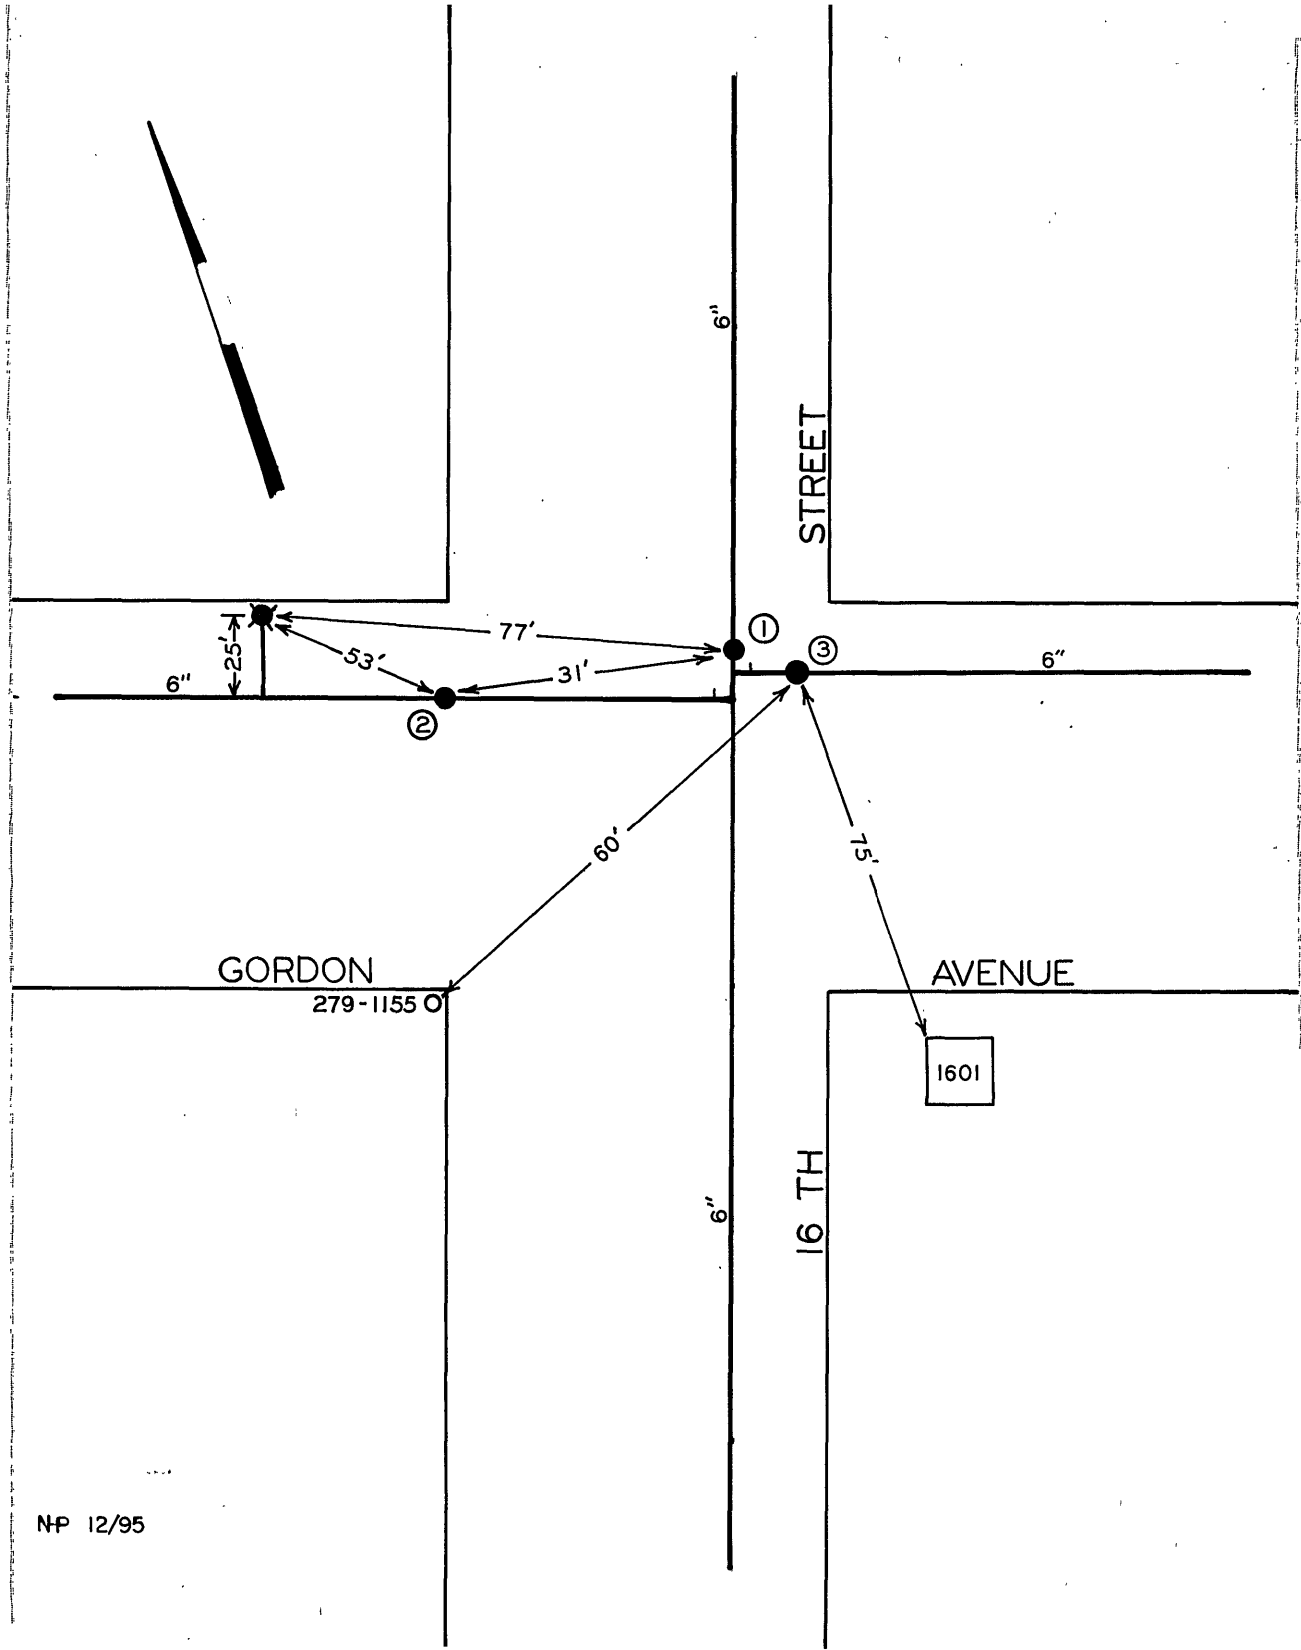

DATE	NO.	SIZE	MAKE	OPEN	TURNS
65	1	6"	DARLING	R	21
71	2	6"	DARLING	R	21
74	3	6"	MUELLER	R	
	1	10'S	N.P.L.		
	2	0'	W.P.L.		

NP 12/95

CITY OF ROANOKE—WATER DEPT.

VALVE DIAGRAM

GORDON AVE. & 16 TH. ST. S.E.

SEC. MAP 434,443

DATE PAGE NO.