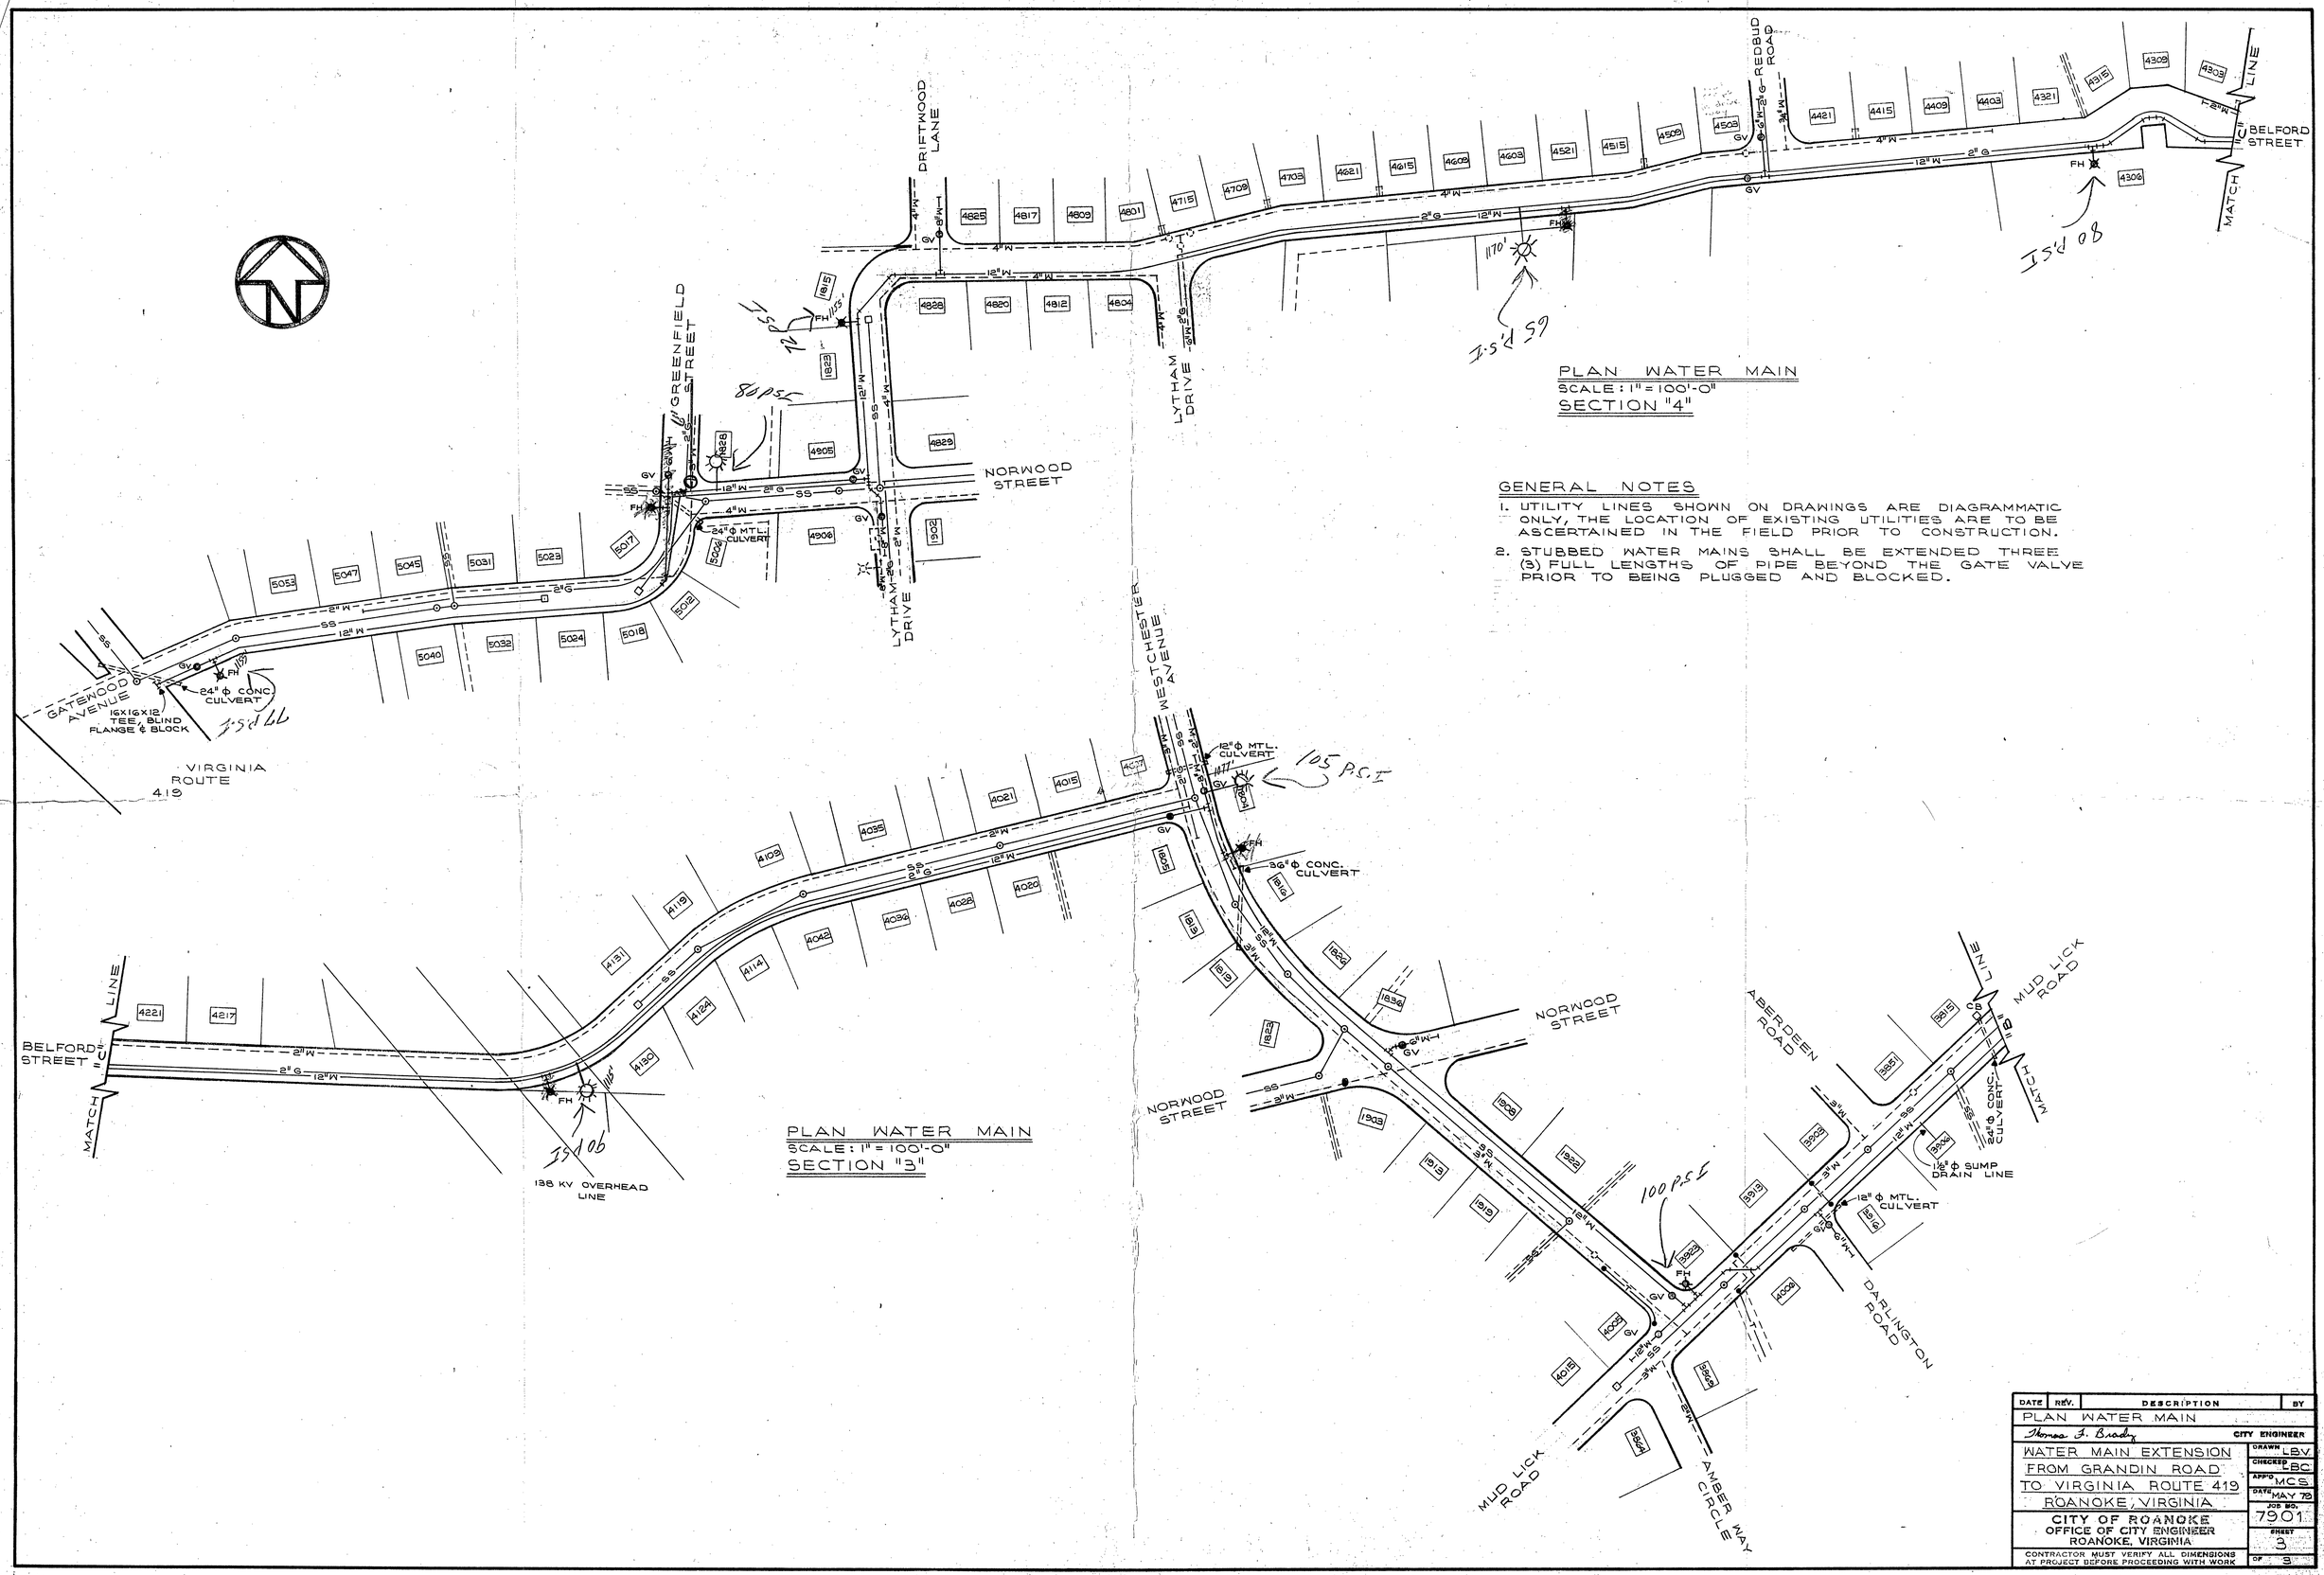
GATEWOOD AVENUE
16X16X12 TEE, BLIND FLANGE & BLOCK
24" ϕ CONC. CULVERT
VIRGINIA ROUTE 419
GREENFIELD STREET
24" ϕ MTL. CULVERT
DRIFTWOOD LANE
NORWOOD STREET
LYTHAM DRIVE
WESTCHESTER AVENUE
12" ϕ MTL. CULVERT
36" ϕ CONC. CULVERT
REDBUD ROAD
BELFORD STREET
MATCH LINE
138 KV OVERHEAD LINE
ABERDEEN ROAD
MUD LICK ROAD
24" ϕ CONC. CULVERT
1½" ϕ SUMP DRAIN LINE
12" ϕ MTL. CULVERT
DARLINGTON ROAD
AMBER WAY CIRCLE
PLAN WATER MAIN
SCALE: 1" = 100'-0"
SECTION "4"
PLAN WATER MAIN
SCALE: 1" = 100'-0"
SECTION "3"
GENERAL NOTES
1. UTILITY LINES SHOWN ON DRAWINGS ARE DIAGRAMMATIC ONLY, THE LOCATION OF EXISTING UTILITIES ARE TO BE ASCERTAINED IN THE FIELD PRIOR TO CONSTRUCTION.
2. STUBBED WATER MAINS SHALL BE EXTENDED THREE (3) FULL LENGTHS OF PIPE BEYOND THE GATE VALVE PRIOR TO BEING PLUGGED AND BLOCKED.
DATE | REV. | DESCRIPTION | BY
PLAN WATER MAIN
Thomas J. Brady CITY ENGINEER
WATER MAIN EXTENSION FROM GRANDIN ROAD TO VIRGINIA ROUTE 419 ROANOKE, VIRGINIA
CITY OF ROANOKE
OFFICE OF CITY ENGINEER
ROANOKE, VIRGINIA
CONTRACTOR MUST VERIFY ALL DIMENSIONS AT PROJECT BEFORE PROCEEDING WITH WORK
DRAWN LBV
CHECKED BC
APP'D MCS
DATE MAY 78
JOB NO. 7901
SHEET 3
OF 3