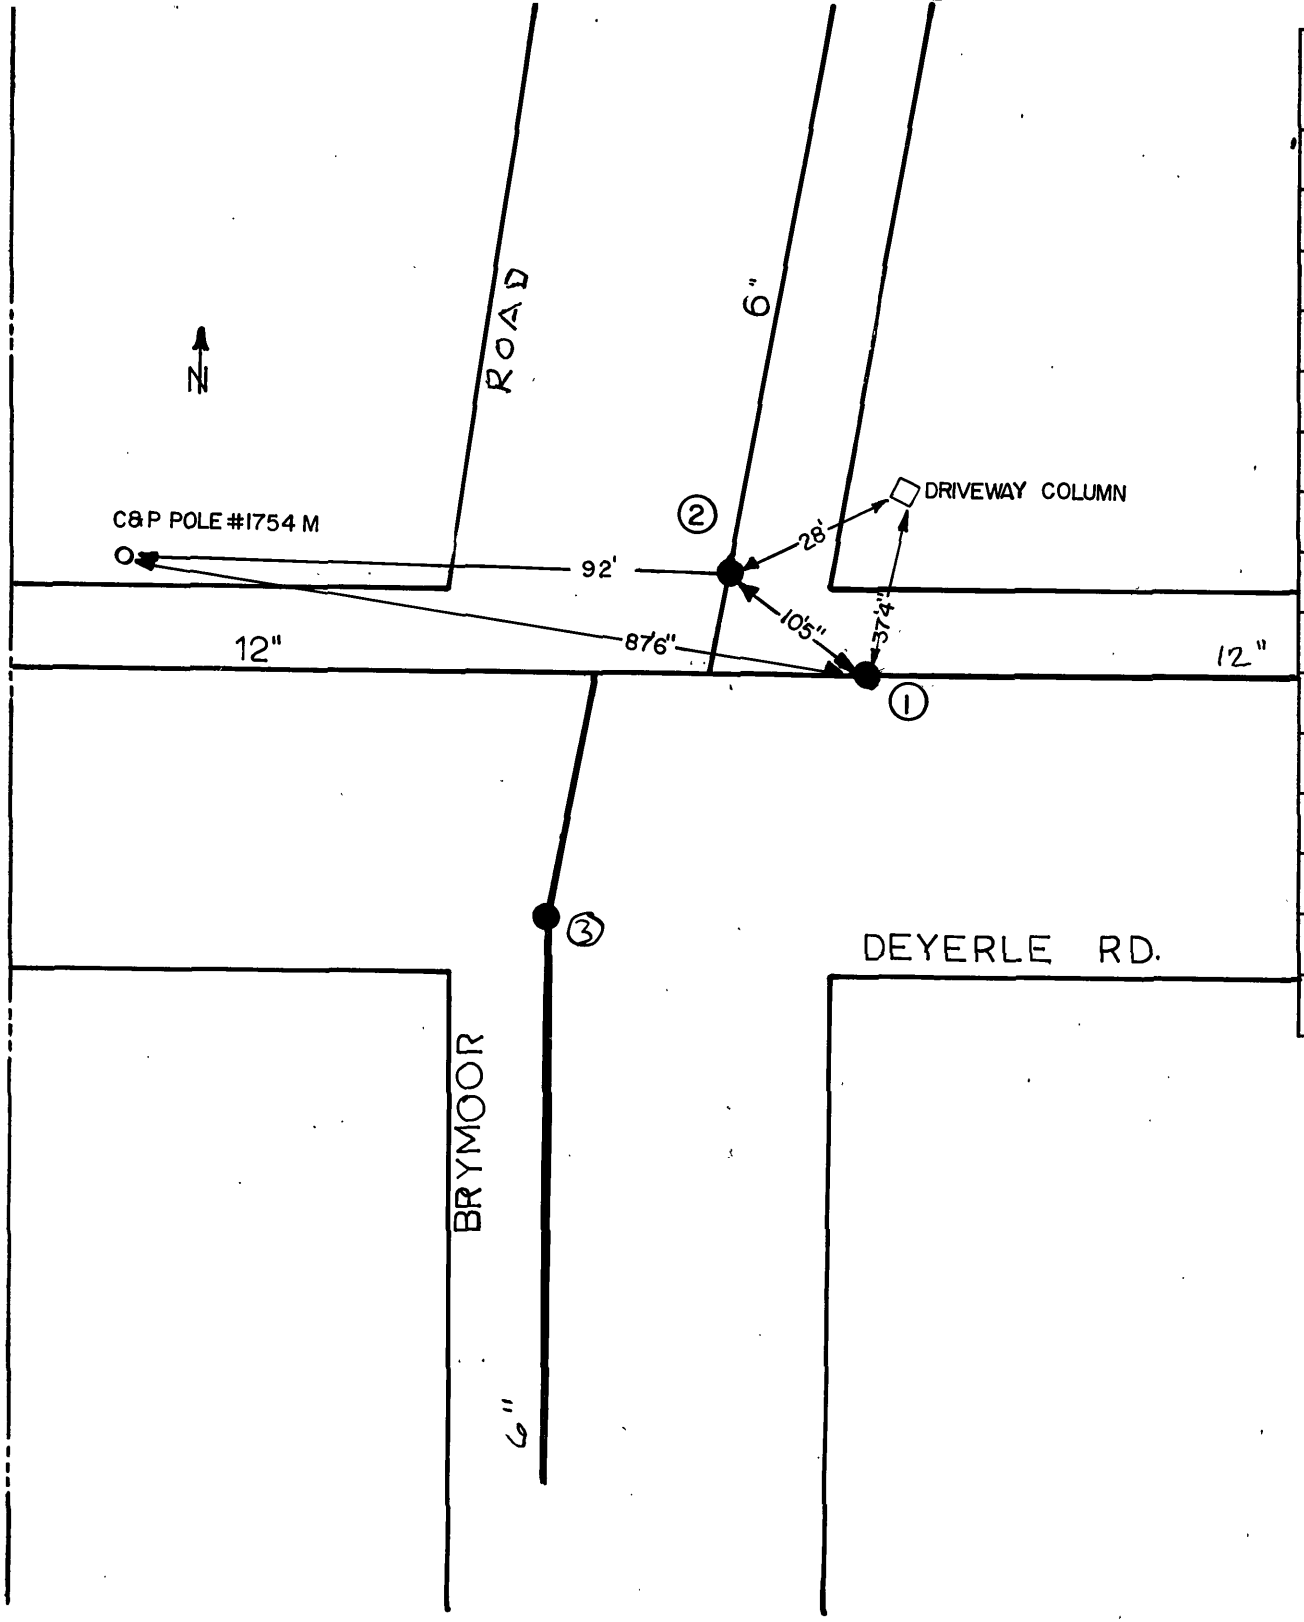


| DATE | NO. | SIZE | MAKE | OPEN | TURNS |
|---|---|---|---|---|---|
| 1979 | 1 | 12" | DARLING | R | 38 |
| 1981 | 2 | 6" | DARLING | R | 20 |
| 1979 | 3 | 6" | | | 20 |
| | | | | | |
| | | | | | |
**CITY OF ROANOKE—WATER DEP'T**

**VALVE DIAGRAM**

BRYMOOR RD. and

DEYERLE RD. SW.

SEC. MAP 507, 508 502

DATE 7/14/80 PAGE NO.