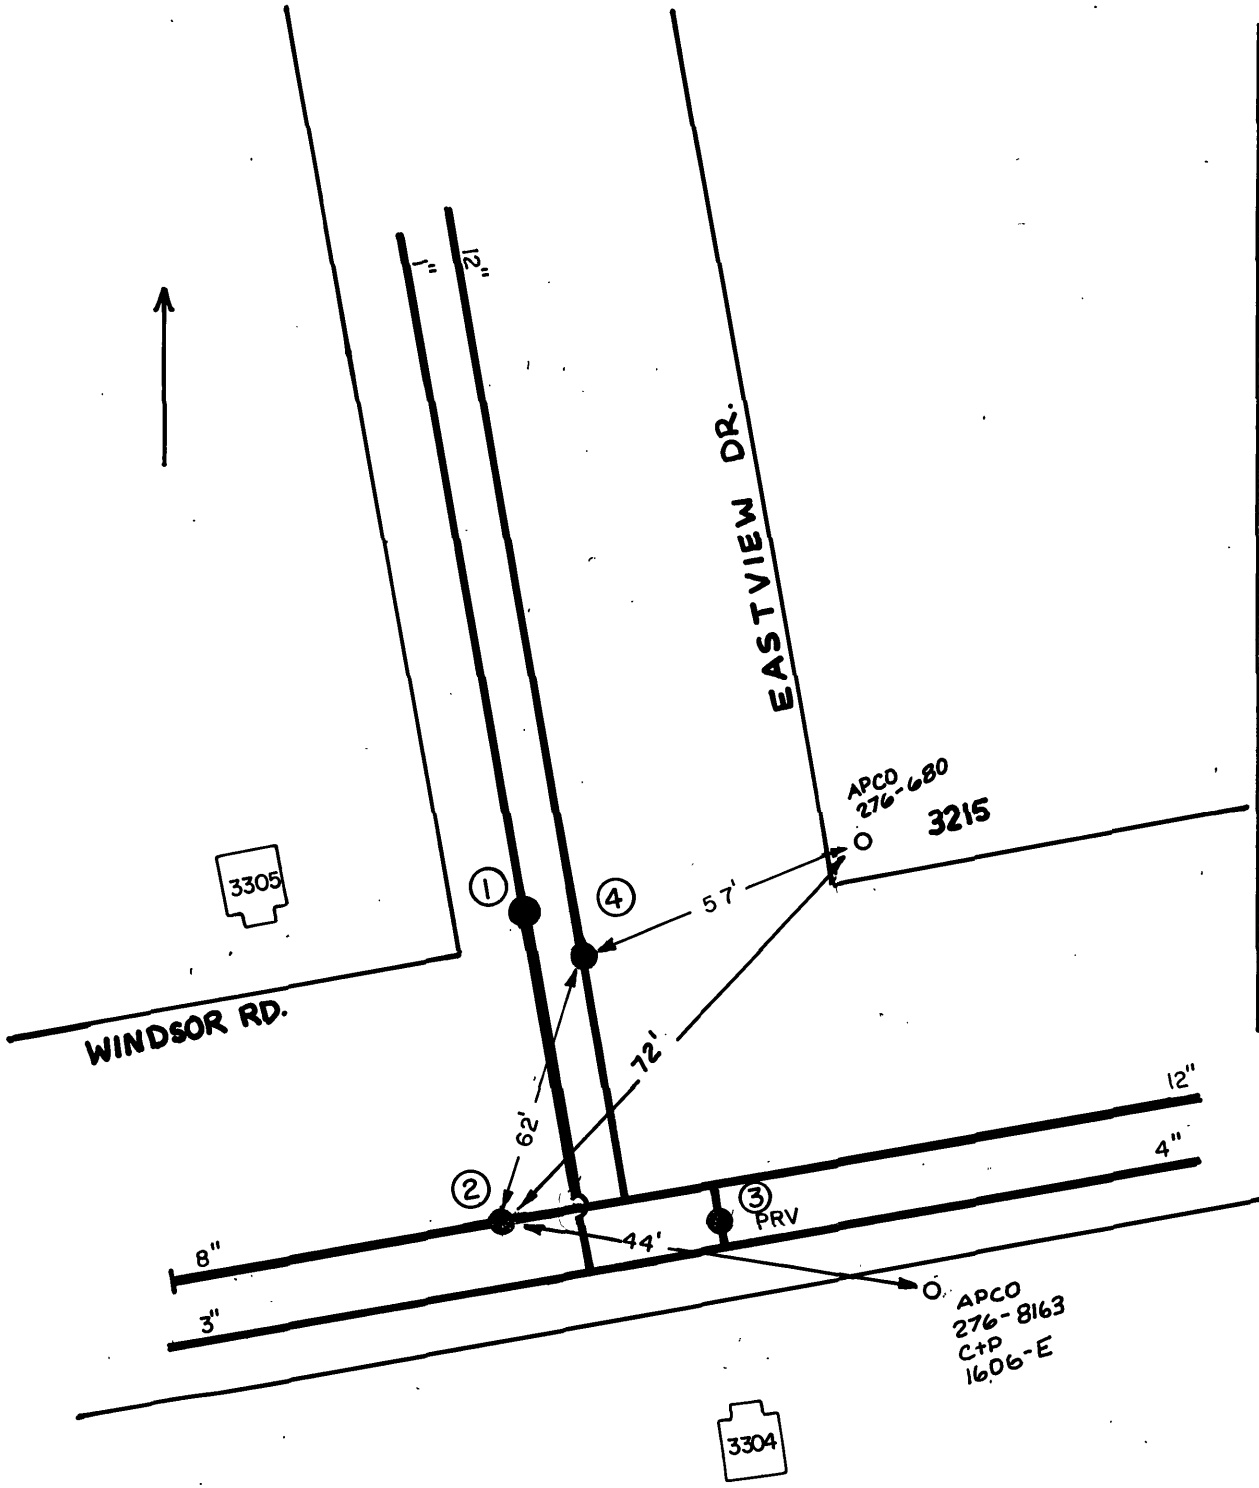

DATE	NO.	SIZE	MAKE	OPEN	TURNS
ANNEX 1976	1				
1979	2	8"	DARLING	R	26
1979	3	4"	PRESSURE REDUCER VALVE		
1979	4	12"	DARLING	R	38

CITY OF ROANOKE—WATER DEP'T

VALVE DIAGRAM

EASTVIEW DR. AND

WINDSOR RD. SW.

SEC. MAP 501

DATE 7/14/80 PAGE NO.

2/95 NP