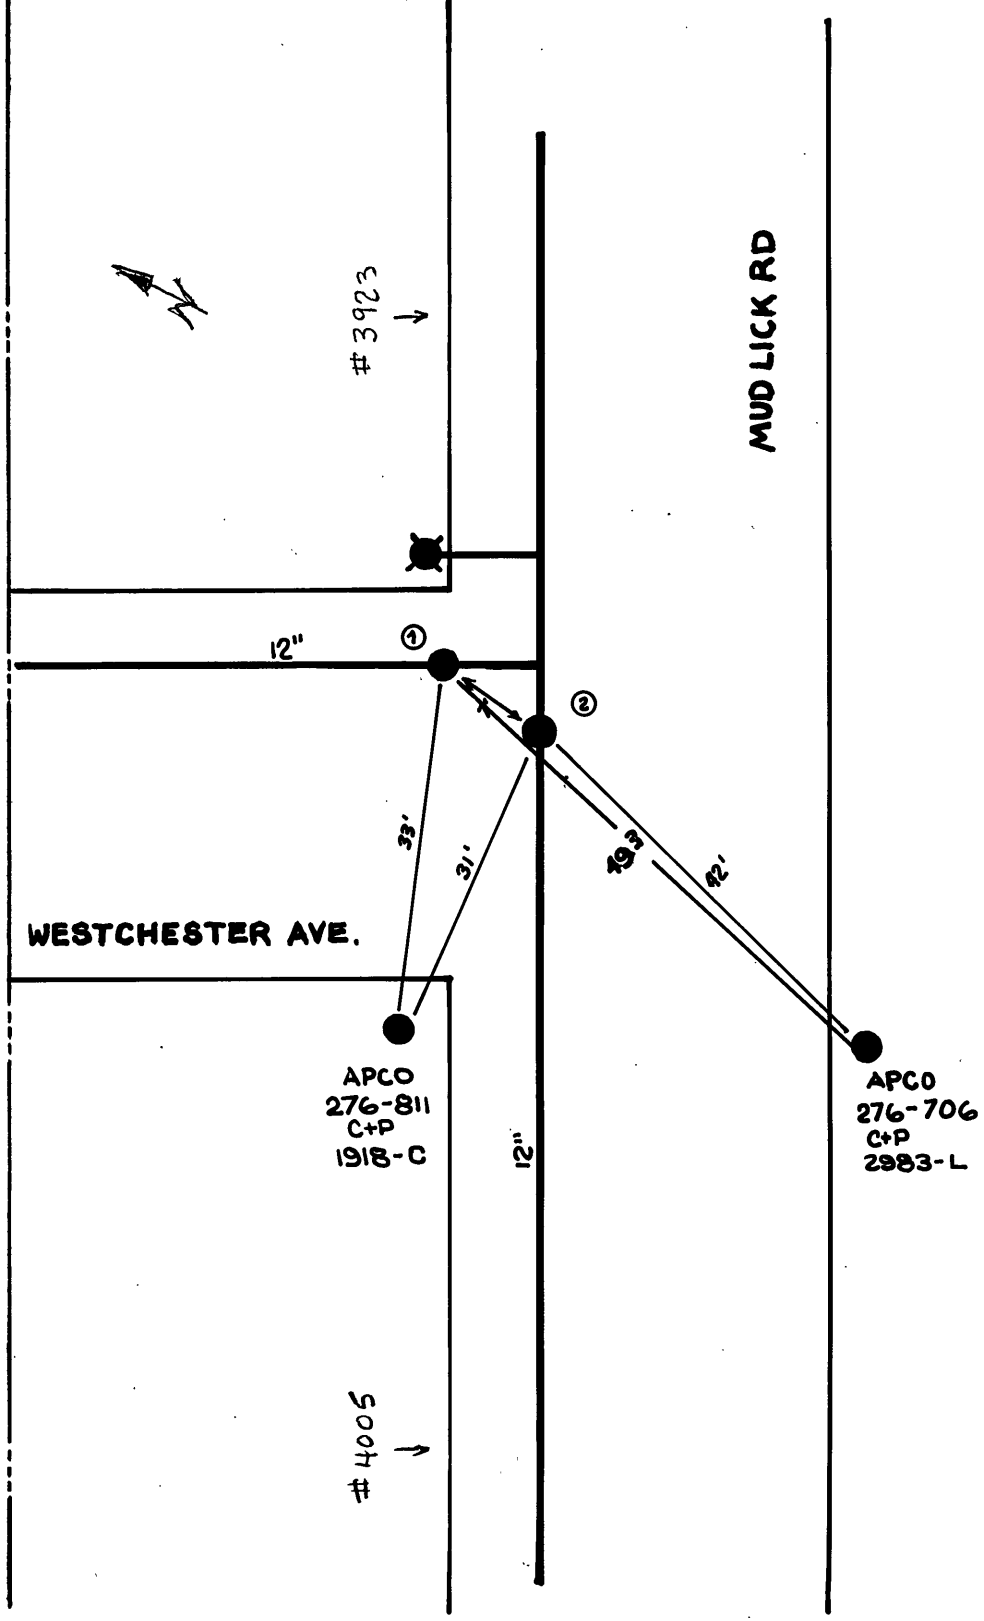

DATE	NO.	SIZE	MAKE	OPEN	TURNS
1979	1	12"	DARLING	R	38
1979	2	12"	DARLING	R	38

CITY OF ROANOKE—WATER DEP'T

VALVE DIAGRAM

MUD LICK RD. AND

WESTCHESTER AVE SW

SEC. MAP 506

DATE 7/14/80 PAGE NO.