DATE STARTED	3-31-97			
DATE COMP.	4-4-97			
FEET MAIN	SIZE	VALVE	VAULT	BOX
99	6	0	0	0
F.H. COMP. 0				
F.H. STUB ONLY 0				
SERV. INS. BY:				
MAIN INS. BY:				
NO. ¾" SERV. INS. ONE				
CITY OR CO.				
DEPT INSP.				

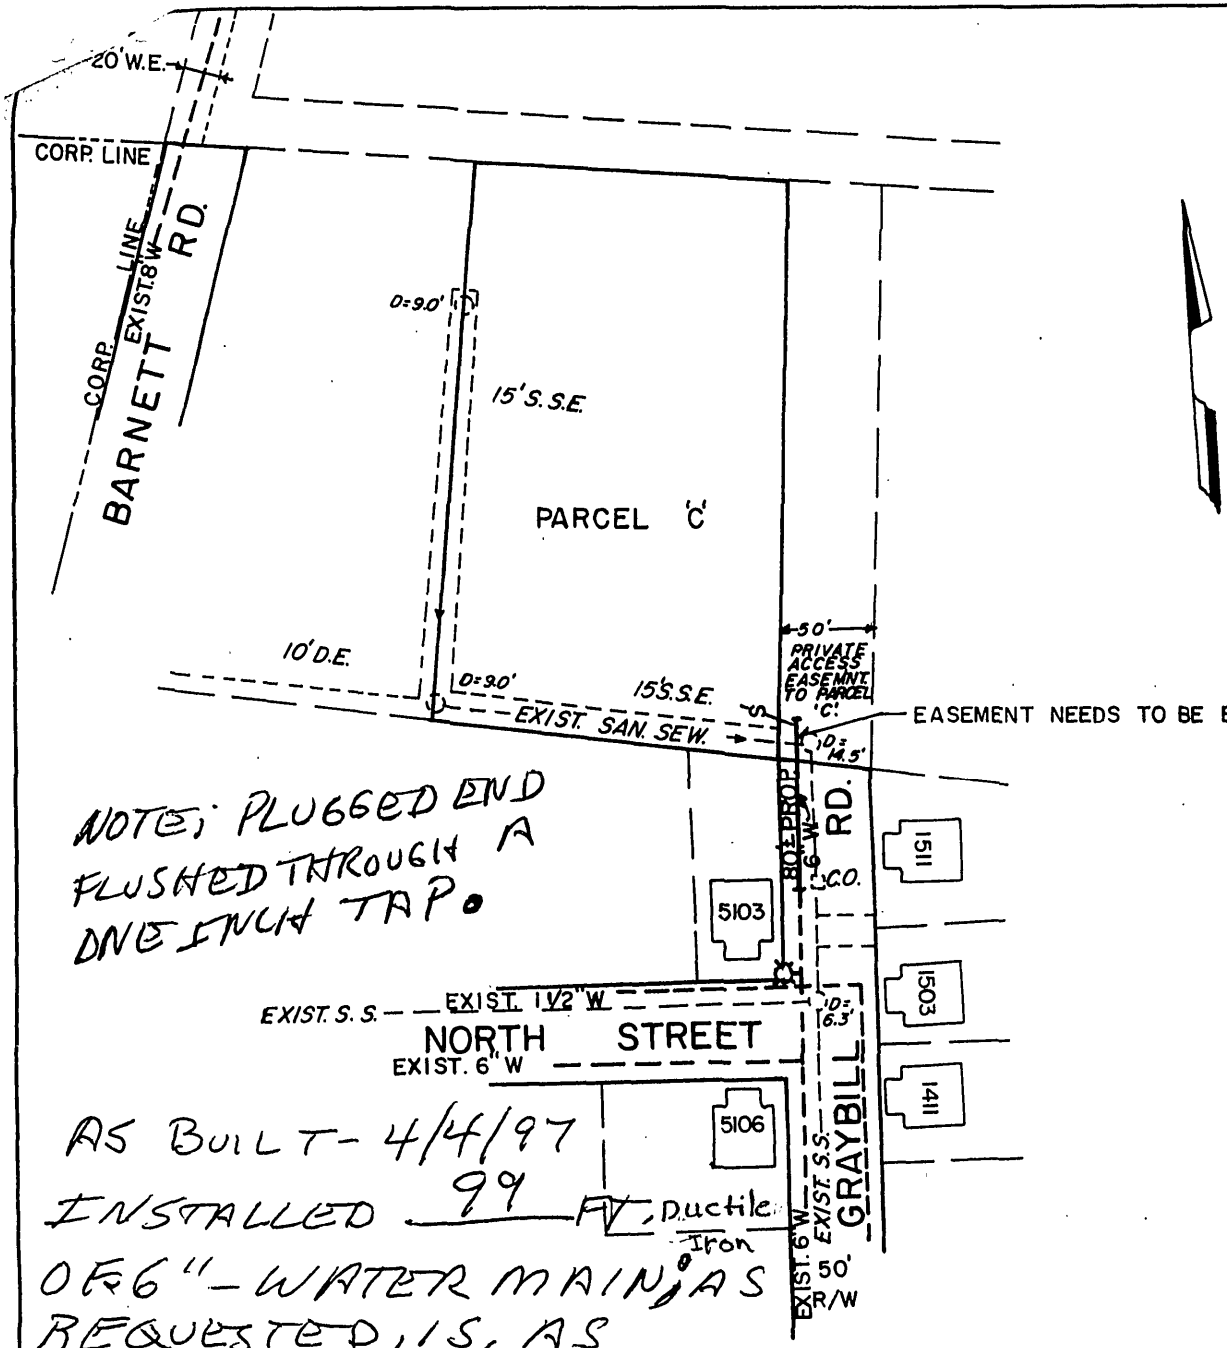

NOTE: PLUGGED END FLUSHED THROUGH A ONE INCH TAP.

AS BUILT - 4/4/97
INSTALLED 99 FT. Ductile Iron OF 6" - WATER MAIN, AS REQUESTED, IS, AS BUILT.

Calvin D. Dame

Samuel Vaughan III
MANAGER UTILITY LINE SERVICES

NOTE: LOCATION OF ALL EXIST. UTILITIES SHALL BE ASCERTAINED IN THE FIELD PRIOR TO CONSTRUCTION.

WATER DEPARTMENT
ROANOKE VIRGINIA

GRAYBILL ROAD, N.W.

SCALE: 1" = 100'	
DATE: 1/2/97	DIRECTOR UTILITIES & OPERATIONS DATE
DIST. MAP: 611	
PLAN NO.: 96-19	DIRECTOR OF PUBLIC WORKS DATE