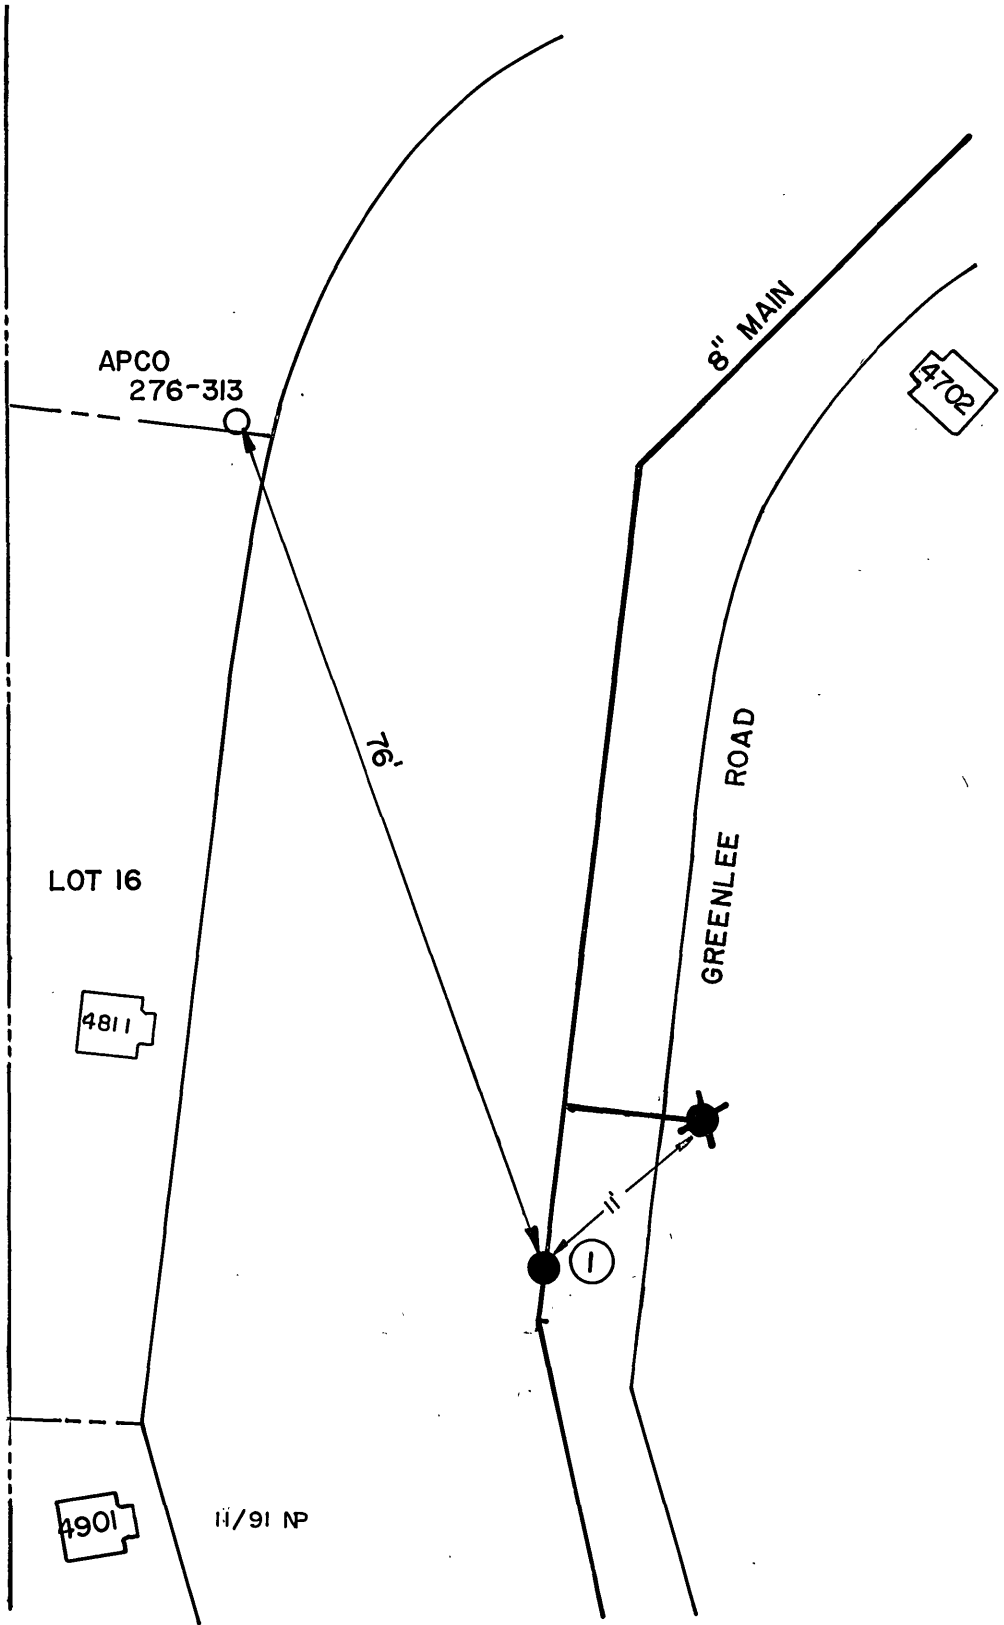

DATE	NO.	SIZE	MAKE	OPEN	TURNS
2-86	1	8"	MUELLER	R	27

CITY OF ROANOKE—WATER DEP'T

VALVE DIAGRAM

GREENLEE - 4800 BLOCK

SEC. MAP 515 S.W.

DATE PAGE NO.