19034-comp-06-pp03.plt

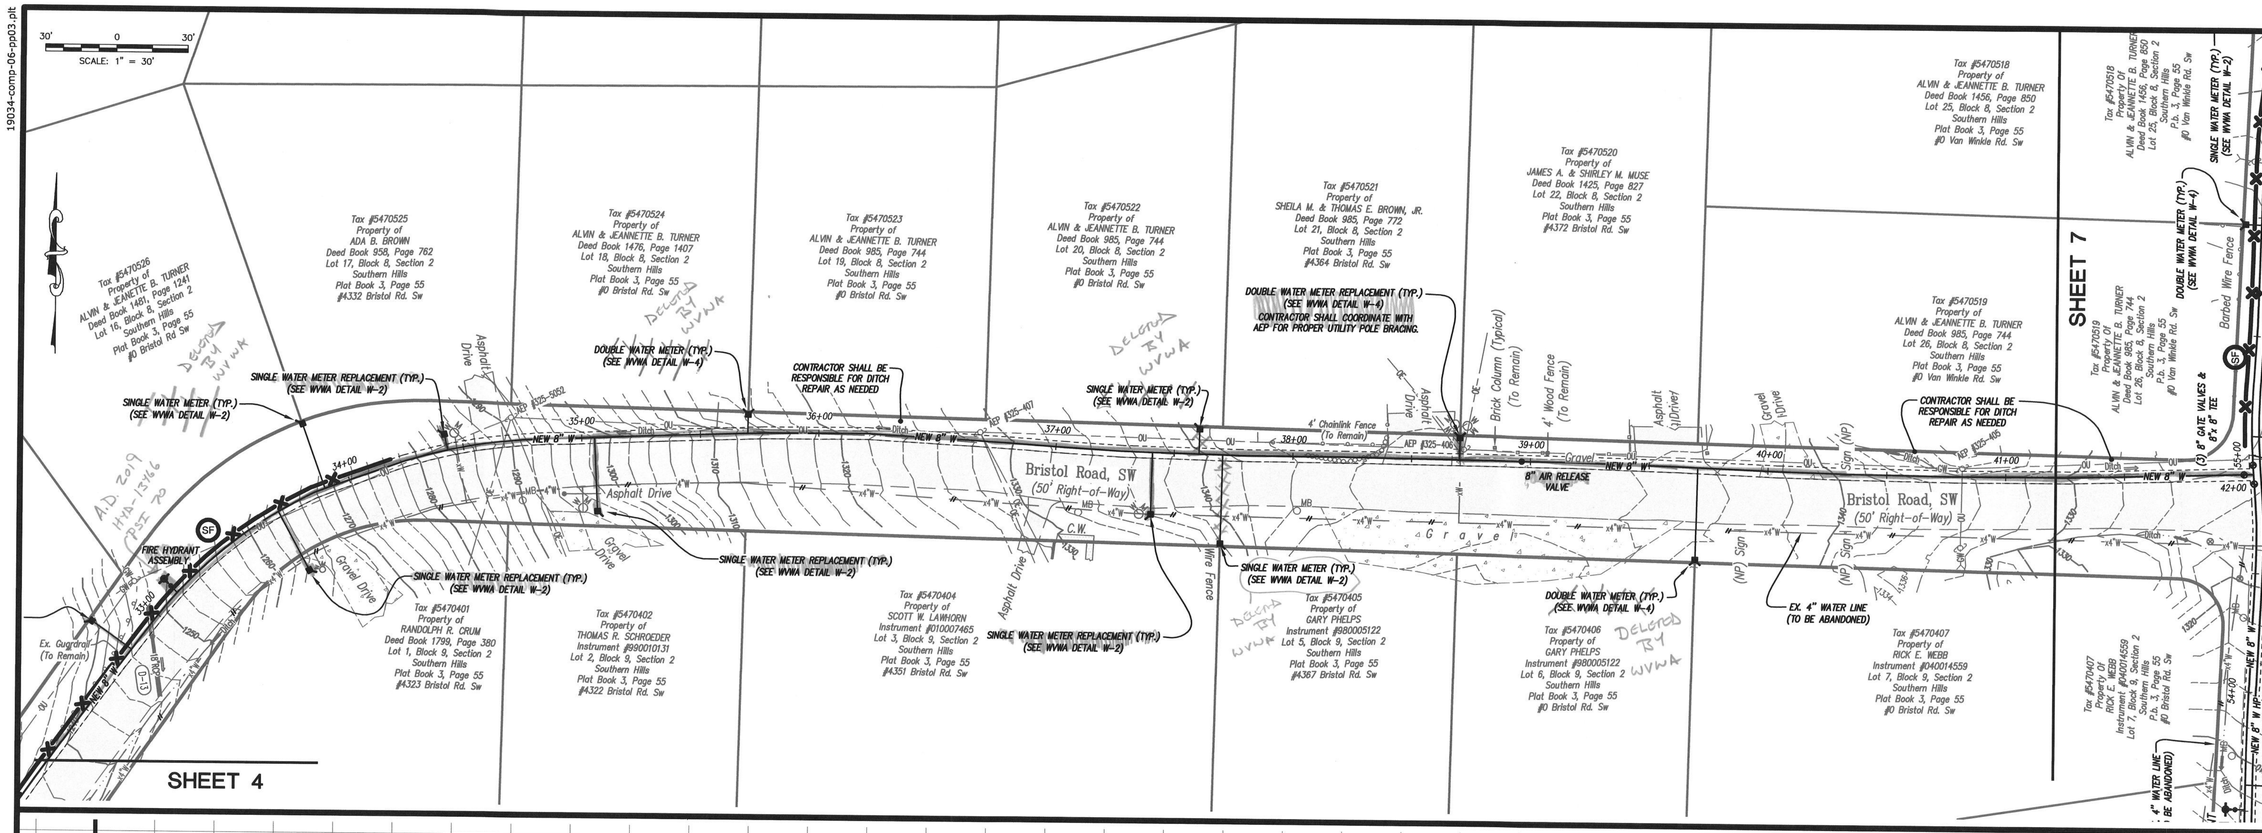

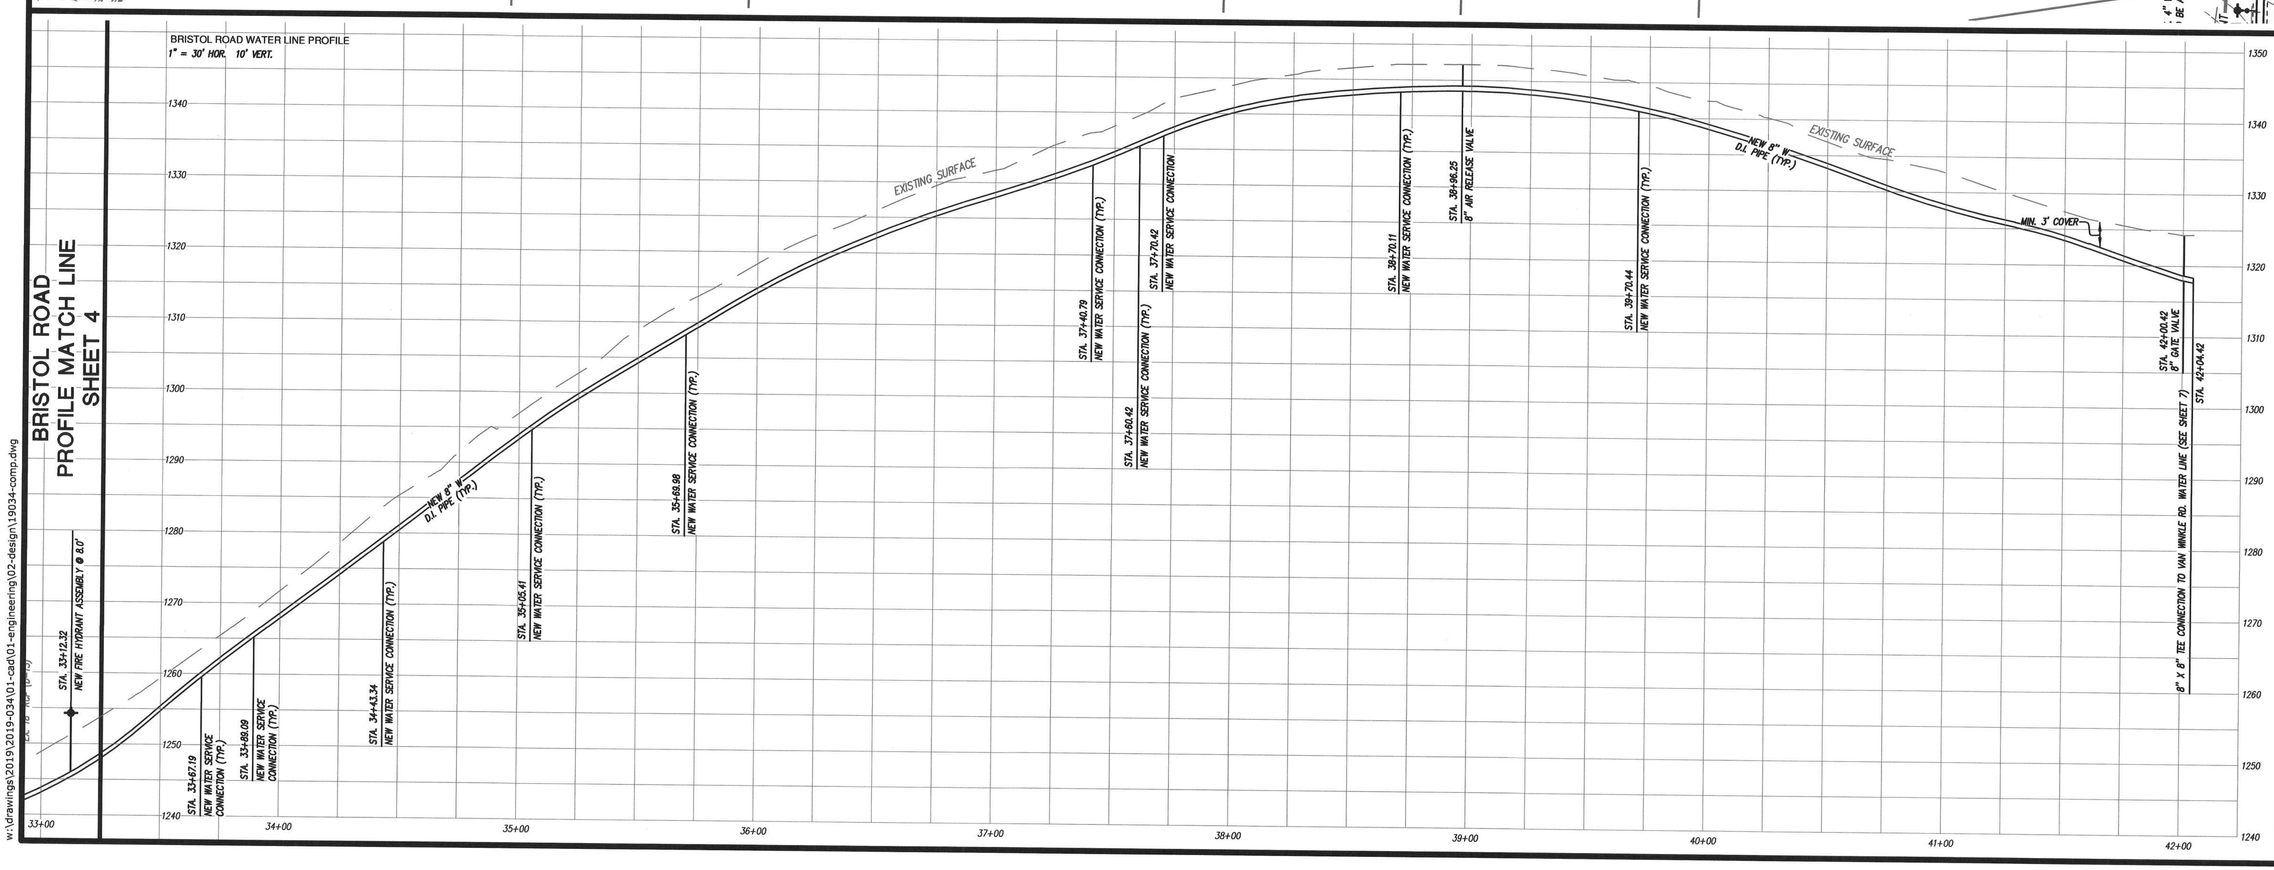

BRISTOL ROAD
PROFILE MATCH LINE
SHEET 4

w:\drawings\2019\2019-034\01-cad\01-engineering\02-design\19034-comp.dwg

Lumsden Associates, P.C.
ENGINEERS | SURVEYORS | PLANNERS
4664 BRAMBLETON AVENUE
P.O. BOX 20669
ROANOKE, VIRGINIA 24018
PHONE: (540) 774-4411
FAX: (540) 772-9445
WWW.LUMSDENPC.COM

COMMONWEALTH OF VIRGINIA
ANDREW P. LUMSDEN
Lic. No. 052216
12/18/19
PROFESSIONAL ENGINEER

PLAN & PROFILE BRISTOL ROAD

GRIFFIN / VAN WINKLE WATERLINE REPLACEMENTS

PREPARED FOR
WESTERN VIRGINIA WATER AUTHORITY
SITUATED IN
THE CITY OF ROANOKE, VIRGINIA

REVISIONS

NO.	DATE	DESCRIPTION
1		
2		
3		
4		
5		

DATE: December 18, 2019
SCALE: 1" = 30'
COMMISSION NO: 19-034
SHEET 6 OF 12