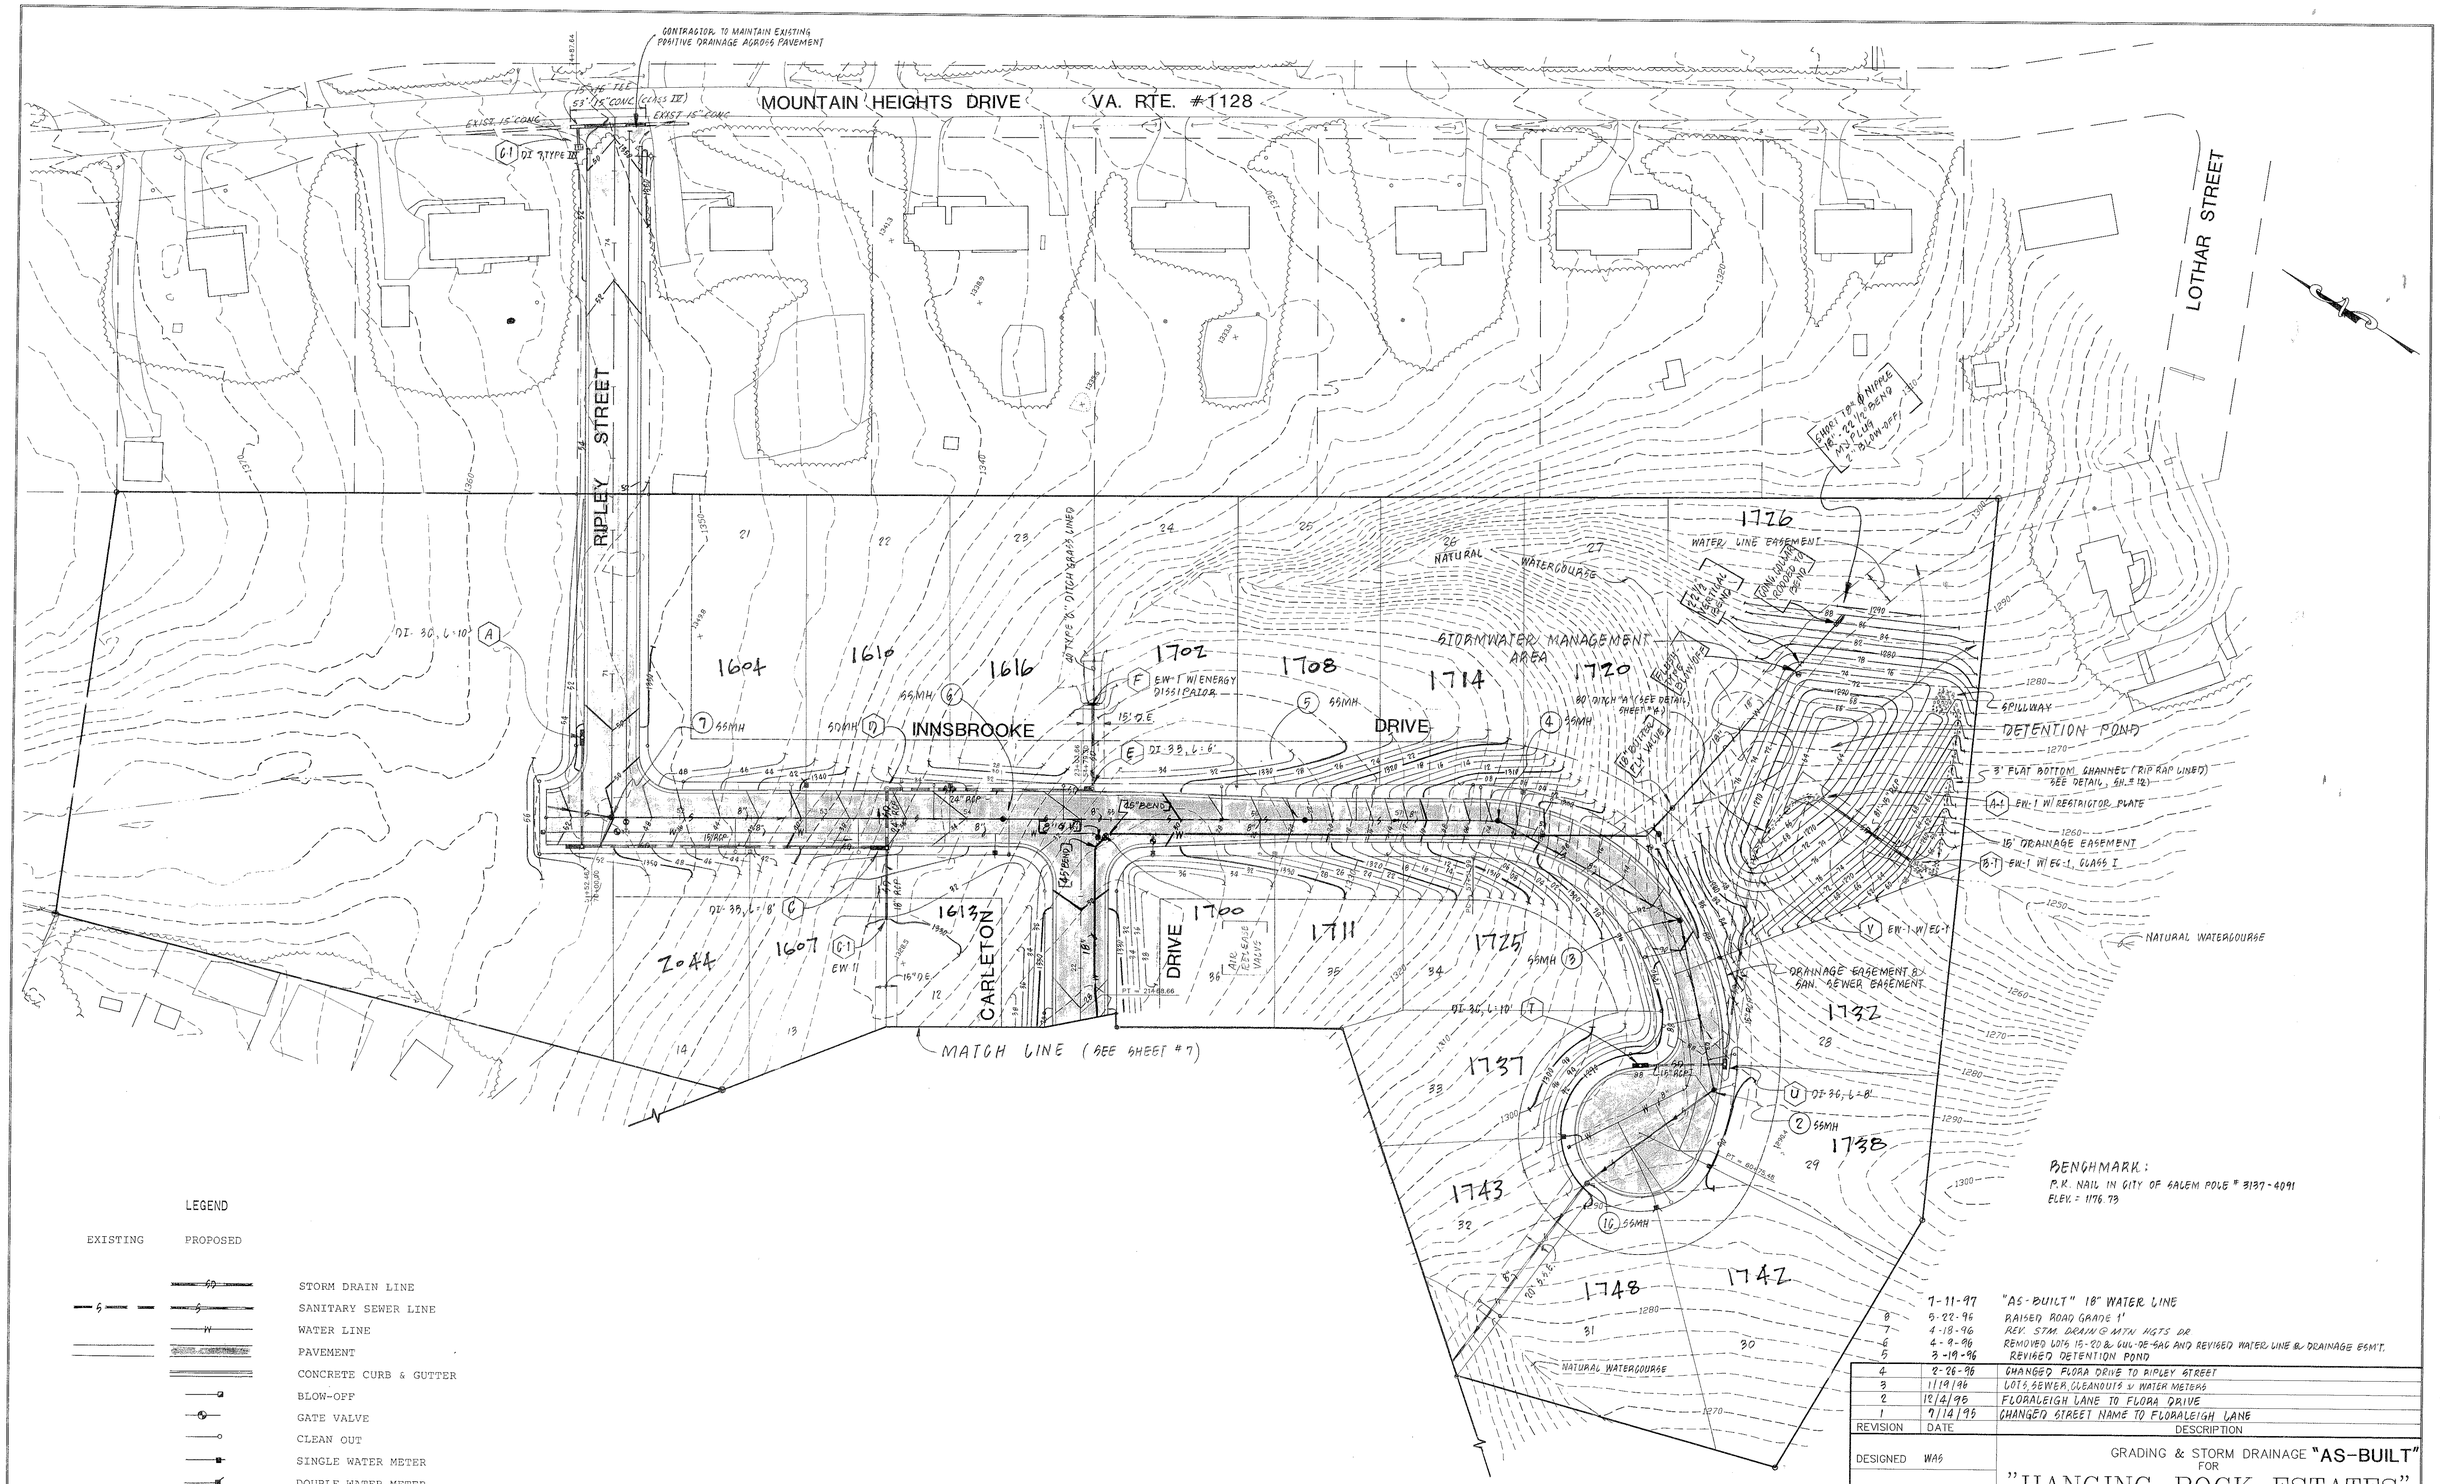

LEGEND

EXISTING	PROPOSED	
		STORM DRAIN LINE
		SANITARY SEWER LINE
		WATER LINE
		PAVEMENT
		CONCRETE CURB & GUTTER
		BLOW-OFF
		GATE VALVE
		CLEAN OUT
		SINGLE WATER METER
		DOUBLE WATER METER
		DROP INLET
		MANHOLE
		FIRE HYDRANT ASSEMBLY
1280	1280	CONTOURS

REVISION	DATE	DESCRIPTION
	7-11-97	"AS-BUILT" 18" WATER LINE
8	5-22-96	RAISED ROAD GRADE 1'
7	4-18-96	REV. STM. DRAIN @ MTN. HGTS. DR.
6	4-9-96	REMOVED LOTS 15-20 & CUL-DE-SAC AND REVISED WATER LINE & DRAINAGE ESM'T.
5	3-19-96	REVISED DETENTION POND
4	2-26-96	CHANGED FLORA DRIVE TO RIPLEY STREET
3	1/19/96	LOTS, SEWER, CLEANOUTS & WATER METERS
2	12/4/95	FLORALEIGH LANE TO FLORA DRIVE
1	7/14/95	CHANGED STREET NAME TO FLORALEIGH LANE

DESIGNED WAS
DRAWN VWB
CHECKED MSW

GRADING & STORM DRAINAGE **"AS-BUILT"**
FOR
"HANGING ROCK ESTATES"
PREPARED FOR
J. ROBERT CARLTON
CATAWBA MAGISTERIAL DISTRICT
ROANOKE COUNTY, VIRGINIA

COMMONWEALTH OF VIRGINIA
MICHAEL S. WEBB
No. 012656
5-30-95
PROFESSIONAL ENGINEER

LUMSDEN ASSOCIATES, P.C.
ENGINEERS-SURVEYORS-PLANNERS
ROANOKE, VIRGINIA

SCALE: 1" = 50'
COMM: #94-363
DATE: 23 JUNE 1995
SHEET 8 of 18

RC-6293