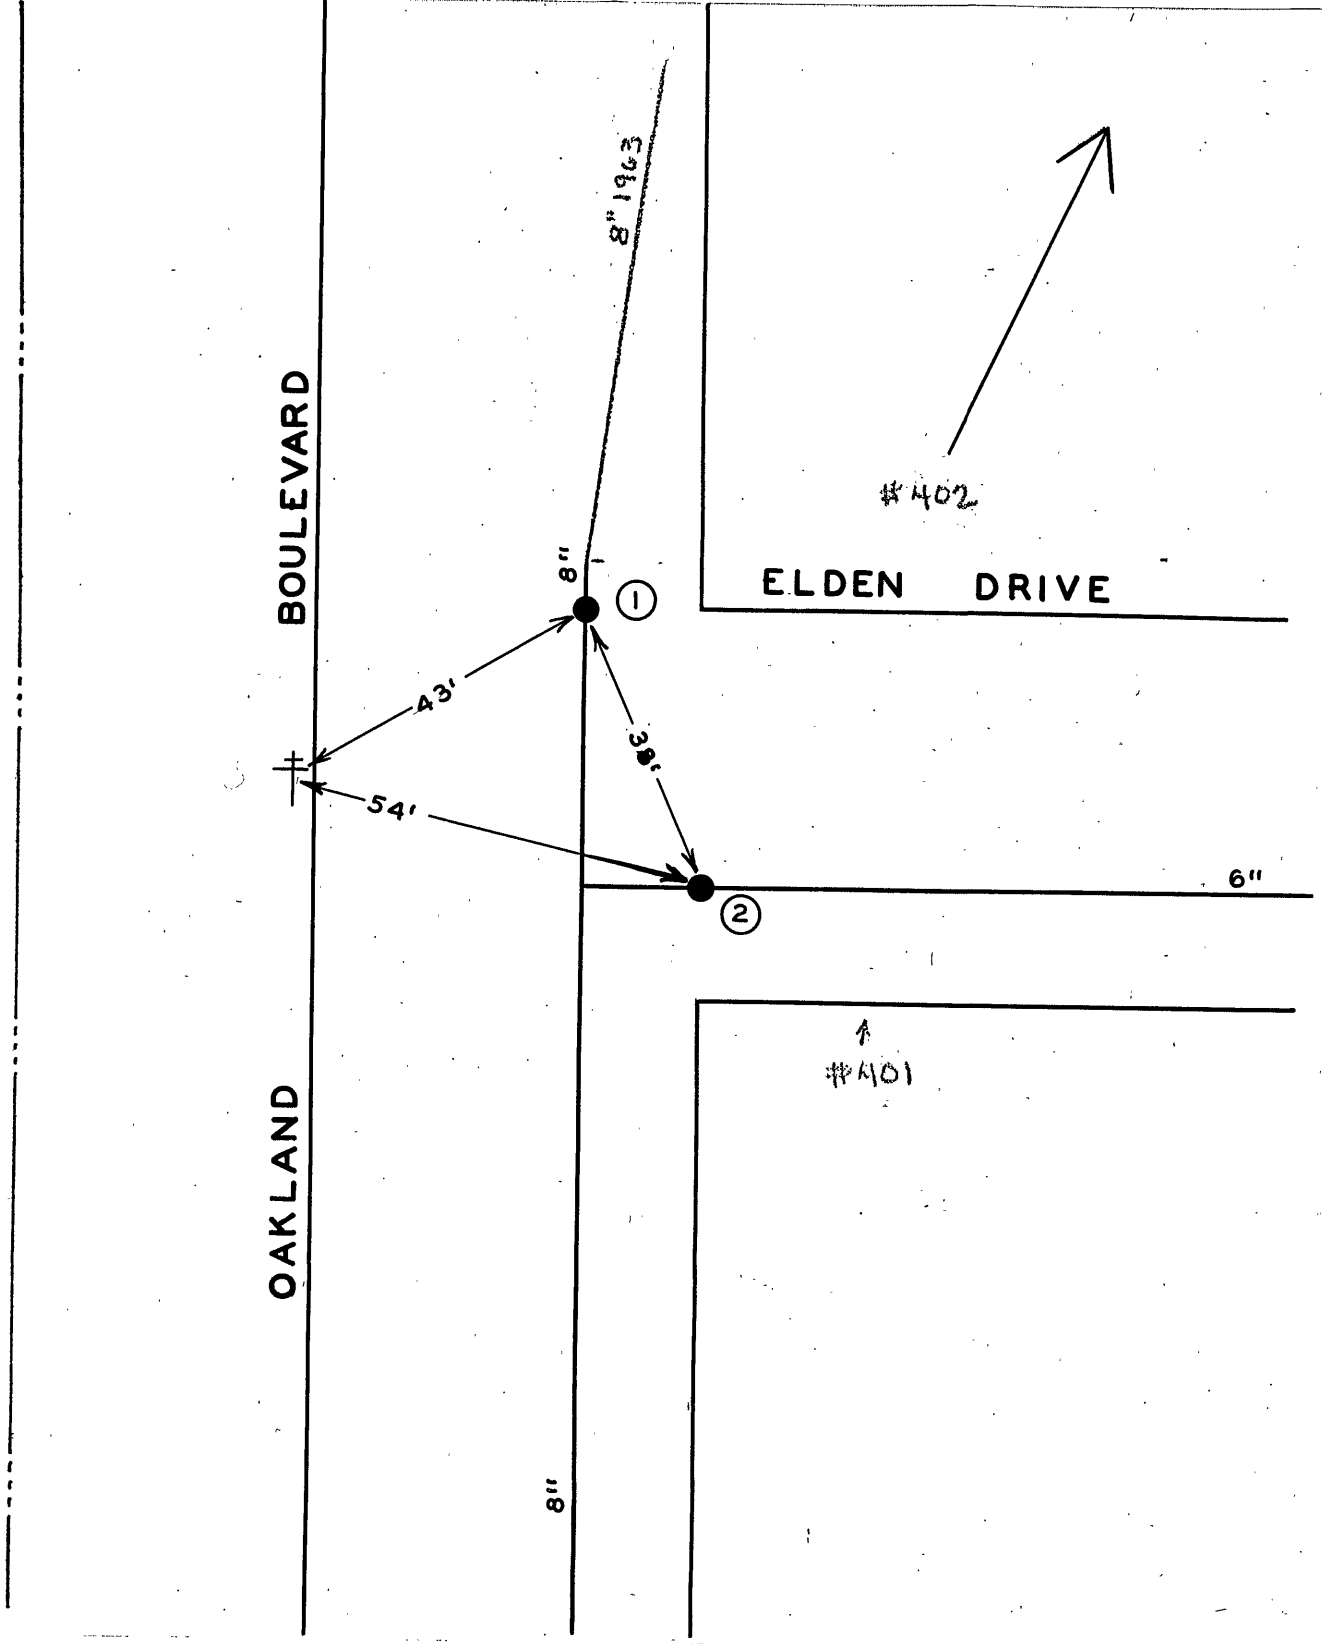

DATE	NO.	SIZE	MAKE	OPEN	TURNS
12-62	1	8"	MUELLER	R	26
12-62	2	6"	MUELLER	R	21
	1	0	N.P.L.		
	2	0	E.P.L.		

CITY OF ROANOKE—WATER DEPT.

VALVE DIAGRAM

ELDEN AVENUE &

OAKLAND BOULEVARD N.E.

SEC. MAP 46 Roanoke County

DATE PAGE NO.