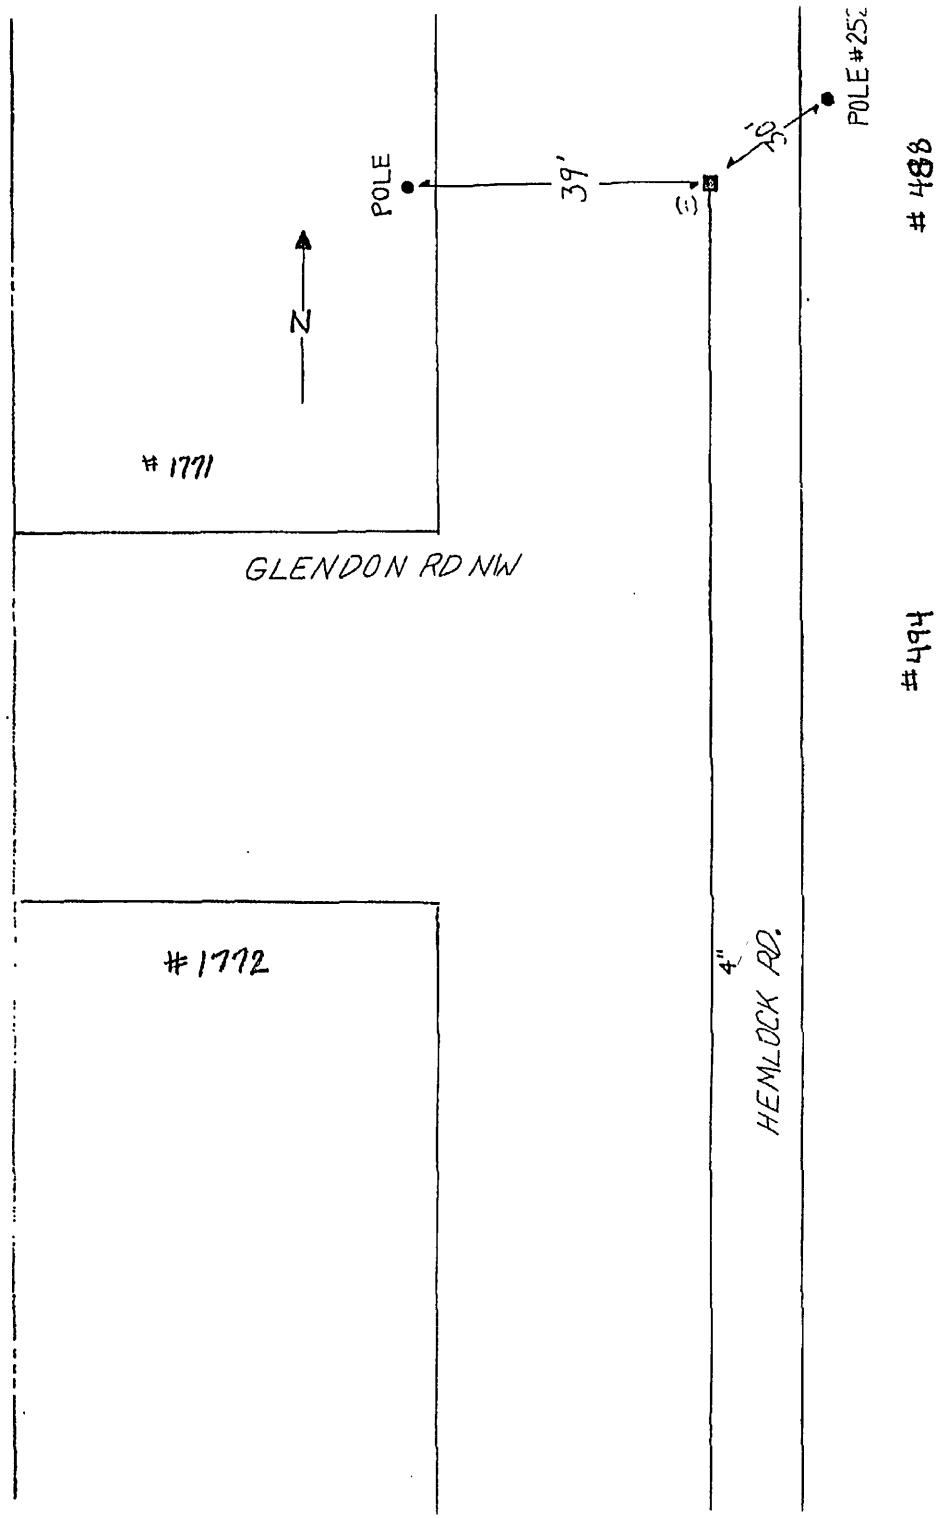

DATE	NO.	SIZE	MAKE	OPEN	TURNS
3-80	1	2"	MISC.	L	

CITY OF ROANOKE—WATER DEP'T

VALVE DIAGRAM

~~401~~ 488 HEMLOCK RD. NW. ℄ GLENDON RD

SEC. MAP

DATE PAGE NO