80-51A

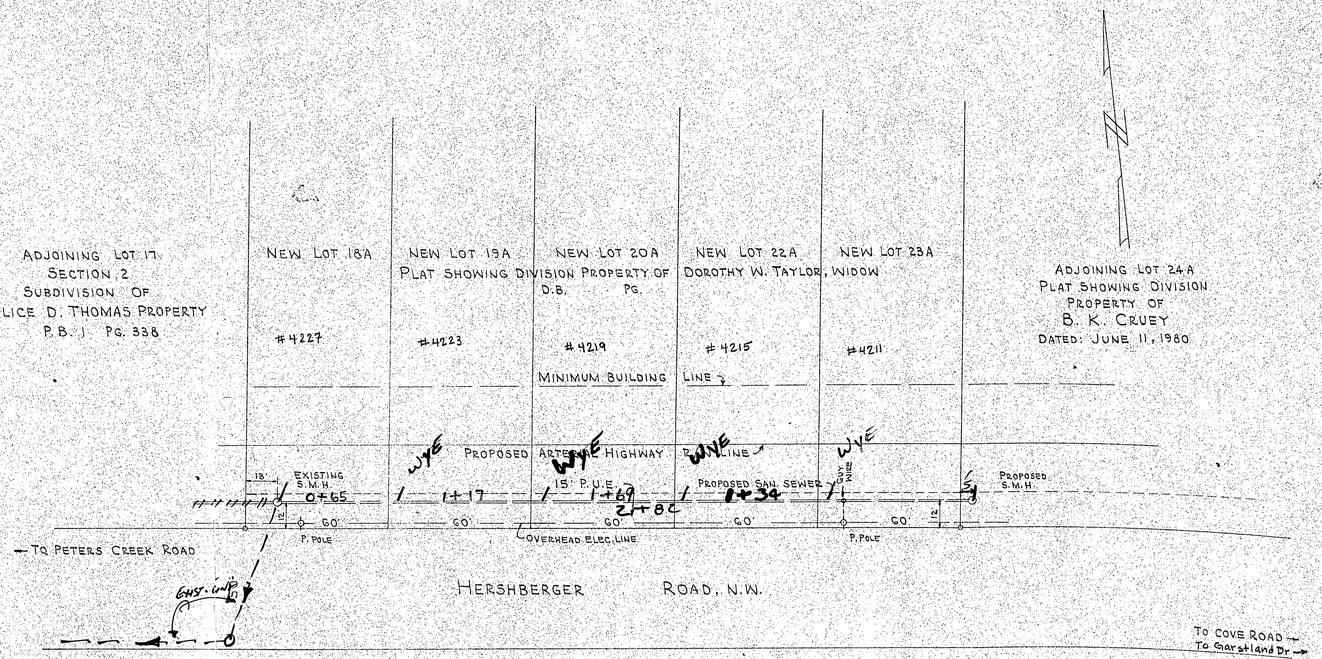

PLAN SCALE: 1" = 30'

APPROVED:

CITY ENGINEER, ROANOKE, VIRGINIA — DATE

GENERAL NOTES:

1. SANITARY SEWER MANHOLES, MATERIALS AND CONSTRUCTION TO CONFORM TO SPECIFICATIONS AND REQUIREMENTS OF THE CITY OF ROANOKE ENGINEERING DEPARTMENT. (SEE ATTACHED SPEC.)
2. CONTACT ENGINEERING DEPT. (MR. LOUIS WORRELL AT 981-2731) AT LEAST 24 HRS. IN ADVANCE, PRIOR TO INSTALLATION OF SANITARY SEWER LINE.
3. NEED LOCATION OF PROPERTY LINES FOR AS-BUILT.
4. ALL NECESSARY PERMITS SHALL BE OBTAINED FROM BUILDING DEPT. PRIOR TO ANY WORK.

RECEIVED CITY ENGINEERS

Approved in so far as this department has jurisdiction.
No construction to commence within public right of way without first obtaining permit from Director of Public Works.

City Engineer

COMMONWEALTH OF VIRGINIA
RAYMOND C. WEEKS
CERT. NO.
54-17-3(a)802
54-17-3(b)120
CERTIFIED LAND SURVEYOR

PLAN & PROFILE
MADE FOR
B. K. CRUEY

SHOWING PROPOSED SANITARY SEWER TO SERVE LOTS SHOWN ON PLAT SHOWING DIVISION PROPERTY OF DOROTHY W. TAYLOR, WIDOW
ROANOKE, VIRGINIA

BY: RAYMOND C. WEEKS
CERTIFIED LAND SURVEYOR

DATE: JULY 28, 1980 — SCALES: AS NOTED

PLAN		BY	DATE
	SURVEYED		
	PLOTTED		
NOTE BOOK	ALIGNMENT CHECKED		
	BC. OF WAY CHECKED		
No.			

PROFILE		BY	DATE
	SURVEYED		
	PLOTTED		
NOTE BOOK	GRADES CHECKED		
	B.M. & INT. LOCATIONS CHECKED		
No.			

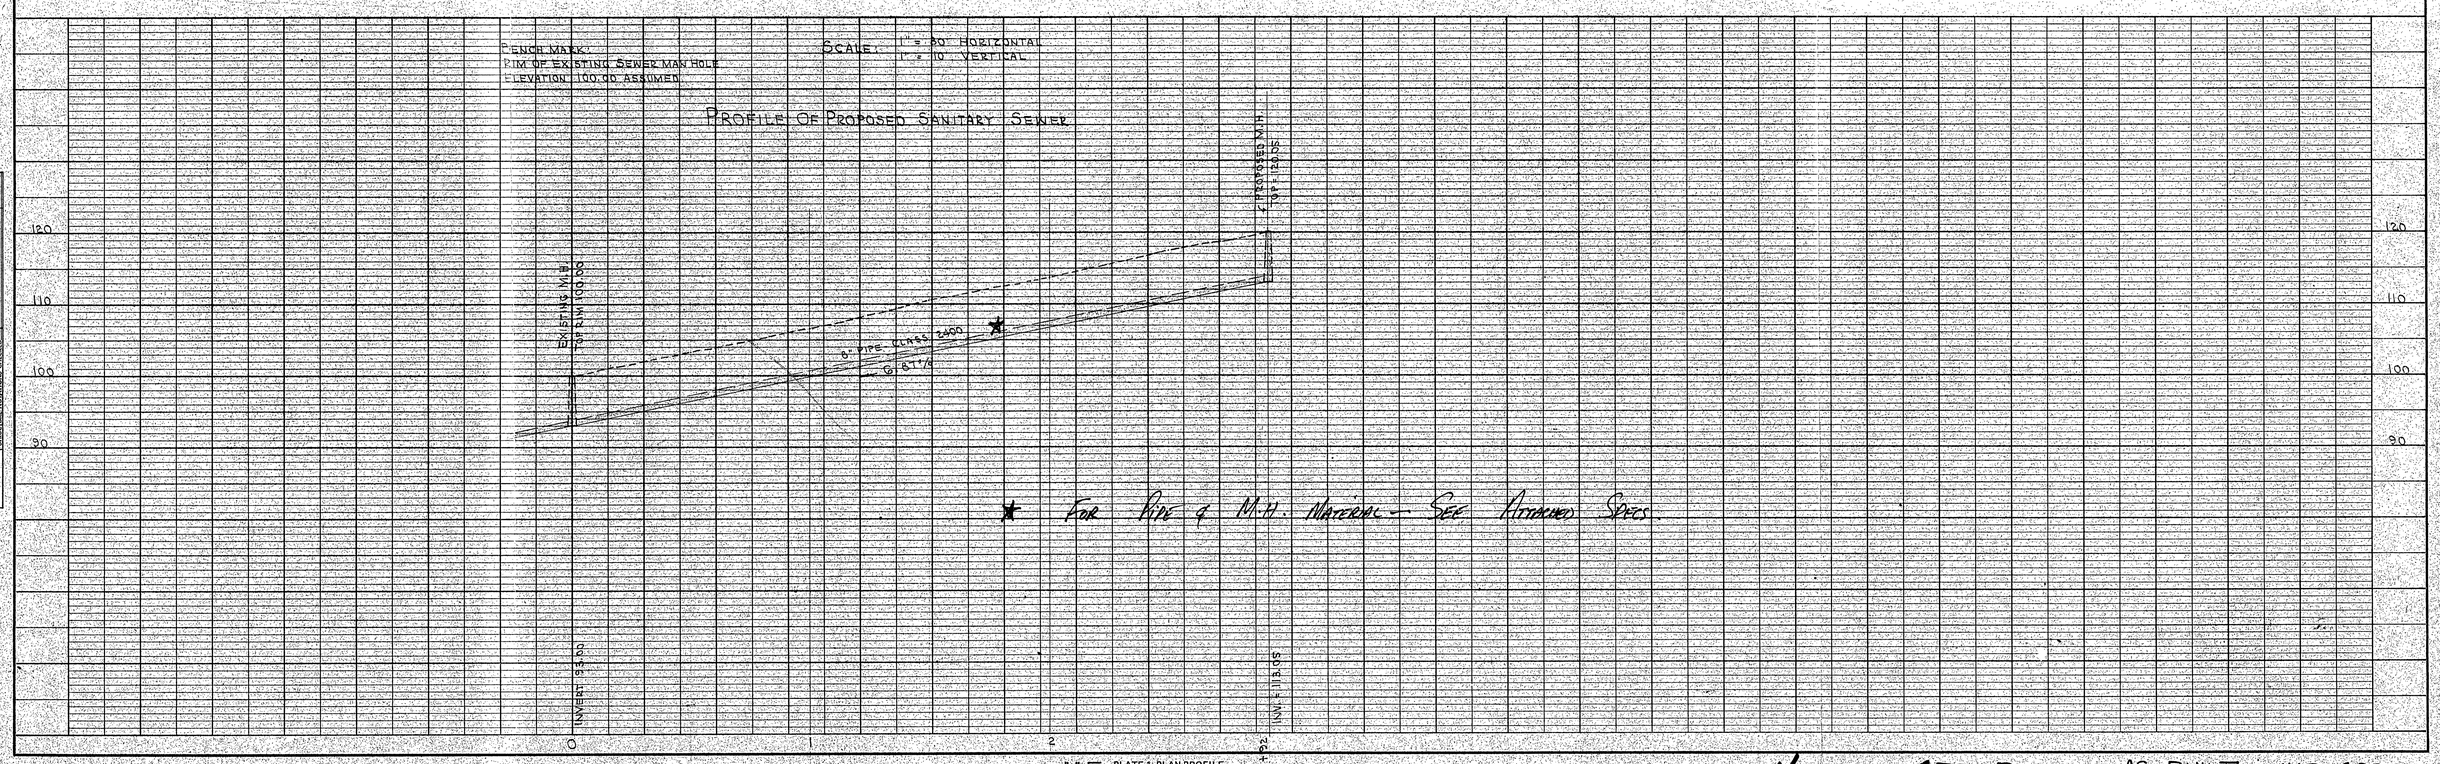

★ FOR PIPE & M.H. MATERIAL — SEE ATTACHED SPECS.

K+E PLATE 1, PLAN-PROFILE
KEUFFEL & ESSER CO.
48 7008 MADE IN U.S.A.

HERSHBERGER ROAD AS-BUILT MAP 638
12/23/80 LBV