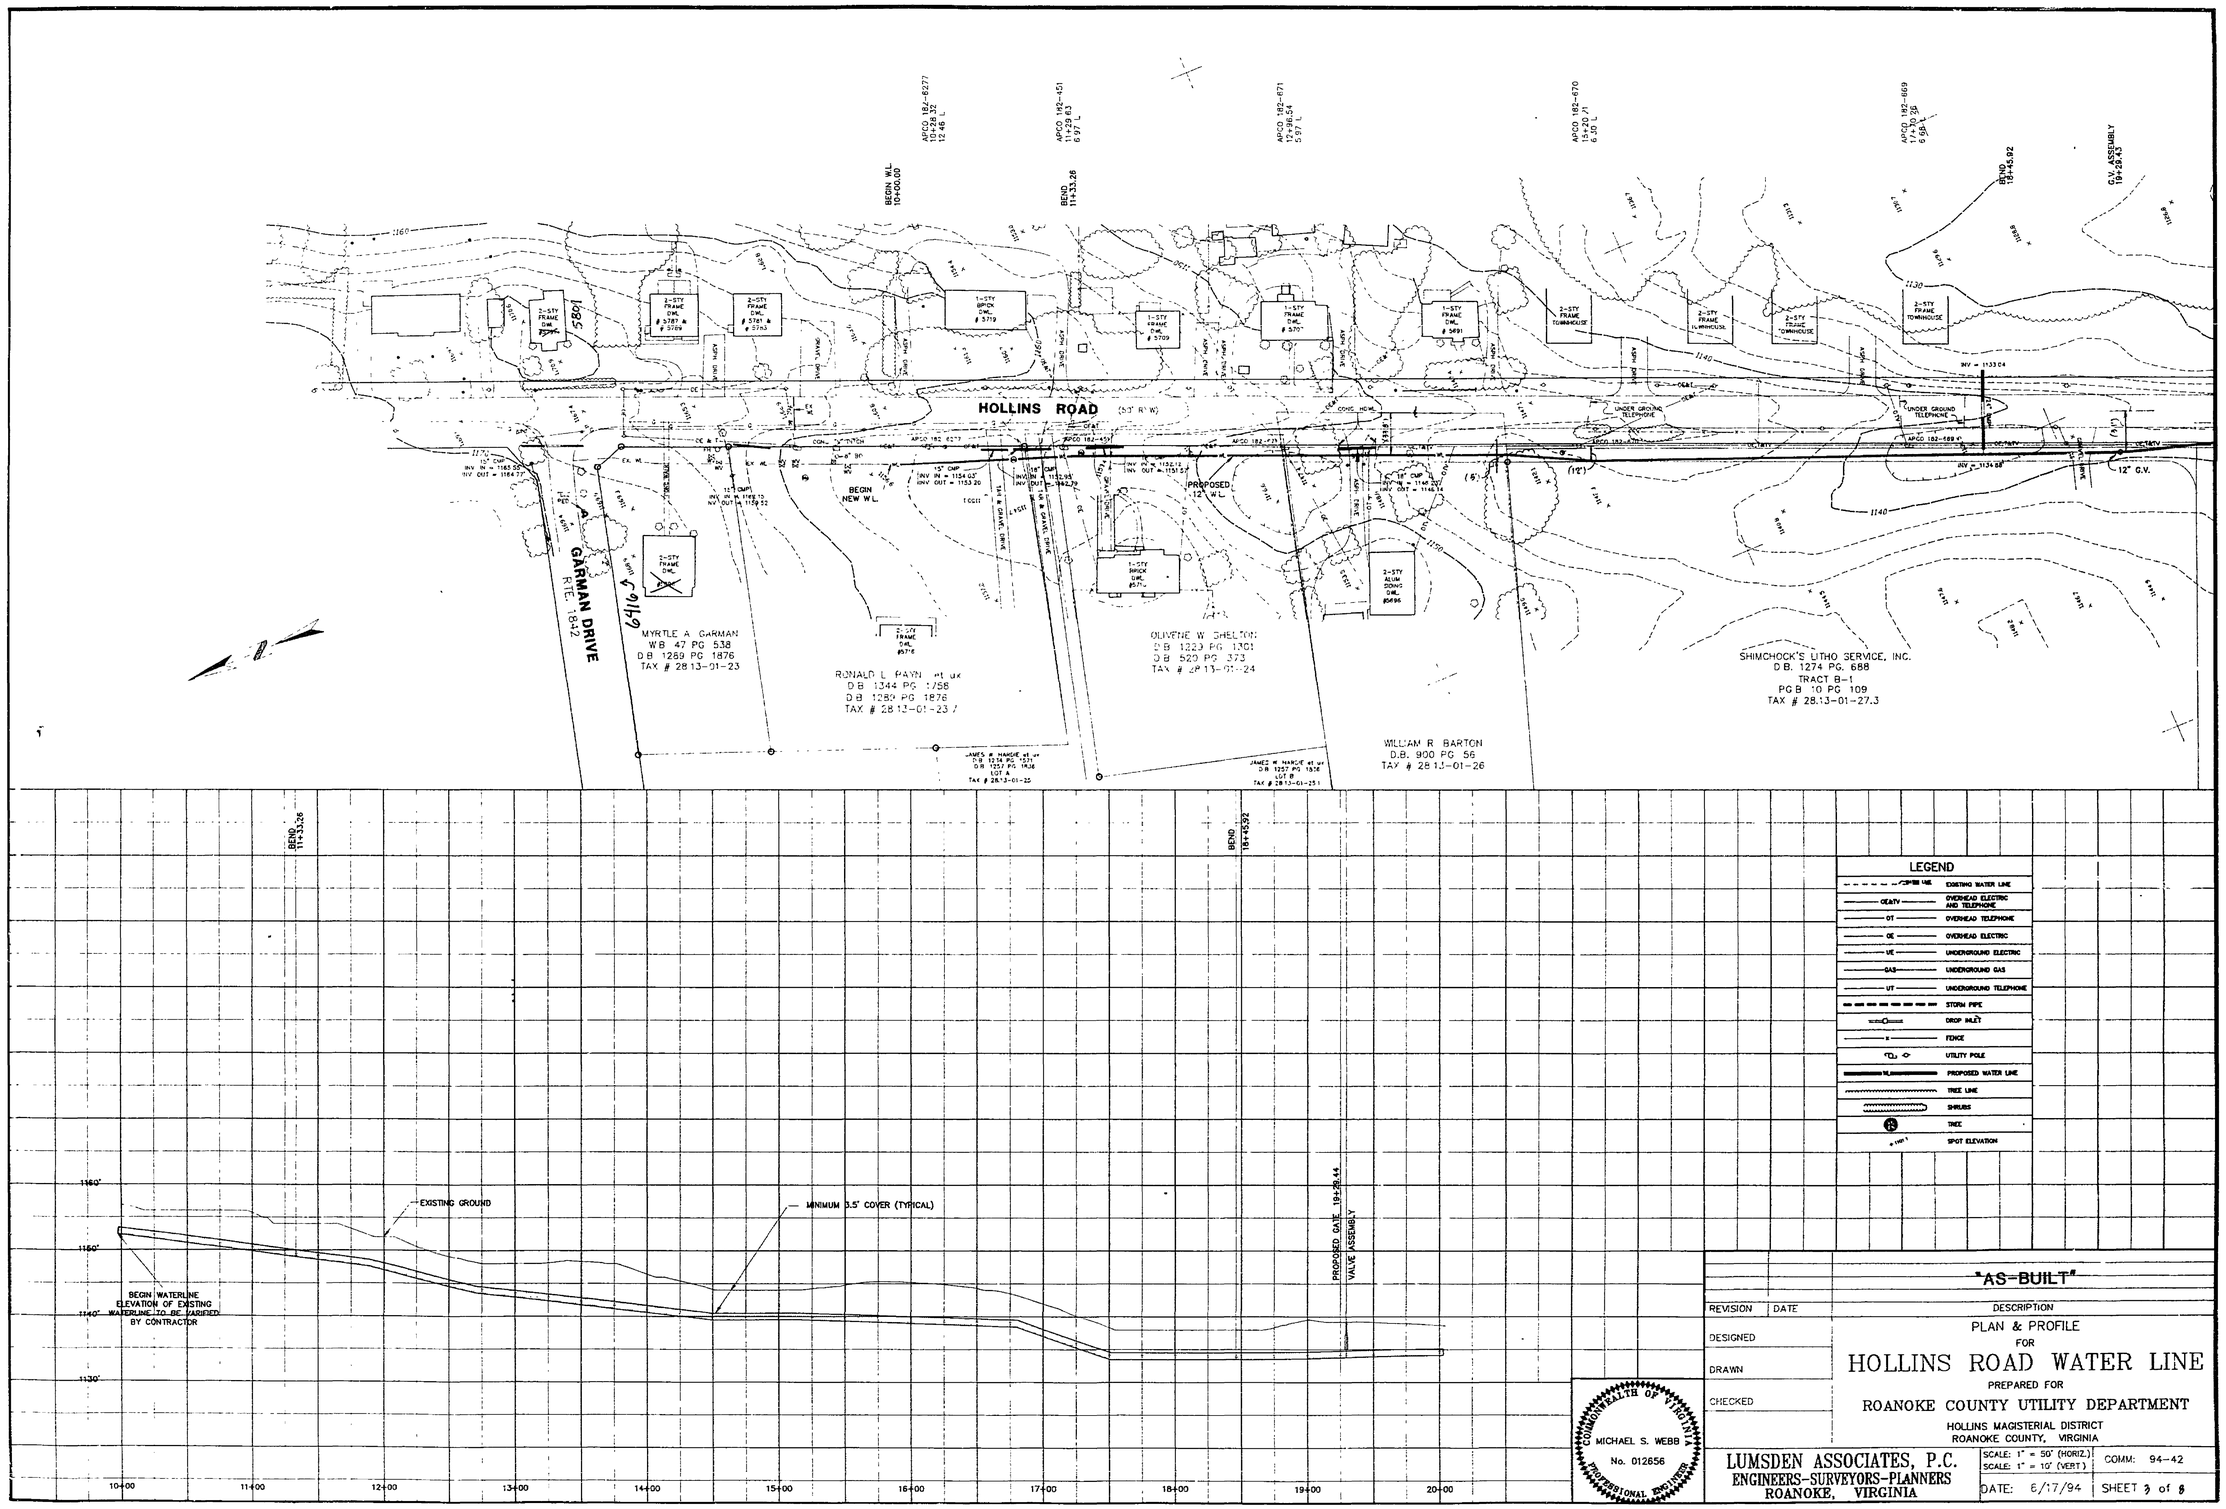

LEGEND

	EXISTING WATER LINE
OE&TV	OVERHEAD ELECTRIC AND TELEPHONE
OT	OVERHEAD TELEPHONE
OE	OVERHEAD ELECTRIC
UE	UNDERGROUND ELECTRIC
GAS	UNDERGROUND GAS
UT	UNDERGROUND TELEPHONE
	STORM PIPE
	DROP INLET
	FENCE
	UTILITY POLE
	PROPOSED WATER LINE
	TREE LINE
	SHRUBS
	TREE
	SPOT ELEVATION

COMMONWEALTH OF VIRGINIA
MICHAEL S. WEBB
No. 012656
PROFESSIONAL ENGINEER

"AS-BUILT"

REVISION	DATE	DESCRIPTION

DESIGNED
DRAWN
CHECKED

PLAN & PROFILE
FOR
HOLLINS ROAD WATER LINE
PREPARED FOR
ROANOKE COUNTY UTILITY DEPARTMENT
HOLLINS MAGISTERIAL DISTRICT
ROANOKE COUNTY, VIRGINIA

LUMSDEN ASSOCIATES, P.C.
ENGINEERS-SURVEYORS-PLANNERS
ROANOKE, VIRGINIA

SCALE: 1" = 50' (HORIZ.)
SCALE: 1" = 10' (VERT.)
COMM: 94-42
DATE: 6/17/94
SHEET 3 of 8

WT-0432