PROJECT NOTES:

1. CONTRACTOR SHALL BE REQUIRED TO USE THE VDOT APPROVED TRAFFIC CONTROL PLAN APPROVED FOR THE HONEY TREE PROJECT.
2. UNLESS OTHERWISE INDICATED, ALL VEGETATEIVE AND STRUCTURAL EROSION AND SEDIMENT PRACTICES WILL BE CONSTRUCTED AND MAINTAINED ACCORDING TO THE MINIMUM STANDARDS AND SPECIFICATIONS ON THE VIRGINIA EROSION & SEDIMENT CONTROL HANDBOOK AND VIRGINIA REGULATIONS VR 625-02-00 EROSION AND SEDIMENT CONTROL REGULATIONS.
3. THE CONTRACTOR IS RESPONSIBLE FOR ANY MAINTAINING AND INSTALLING ANY ADDITIONAL EROSION & SEDIMENT CONTROL MEASURES TO PREVENT EROSION AND SEDIMENTATION AS NEEDED.

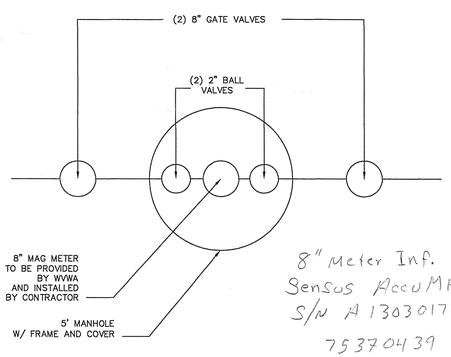

8" Meter Inf.
Sensus AccuMAG
S/N A13030172
75370439

DMA METER DETAIL

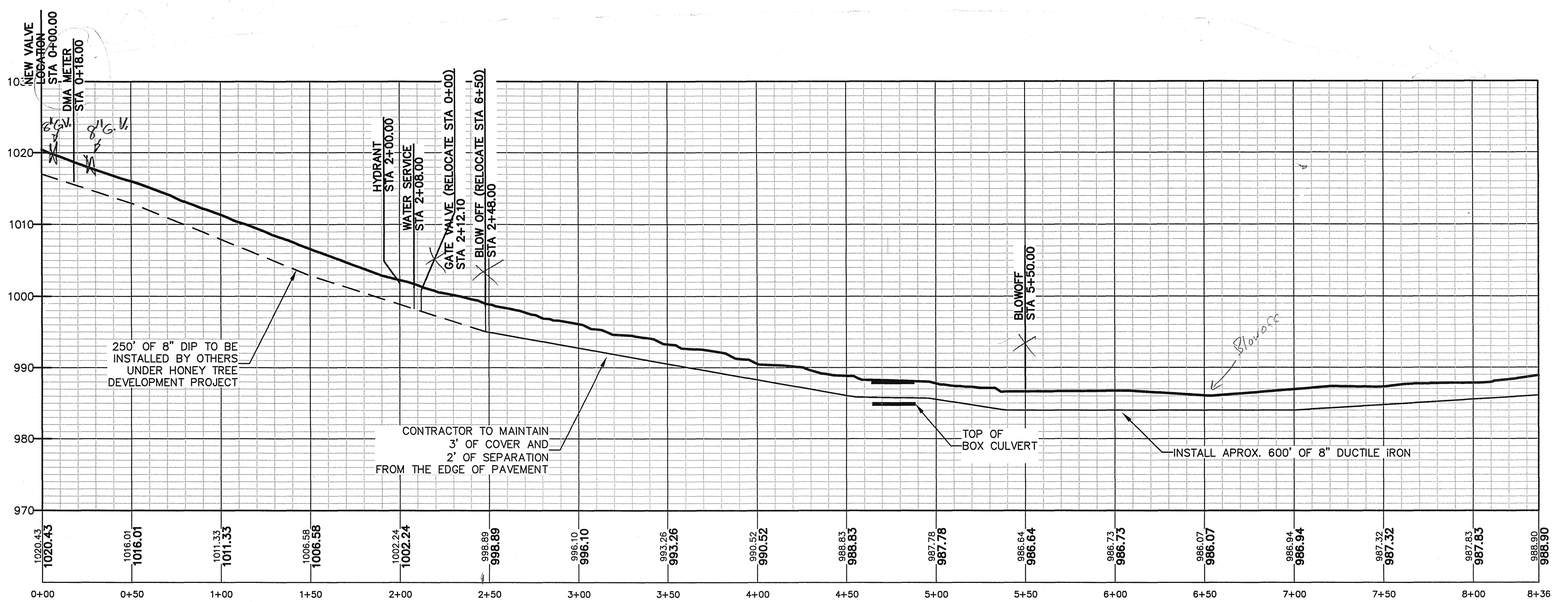

HERSHBERGER
SCALE
VERTICAL: 1" = 10'
HORIZONTAL: 1" = 40'

WESTERN VIRGINIA WATER AUTHORITY
ENGINEERING SERVICES
601 S JEFFERSON ST, SUITE 300
ROANOKE, VA 24011
540-853-5641 or 540-853-5770

COMMONWEALTH OF VIRGINIA
DAVID M. VOELSONG
Lic. No. 023274
PROFESSIONAL ENGINEER

HERSHBERGER WATER

PLAN & PROFILE

Rev	Description	Date	By

Designed: AAS
Drawn: AAS
Checked: DMV
Approved: DMV
Date: 3-25-13
Project:

1
Sheet 1 of 1

New Plan

AS-Builts 6-3-13