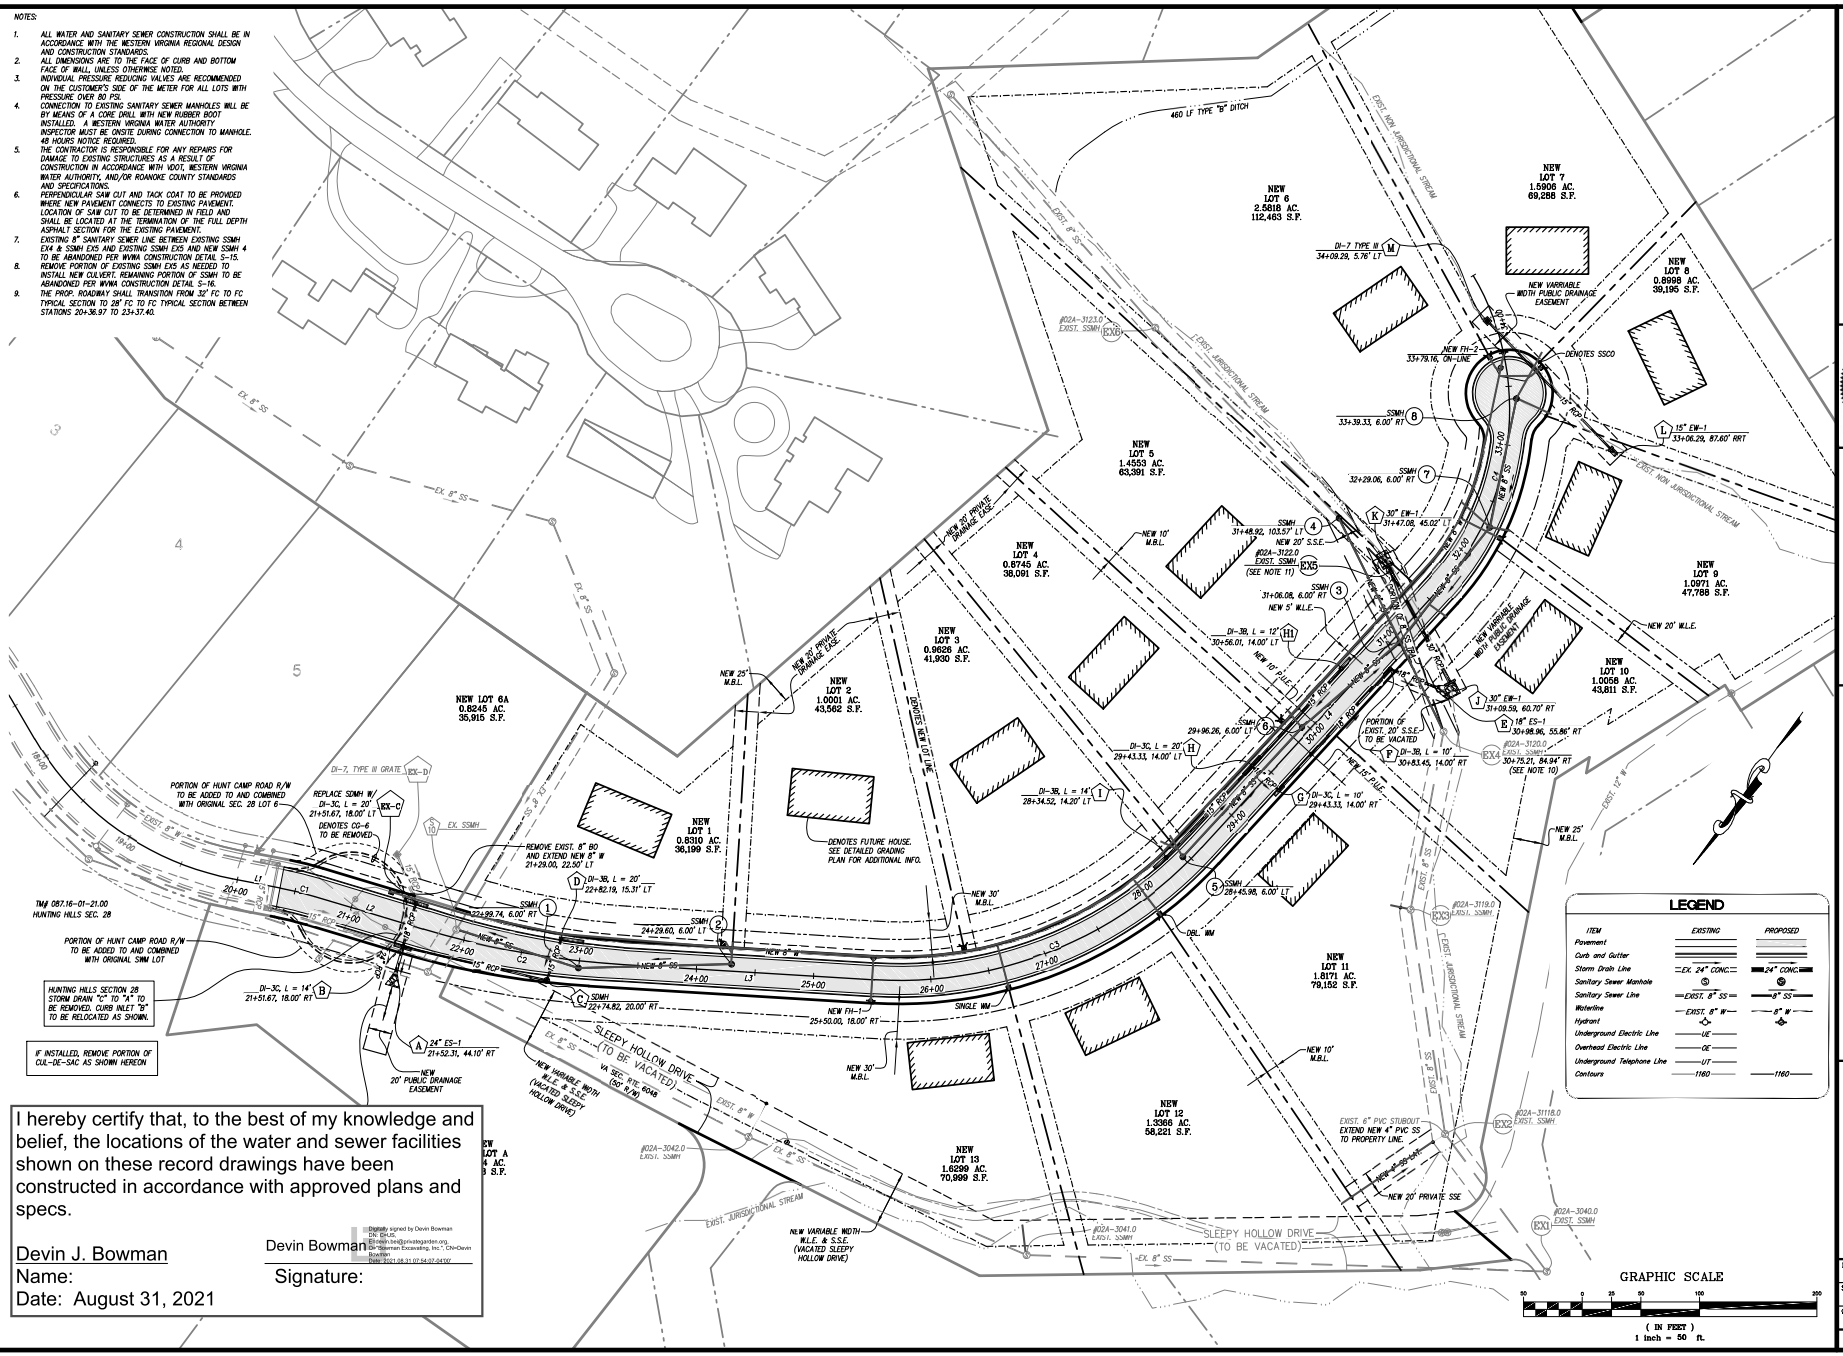

I hereby certify that, to the best of my knowledge and belief, the locations of the water and sewer facilities shown on these record drawings have been constructed in accordance with approved plans and specs.

Devin J. Bowman
Name:
Date: August 31, 2021

Devin Bowman
Signature:

Digitally signed by Devin Bowman
Date: 2021.08.31 07:54:07 -04'00'

Lumsden Associates, P.C.
ENGINEERS | SURVEYORS | PLANNERS
485-B BRAMBLETON AVENUE
P.O. BOX 20669
ROANOKE, VIRGINIA 24018
PHONE (540) 774-4411
FAX (540) 772-9415
WWW.LUMSDENPC.COM

COMMONWEALTH OF VIRGINIA
ANDREW P. LUMSDEN
Lic. No. 052216
4/27/20
PROFESSIONAL ENGINEER

DIMENSIONAL LAYOUT

DEVELOPMENT PLAN
FOR
HUNTING HILLS, SECTION 29
PREPARED FOR
OLD HERITAGE CORPORATION
CAVE SPRING MAGISTERIAL DISTRICT
ROANOKE COUNTY, VIRGINIA

NO.	DATE	REVISIONS DESCRIPTION
1		
2		
3		
4		
5		

DATE: April 27, 2020
SCALE: 1" = 50'
COMMISSION NO. 16-186
SHEET 4 OF 11

APPROVED, 4/30/2020